

PLAT OF SURVEY


PATHFINDER SURVEYING
FORMERLY KOLB LAND CONSULTING
929 WILLIAMS STREET LAKE GENEVA, WI. 53147
(414) 248-3697

ORDERED BY: CENTURY 21 ZENK REALTY LLC
804 N. WISCONSIN
ELKHORN, WI. 53121

DATE: 3-10-1999

DESCRIPTION: LOT 7 OF MARINER HILLS SUBDIVISION,
LOCATED IN SECTION 34, TOWN 4 NORTH,
RANGE 16 EAST, TOWN OF LA GRANGE,
COUNTY OF WALWORTH, STATE OF WISCONSIN.

- LEGEND
- FOUND IRON PIN
 - SET IRON PIPE
 - X— FENCE
 - VENT
 - WELL
 - ▣ TELEPHONE PEDASTAL
 - (XXX) RECORDED AS

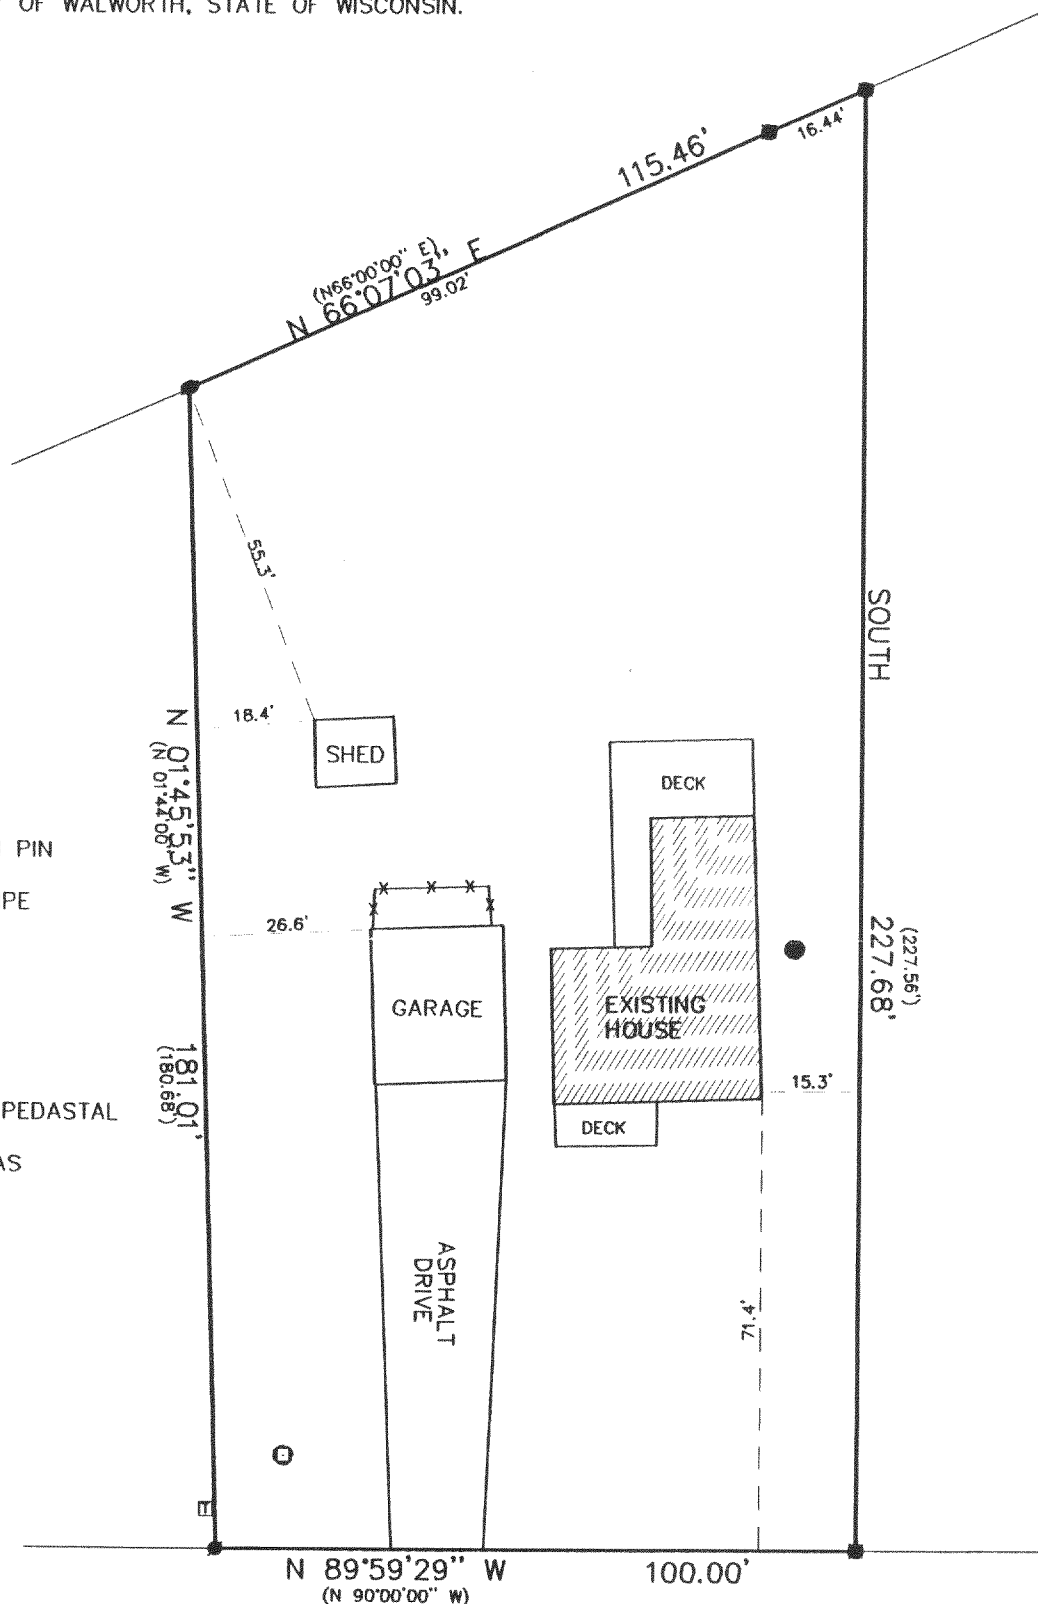



SCALE 1"=30'
BEARINGS REFERENCED
TO RECORD PLAT OF
MARINER HILLS SUB.

C.L. MARINER HILLS CIRCLE (66') WIDE

THE ABOVE MAP IS A TRUE REPRESENTATION THEREOF AND
SHOWS THE SIZE AND LOCATION OF ALL THE PROPERTY,
EXTERIOR BOUNDARIES, THE LOCATION OF ALL VISIBLE
BOUNDARY FENCES, APPARENT EASEMENTS, ROADWAYS
AND VISIBLE ENCROACHMENTS, IF ANY

THIS SURVEY IS MADE FOR THE USE OF THE PRESENT
OWNERS OF THE PROPERTY, AND ALSO THOSE WHO
PURCHASE, MORTGAGE OR GUARANTEE TITLE THERETO
WITHIN ONE (1) YEAR FROM DATE HERETO.

JOHN P. KROTT, R.L.S. 2258

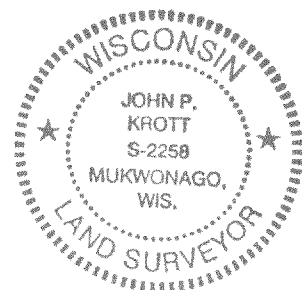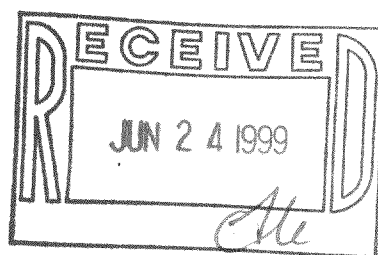

NOTE: THIS IS NOT A CERTIFIED COPY
UNLESS SEAL IS IN RED.
JOB NUMBER 99043 4-16 HMH00007

AMH-7
416-1491