


**ABELL
SURVEYING & MAPPING
DELAN, WISCONSIN 53115
414-728-6757**

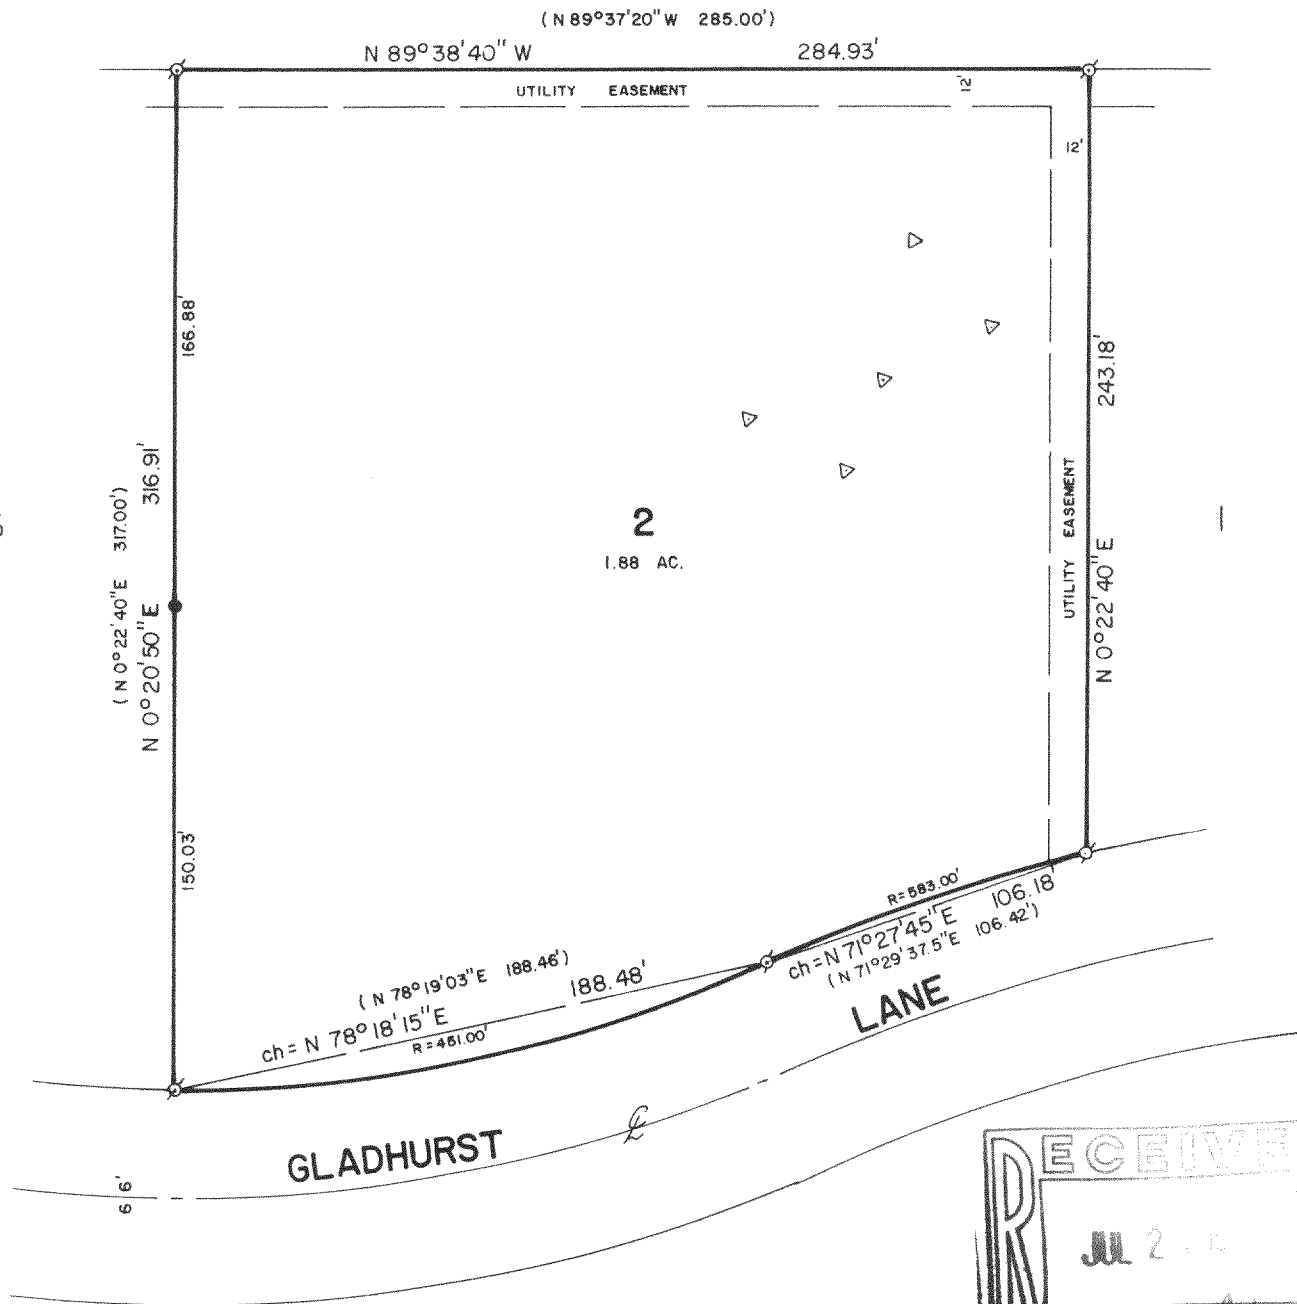

PLAT OF SURVEY OF

LOT 2 OF GLADHURST SUBDIVISION, LOCATED IN T4N,R16E,
WALWORTH COUNTY, WISCONSIN.

ORDERED BY: ERA LANHAM REALTY
20 S. WASHINGTON ST.
JUL 7, 1999 ELKHORN, WI. 53121

RECERTIFIED: APRIL 7, 1999
ORDERED BY: DALE CARLSON
P.O. BOX 675
FRISCO, COLORADO
80443

NOTE: THE BEARING ON THE EAST LINE OF LOT 2 OF GLADHURST
SUBDIVISION IS ASSUMED AS SHOWN ON THE SUBDIVISION
PLAT.



SCALE - 1"=60'

LEGEND

- ✕ - IRON PIPE FOUND
 ● - IRON ROD FOUND
 △ - SOIL BORINGS
 () - RECORDED AS

I HEREBY CERTIFY THAT I HAVE SURVEYED THE ABOVE DESCRIBED PROPERTY AND THAT THE ABOVE MAP IS A TRUE REPRESENTATION THEREOF AND SHOWS THE SIZE AND LOCATION OF THE PROPERTY, ITS EXTERIOR BOUNDARIES, THE LOCATION OF ALL VISIBLE STRUCTURES AND DIMENSIONS OF ALL PRINCIPAL BUILDINGS THEREON, BOUNDARY FENCES, APPARENT EASEMENTS, ROADWAYS AND VISIBLE ENCROACHMENTS, IF ANY, TO THE BEST OF MY KNOWLEDGE AND BELIEF.

THIS SURVEY IS MADE FOR THE USE OF THE PRESENT OWNERS OF THE PROPERTY, AND ALSO THOSE WHO PURCHASE, MORTGAGE, OR GUARANTEE THE TITLE THERETO WITHIN ONE (1) YEAR FROM DATE HEREOF.

David F. Abell

DAVID F. ABELL
WISCONSIN REGISTERED LAND SURVEYOR, S-1596

Sept. 24, 1990 RECERTIFIED: APRIL 7, 1999
DATE JOB NUMBER - 90193
NOTE: THIS IS NOT A CERTIFIED COPY UNLESS SEALED.

HC-2

416-1494