


DUNHAM & RASMUSSEN  
SURVEYING & ENGINEERING  
DELAVER, WISCONSIN

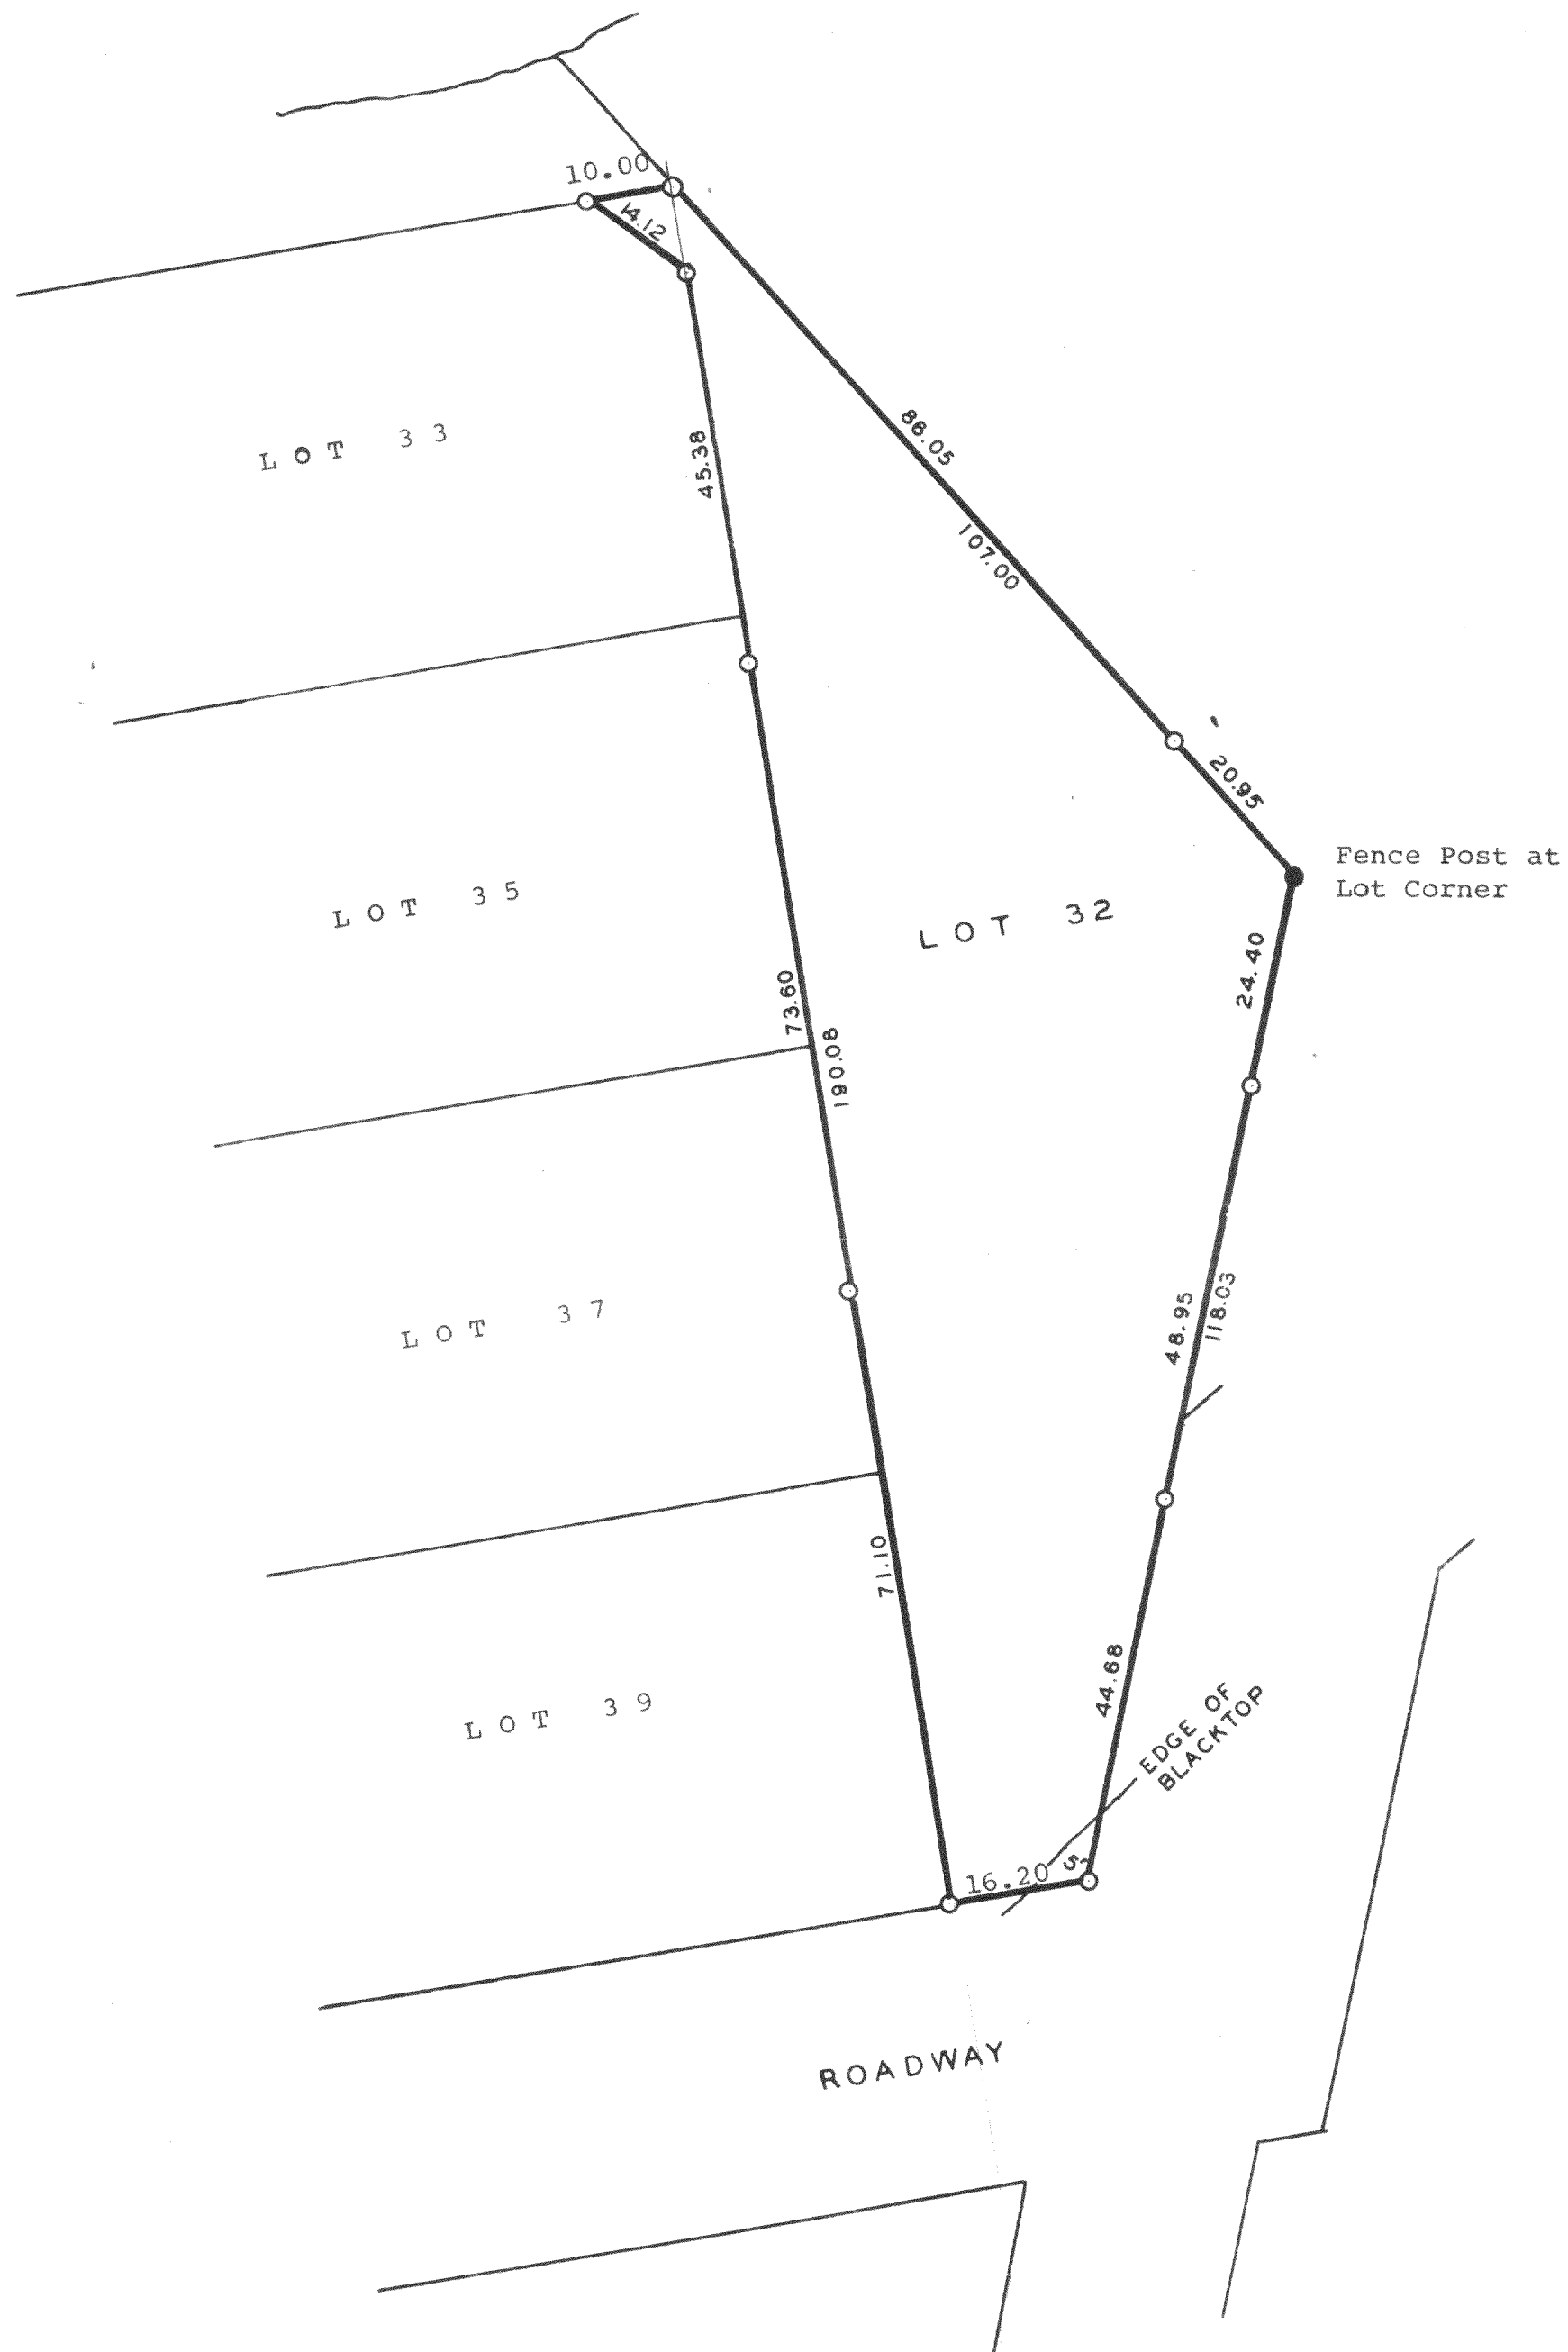

Scale - 1"=20'  
O = Iron Pipe

Plat of survey of Lot 32 of Lauderdale Heights located in the Town of  
LaGrange, Walworth County, Wisconsin  
October 18, 1961

*George T. Dunham*  
George T. Dunham, Surveyor

416-15

HLN-7