


1140 SEQUOIA STREET • DELAVAN, WISCONSIN 53115
414-728-6737

ORDERED BY: KEEFE REAL ESTATE
P.O. BOX 460
LAKE GENEVA, WI 53147

LOT 16, MORRIS PARK, LOCATED IN T4N, R16E,
WALWORTH COUNTY, WISCONSIN.

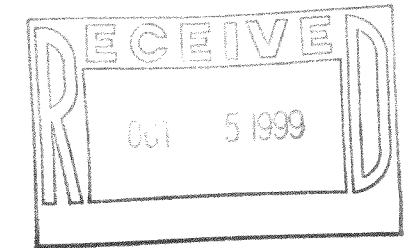

LEGEND

-  - IRON PIPE FOUND
 - IRON PIPE IN CONCRETE FOUND
 - WIRE FENCE
 - UTILITY POLE
 - OVERHEAD UTILITY LINES
 - UTILITY PED.
 () - RECORDED AS

Daniel F. Hall

August 20, 1999

DATE _____ JOB NUMBER - 99137
NOTE: THIS IS NOT A CERTIFIED COPY UNLESS SEALED.