

ABERNATHY and ASSOCIATES**Kenneth B. Abernathy Jr.****Wisconsin Registered Land Surveyor S-1594**

Rt. 3, Box 273

Elkhorn, Wisconsin 53121

Phone: (414) 723-4260 (office)

(414) 723-4813 (residence)

PLAT OF SURVEY**LEGAL DESCRIPTION FOR EASEMENT**VOL. 642 P. 9046 DOC. NO. 337607
SEPTEMBER 4, 1986

The Westerly 5 feet and Southerly 5 feet of Lot 93 of Mariner Hills Subdivision, located in the NW 1/4 of the SW 1/4, the SW 1/4 of the SW 1/4, the SE 1/4 of the SW 1/4, and the SW 1/4 of the SE 1/4 of Section 34, Township 4 North, Range 16 East in the Town of La Grange, Walworth County, Wisconsin.

OWNERS: MARINER HILLS PROPERTY OWNERS ASSN.**C/O ROBERT W. LIND
346 HAZELWOOD TERRACE
BUFFALO GROVE, IL. 60089-1822****MARINER HILLS DR.**

fd. iron pipe

80.00'
79.51'35.00'
35.00'EDGE OF BLACKTOP
DRIVEWAY ENCROACHES
4.87' AT MOST

LOT 94

LOT 92

(REC. AS 392.29')
N 11°48'00" E 392.59'

S 11°48'00" W 385.90'

LOT 93

**5' WIDE
WALKWAY EASEMENT**set spikes on property
line and easement line.

182.59'

176.39'

UTILITY PEDESTAL
POWER POLEfd. 3/4" dia.
iron rod

LOT 66

ASSOCIATION PROPERTY

Legend

- FOUND IRON PIPE
- FOUND IRON ROD
- FOUND BRASS CAPPED MONUMENT
- FOUND CONCRETE MONUMENT
- CHISEL CUT IN CONCRETE
- SET IRON ROD, 24" LONG, WEIGHING
1.5 LBS./LINEAL FT., 3/4" DIA.
- SET IRON ROD, 30" LONG, WEIGHING
4.5 LBS./LINEAL FT., 1-11/16" DIA.

(xx) RECORDED AS DIMENSION

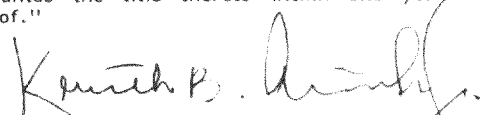
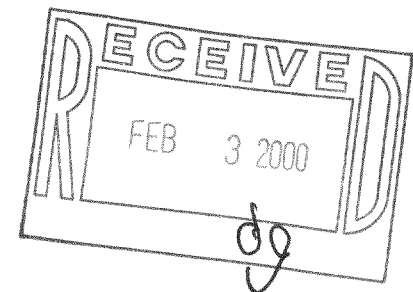
-x-x- EXISTING FENCE

119.61'
N 89°21'47" E
(REC. AS N 89°26'05" W 122.00')
S 89°21'47" W 121.73'fd. spike on 5' offset
but 3.17' E. of lot line

SCALE: 1" = 50 FEET

"I hereby certify that I have surveyed the above described property and that the above map is a true representation thereof and shows the size and location of the property, its exterior boundaries, the location of all visible structures and dimensions of all principal buildings thereon, boundary fences, apparent easements, roadways and visible encroachments, if any."

"This survey is made for the use of the present owners of the property, and also those who purchase, mortgage, or guarantee the title thereto within one year from date hereof."

**KENNETH B. ABERNATHY, JR.
WISCONSIN REGISTERED LAND SURVEYOR,
S-1594**Date: SEPT. 1, 1999Job No. 99.809

416-1544

HMH 9/30