

ABERNATHY and ASSOCIATES


Kenneth B. Abernathy Jr.

Wisconsin Registered Land Surveyor S-1594

Rt. 3, Box 273
Elkhorn, Wisconsin 53121
Phone: (414) 723-4260 (office)
(414) 723-7209 (FAX)

PLAT OF SURVEY


LOT 56 OF MARINER HILLS SUBDIVISION, LOCATED IN
THE SOUTHWEST 1/4 OF SECTION 34, TOWN 4 NORTH,
RANGE 16 EAST, LAGRANGE TOWNSHIP, WALWORTH COUNTY,
WISCONSIN.

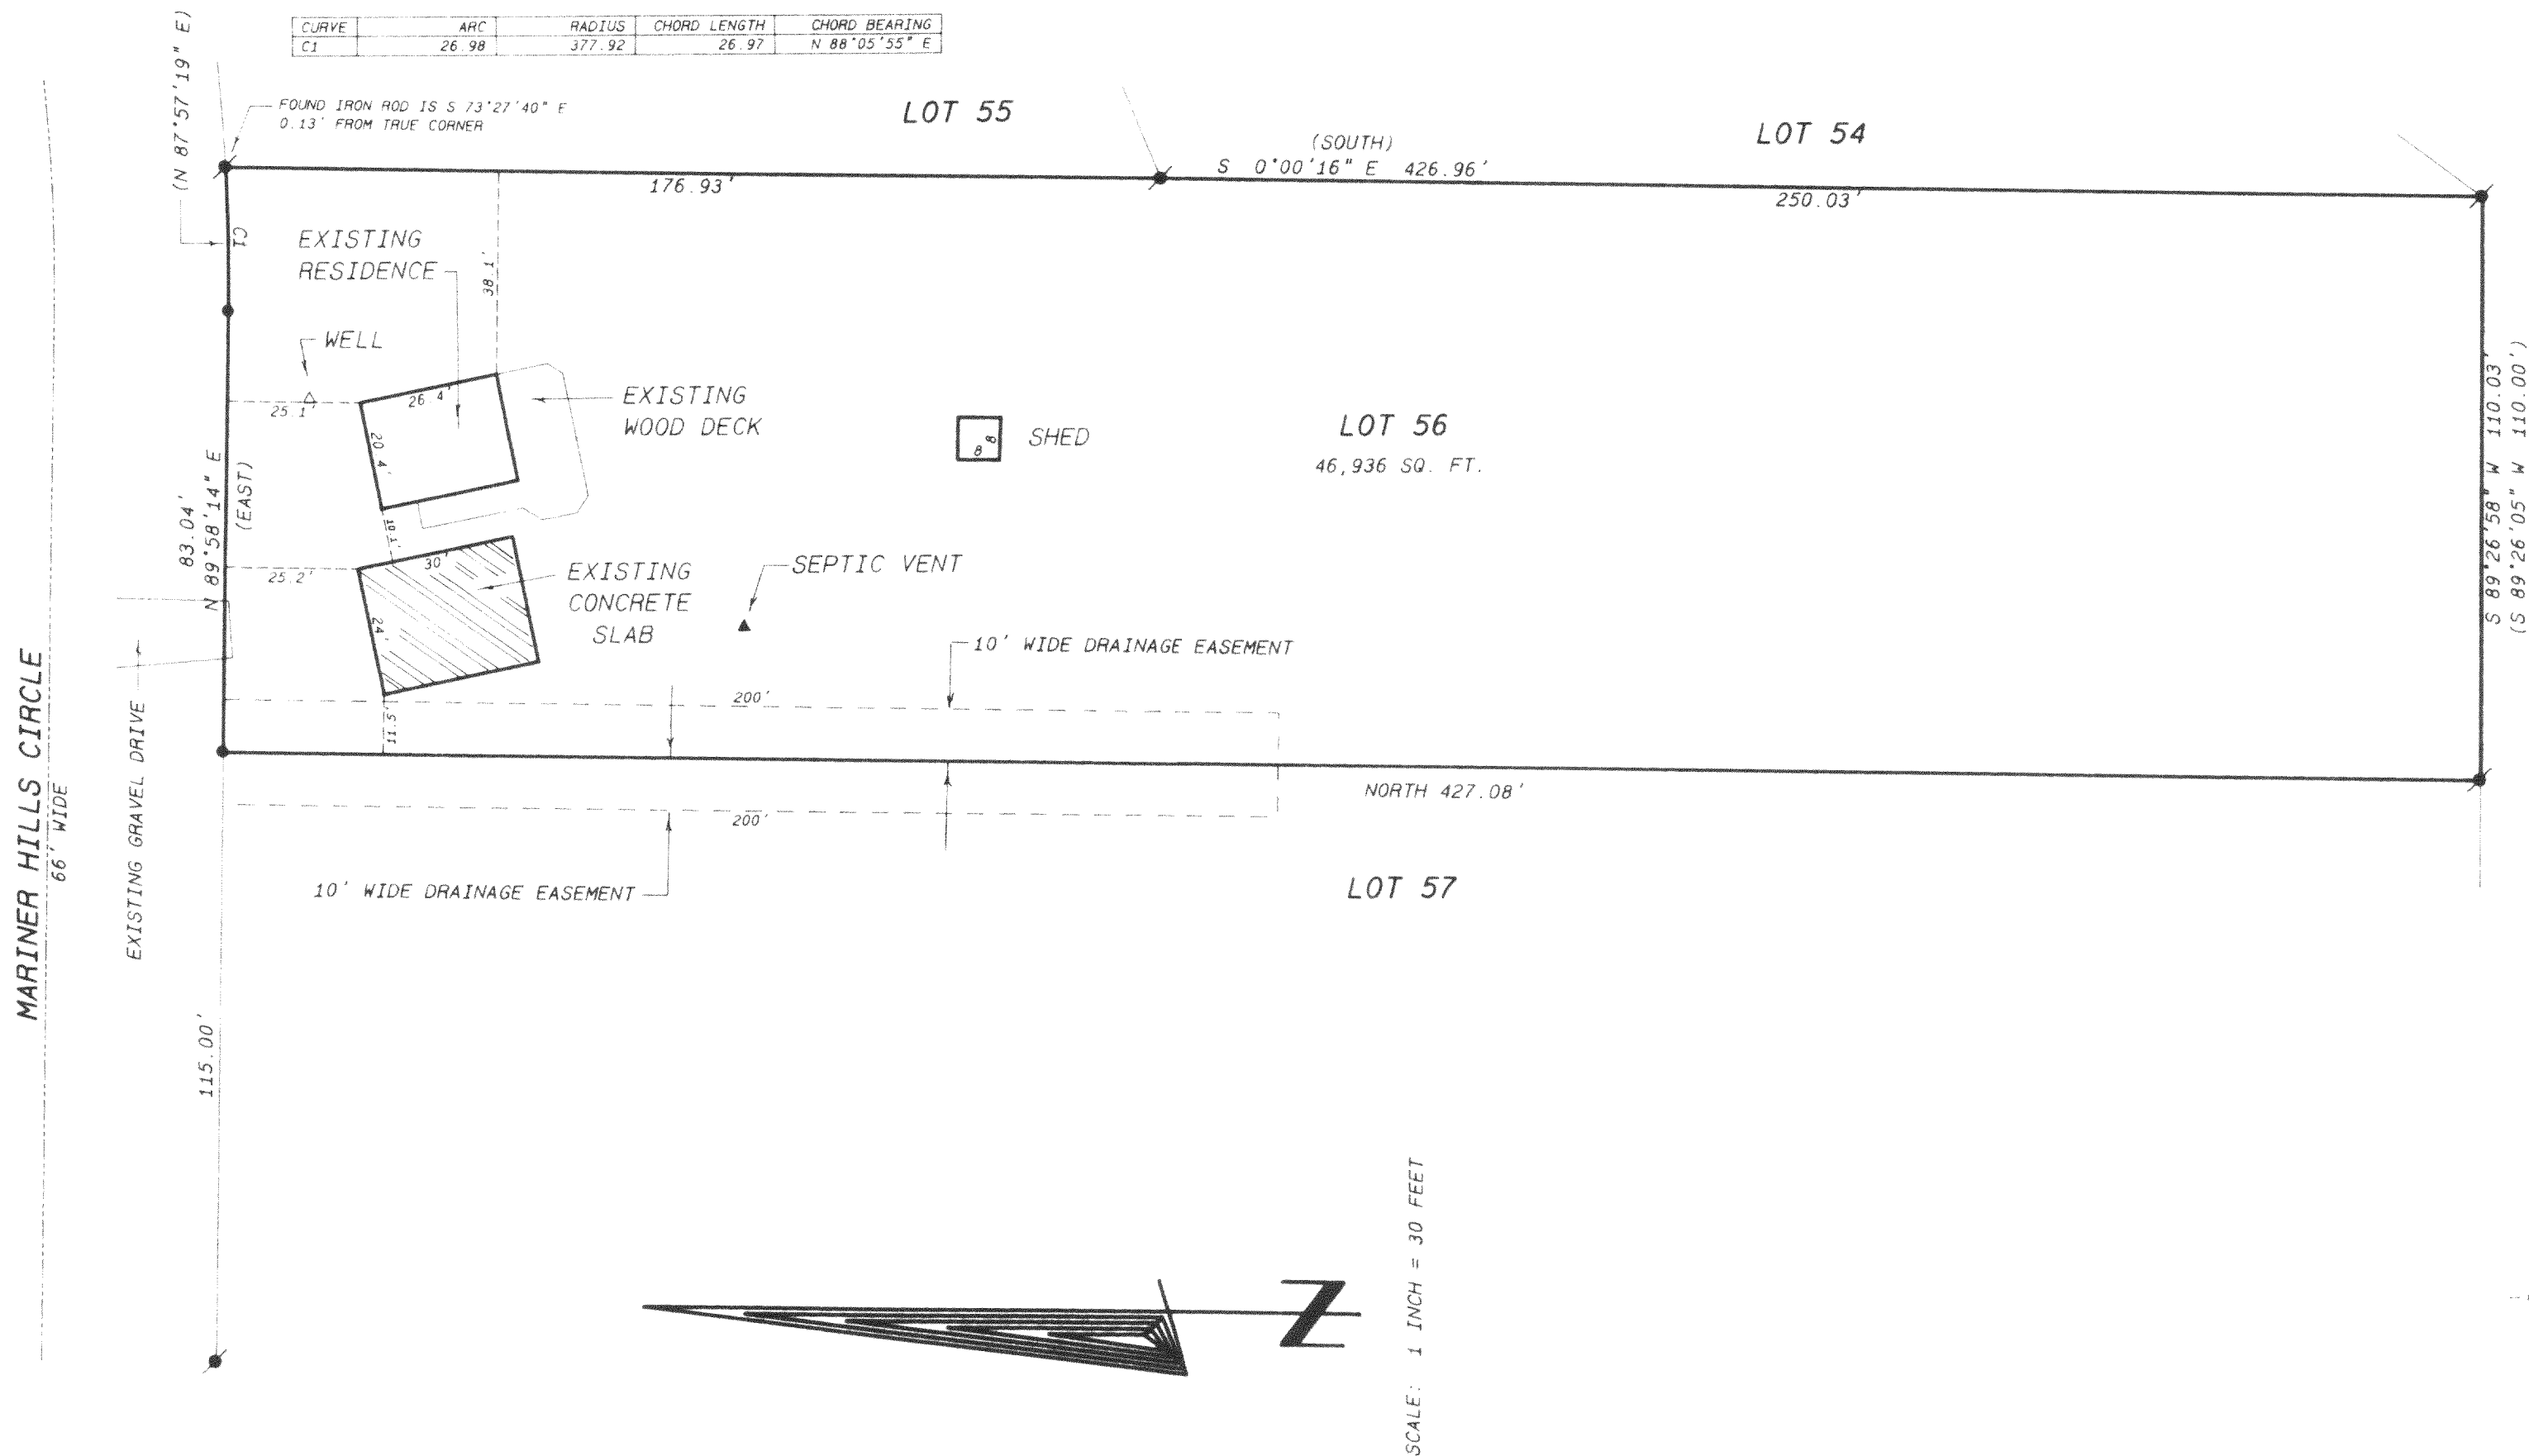


OWNERS: DONNIE & JESSICA BEARD
N7369 MARINER HILLS CIRCLE
ELKHORN, WI. 53121

Legend

- FOUND IRON PIPE
- FOUND IRON ROD
- FOUND BRASS CAPPED MONUMENT
- FOUND CONCRETE MONUMENT
- CHISEL CUT IN CONCRETE
- SET IRON ROD, 24" LONG, WEIGHING 1.5 LBS., LINEAL FT. 3.4" DIA.
- SET IRON ROD, 10" LONG, WEIGHING 4.5 LBS., LINEAL FT. 1.11 16" DIA.
- RECORDED AS DIMENSION
- EXISTING FENCE

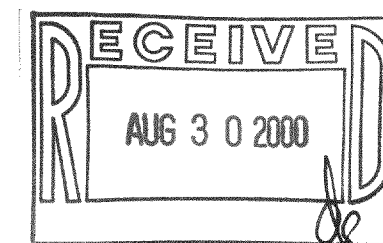

SCALE: 1" = 30 FEET

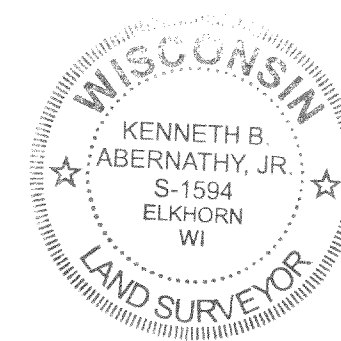

REVISED JAN. 5, 2000
REVISED MARCH 29, 2000

I hereby certify that the above described property has been surveyed by me, and the location and that the above map is a true representation thereof and shows the size and location of the property, its exterior boundaries, the location of all structures and dimensions of all principal buildings, the iron, concrete, fences, apparent easements, and other encroachments, if any.

This survey is made for the use of the record owners of the property and those who claim their right to the title thereto within the year from date hereof.

Kenneth B. Abernathy, Jr.
KENNETH B. ABERNATHY, JR.
WISCONSIN REGISTERED LAND SURVEYOR,
S-1594

Date: 9-23-99 Job No. 99-909

HMH-56 416-1614