

ABERNATHY and ASSOCIATES

Kenneth B. Abernathy Jr.



Wisconsin Registered Land Surveyor S-1594

W4056 BRAY RD.
ELKHORN, WI. 53121
PHONE: (262) 723-4260 (OFFICE)
(262) 723-7209 (FAX)
Email: abernathy@elknet.net

PLAT OF SURVEY

LOT 1 OF CERTIFIED SURVEY MAP NO. 1777 AS RECORDED
IN VOLUME 8 OF CERTIFIED SURVEY MAPS AS PAGES 224
AND 225 AS DOCUMENT NO. 173243, LOCATED IN THE
SOUTHEAST 1/4 OF SECTION 31, TOWN 4 NORTH, RANGE
16 EAST, WALWORTH COUNTY, WISCONSIN.

OWNERS: JOHN W. AND CHRISTINE S. MEDDAUGH
N 738 COUNTY TRUNK "O"
ELKHORN, WI. 53121

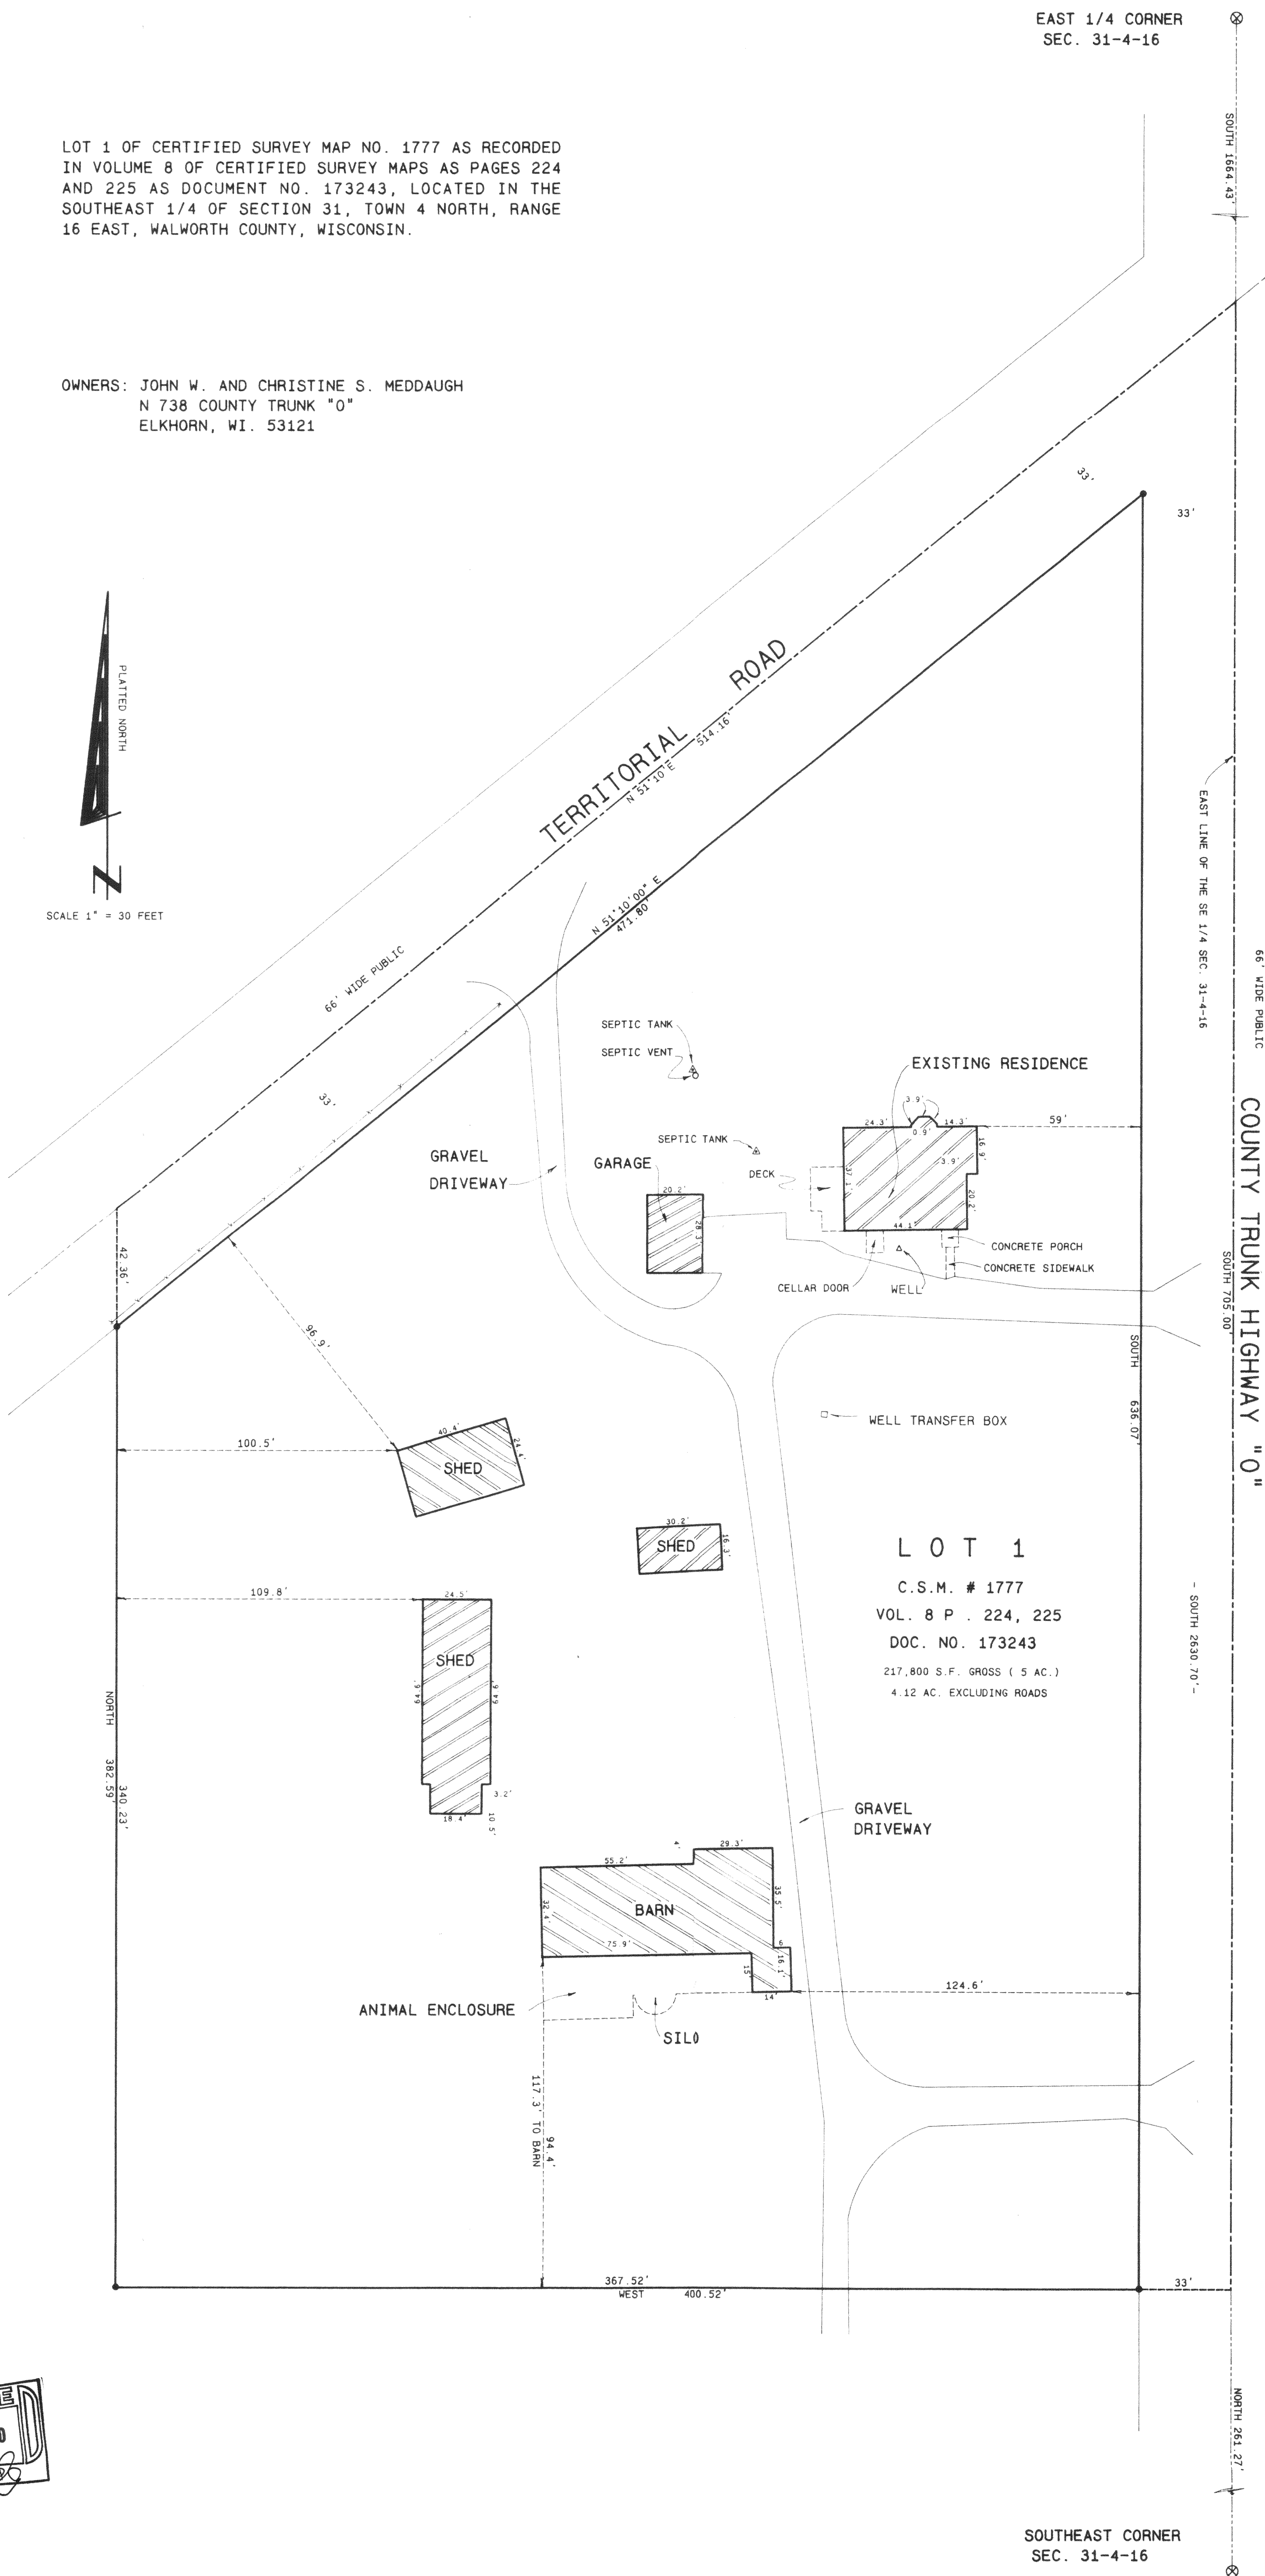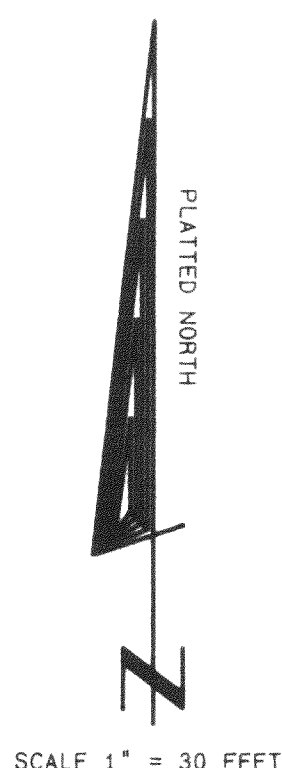


LOT 1

C.S.M. # 1777
VOL. 8 P. 224, 225
DOC. NO. 173243
217,800 S.F. GROSS (5 AC.)
4.12 AC. EXCLUDING ROADS

Legend

- FOUND IRON PIPE
- FOUND IRON ROD
- FOUND BRASS CAPPED MONUMENT
- FOUND CONCRETE MONUMENT
- CHISEL CUT IN CONCRETE
- SET IRON ROD, 24" LONG, WEIGHING 1.5 LBS./LINEAL FT., 3/8" DIA.
- SET IRON ROD, 36" LONG, WEIGHING 4.5 LBS./LINEAL FT., 1-11/16" DIA.
- RECORDED AS DIMENSION
- EXISTING FENCE

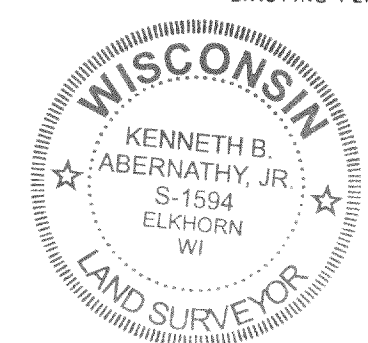

SCALE: 1"= 30 FEET

I hereby certify that the above described property has been surveyed by me or under my direction and that the above map is a true representation thereof and shows the size and location of the property, its exterior boundaries, the location of all visible structures and dimensions of all principal buildings thereon, boundary fences, apparent easements, roadways and visible encroachments, if any.
This survey is made for the use of the present owners of the property, and also those who purchase, mortgage, or guarantee the title thereto within one year from date hereof.

Kenneth B. Abernathy, Jr.
WISCONSIN REGISTERED LAND SURVEYOR,
S-1594

Date: 7/24/2000 Job No. 00411



HA-1777-1

416-1617

5/1/00