


PLAT OF SURVEY

OF A PARCEL OF LAND
LOCATED IN BLOCK 1 OF
CARSWELLS PARK IN
SECTIONS 35 & 36,
T4N R16E, WALWORTH
COUNTY, WISCONSIN.

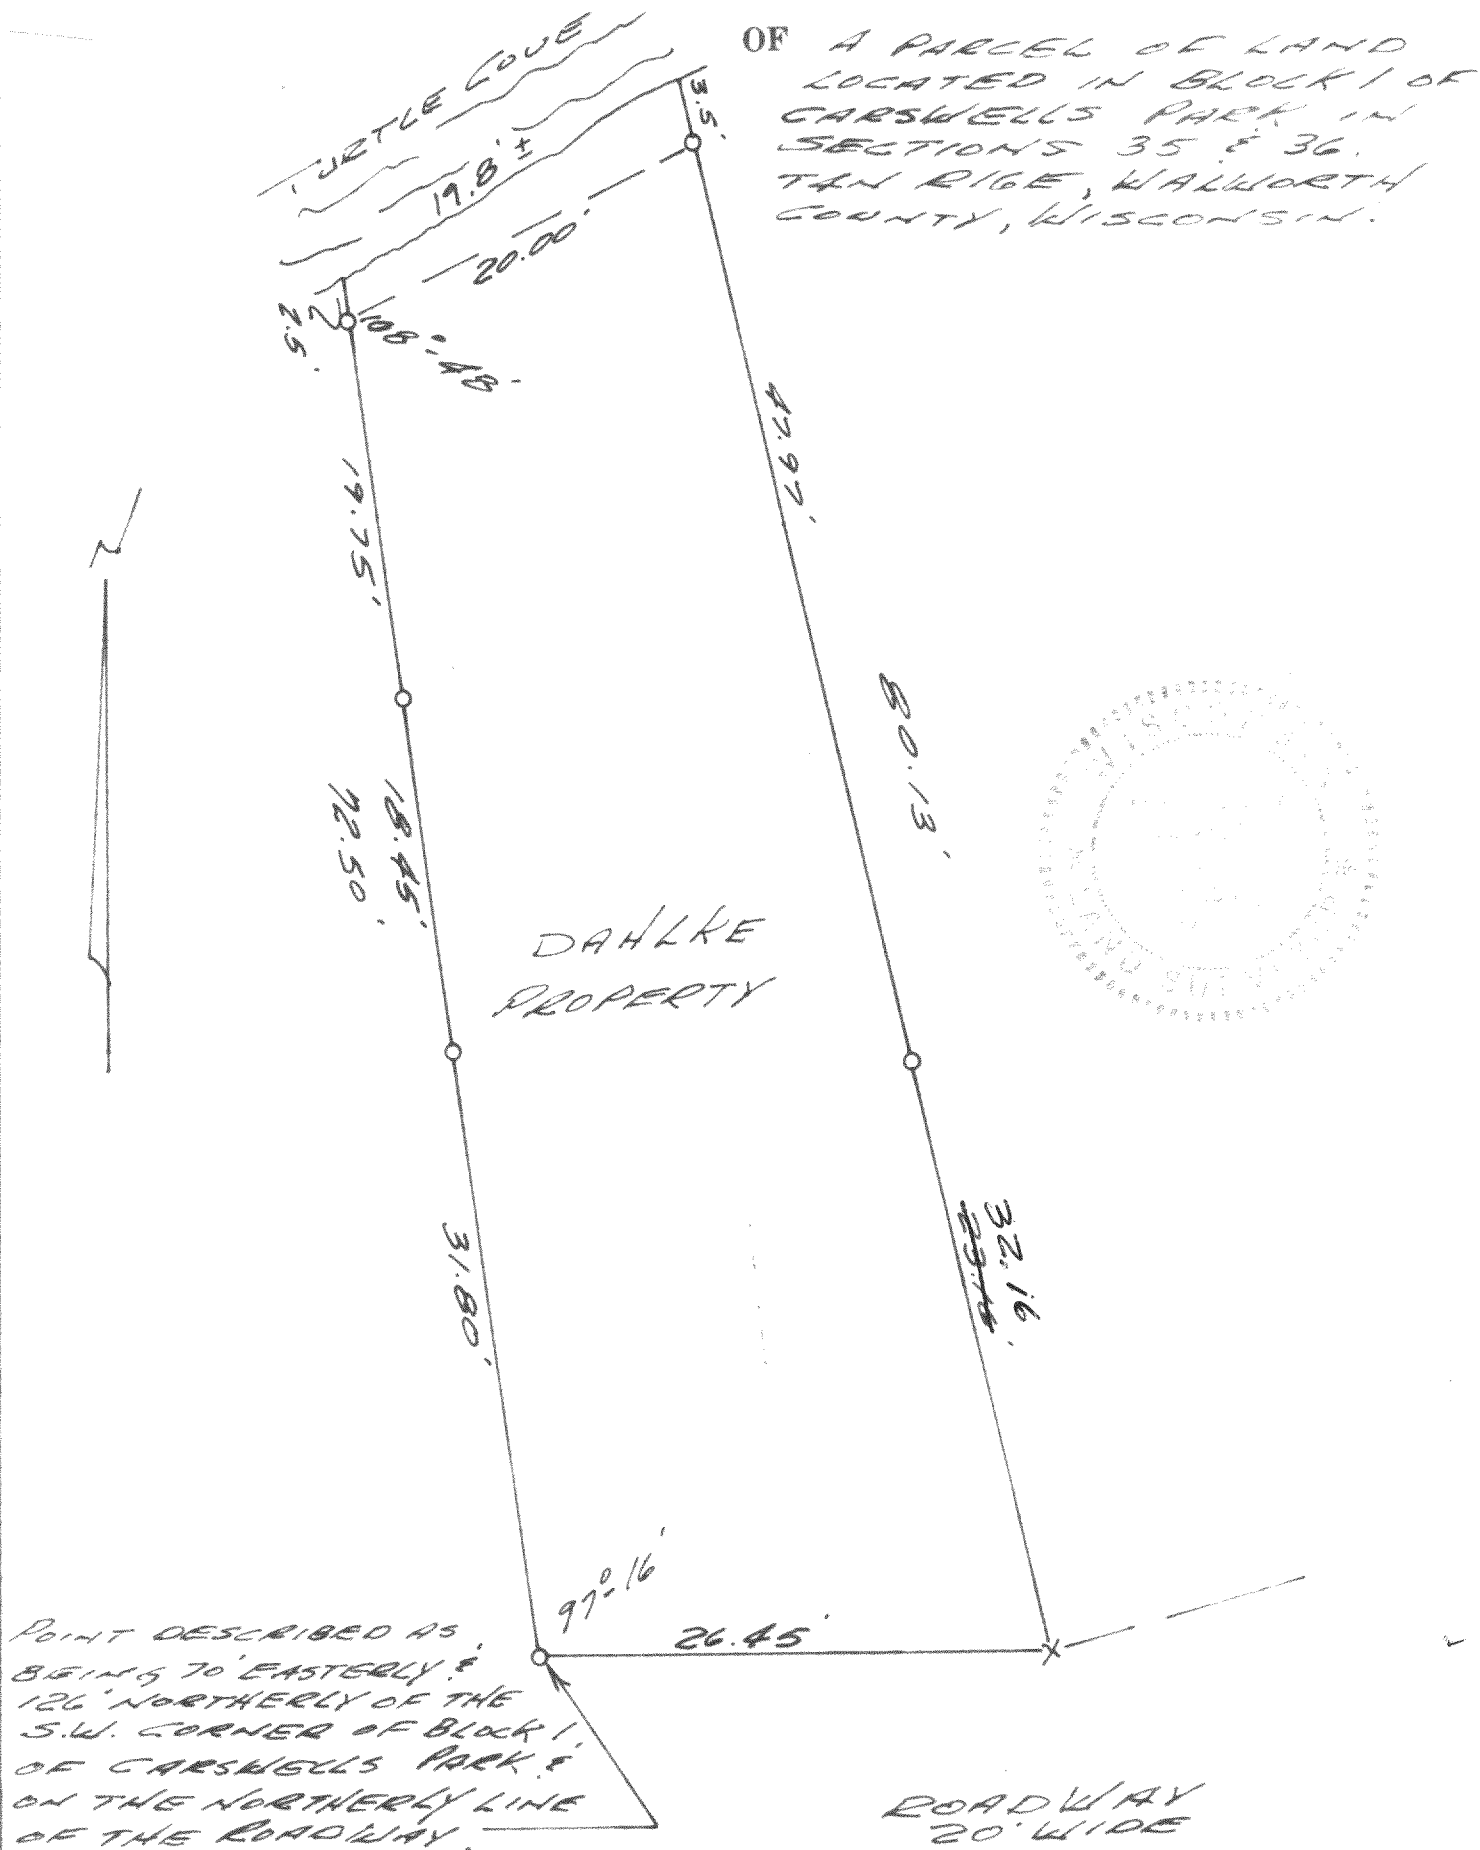

POINT DESCRIBED AS
BEING 70' EASTERLY &
126' NORTHERLY OF THE
S.W. CORNER OF BLOCK 1
OF CARSWELLS PARK &
ON THE NORTHERLY LINE
OF THE ROADWAY.

ROADWAY
20' WIDE

SURVEY AND PLAT BY

JENSEN & JOHNSON, INC.
CIVIL ENGINEERS AND SURVEYORS

Elkhorn, Wisconsin

LEGEND

- — Iron Pipe FOUND
- — Concrete Monument

Scale 1" = 10'

x — SPIKE FOUND

WE CERTIFY: That we have surveyed the above described property and that the plat shown hereon is an accurate survey and a true representation thereof and correctly shows the exterior boundary lines and all divisions of said property.

Date MAY 25, 1973

Shomua P. A. Jensen

Wisconsin Registered Land Surveyor, [REDACTED]

416-162