
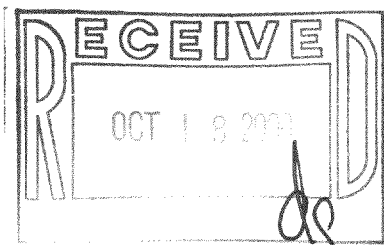


# PLAT OF SURVEY

- OF -

J.K. SURVEYING  
JEFFREY L. KIMPS R.L.S.  
7561 336TH AVE  
BURLINGTON WI. 53105  
262-537-4274

LOT 43 MARINER HILLS, A SUBDIVISION LOCATED IN SECTION 34, TOWN 4 NORTH, RANGE 16 EAST, TOWN OF  
LAGRANGE, WALWORTH COUNTY, WISCONSIN.

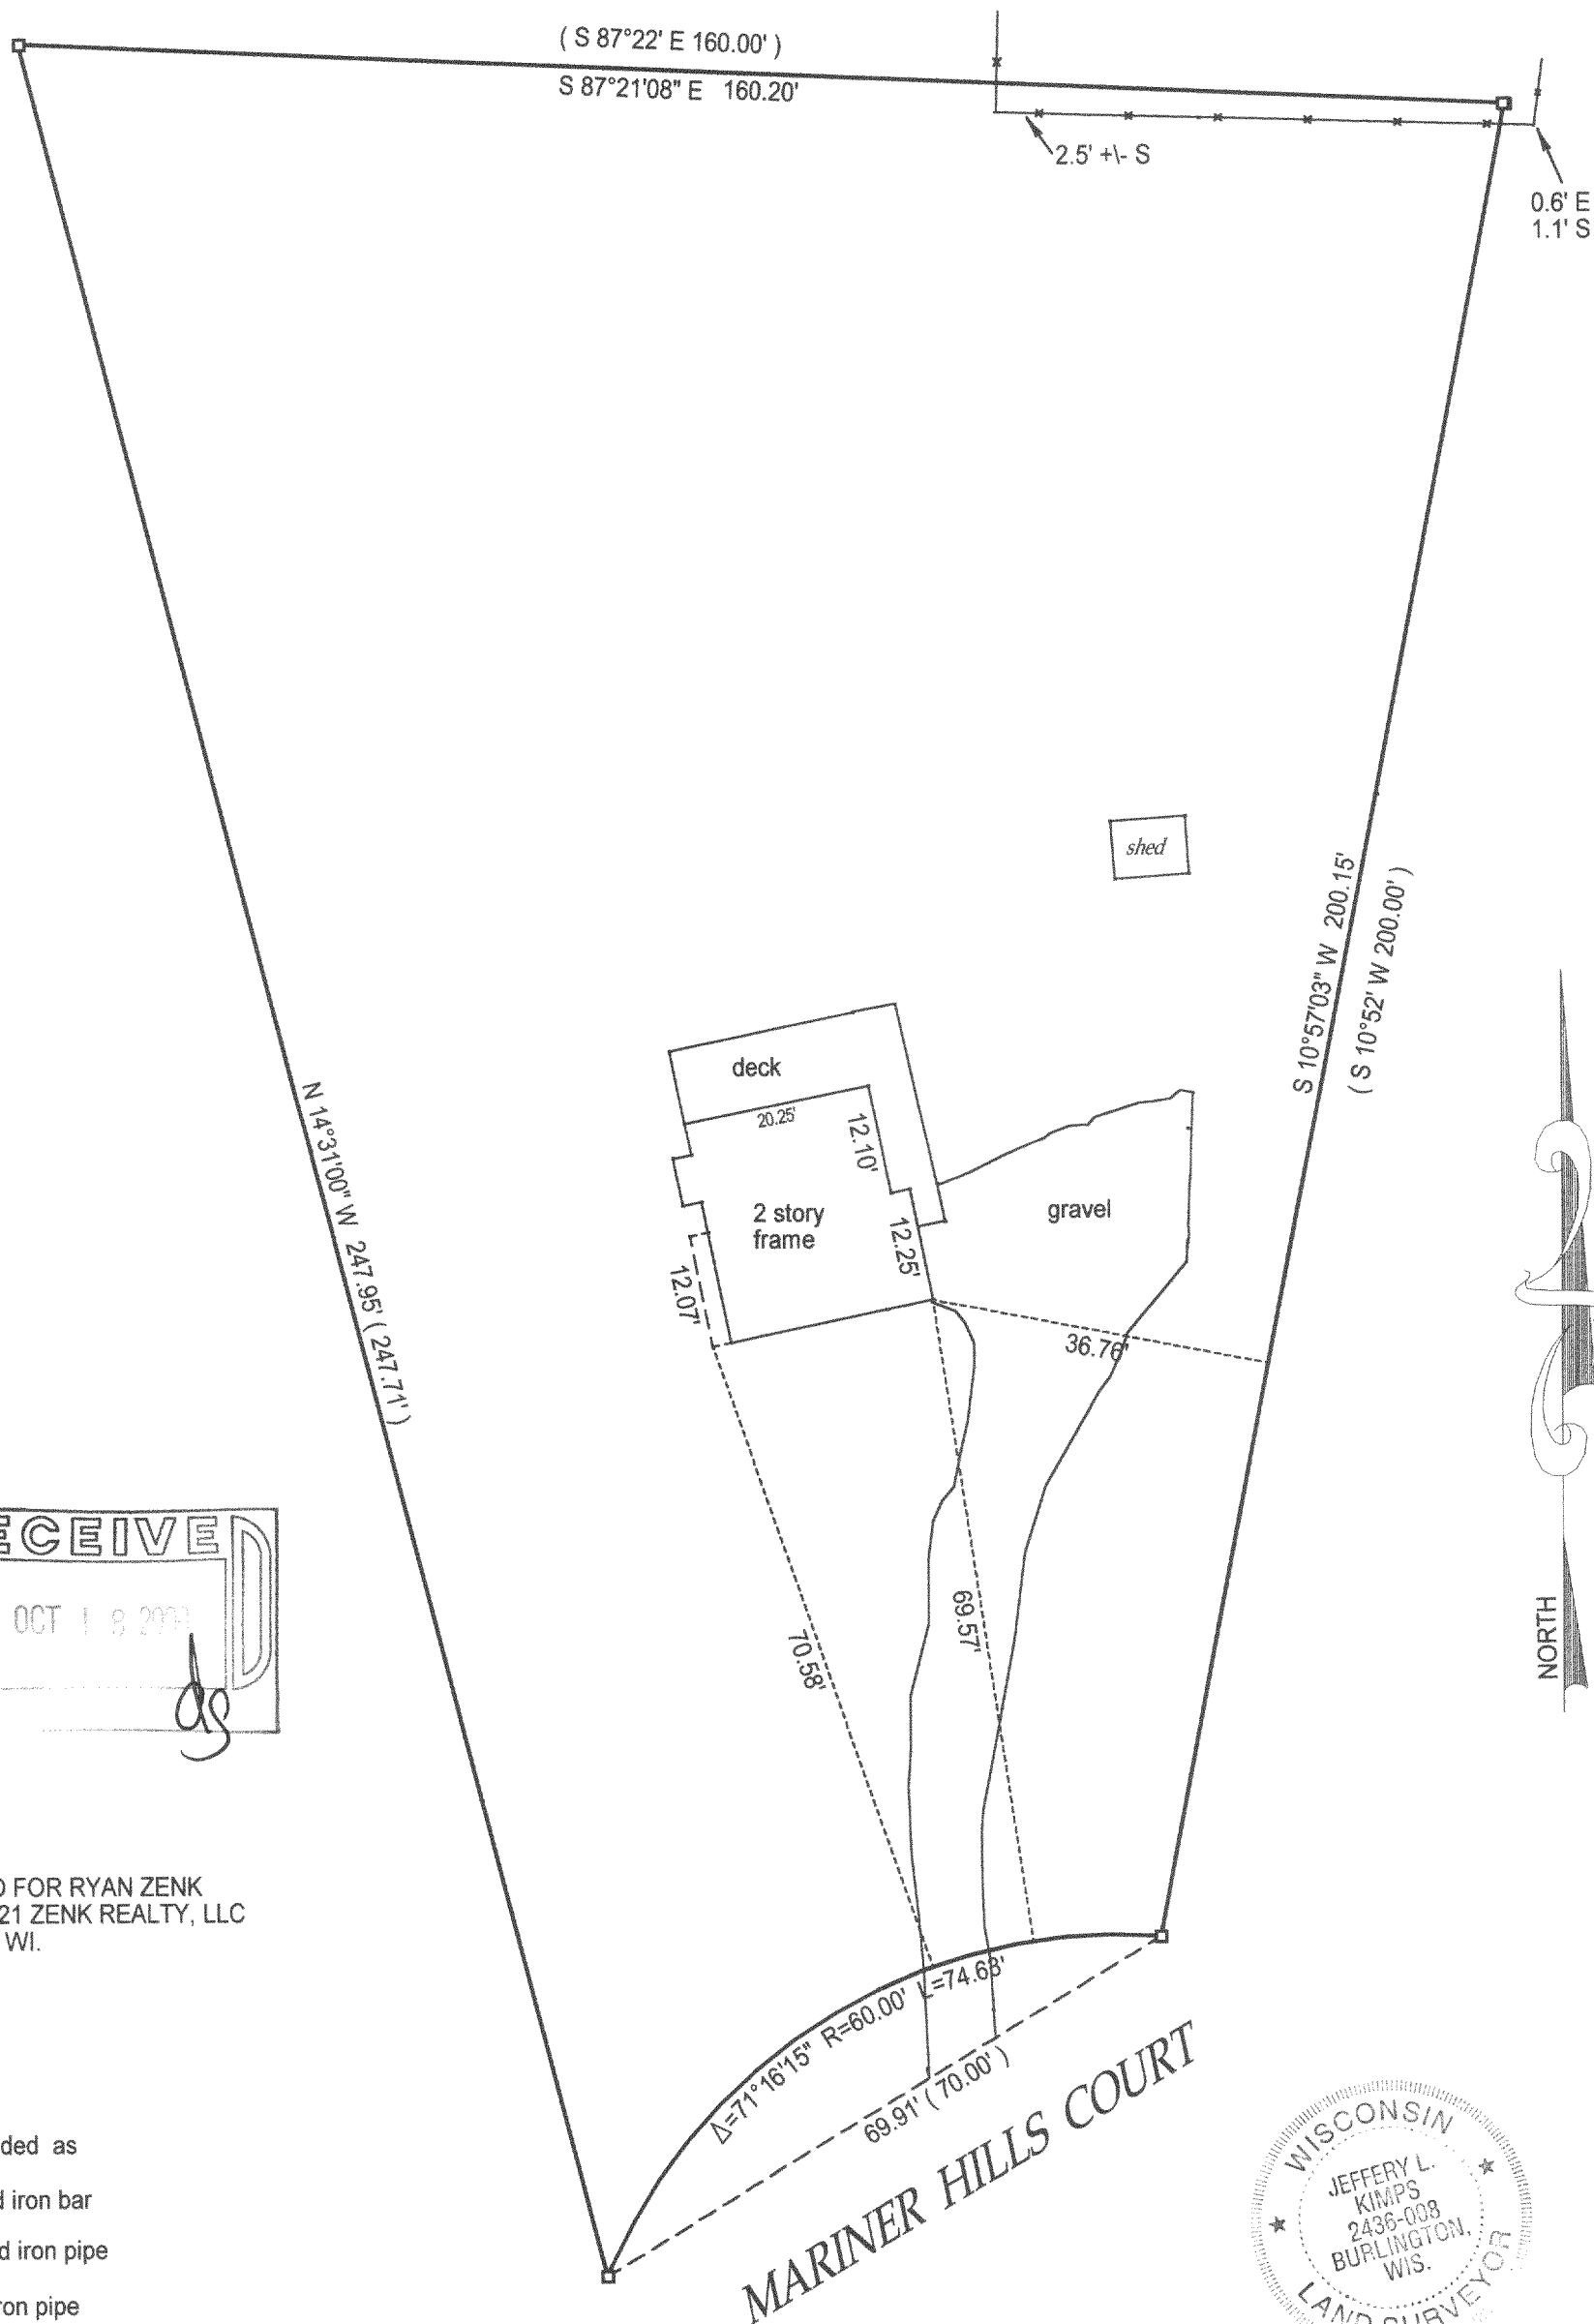

PREPARED FOR RYAN ZENK  
CENTURY 21 ZENK REALTY, LLC  
ELKHORN, WI.

( ) = recorded as

□ = found iron bar

○ = found iron pipe

● = set iron pipe

■ = set iron bar

SCALE 1" = 20'


JOB # 00-315

TAX ID # HMH00043

"I hereby certify that I have surveyed the above described property and that the above map is a true representation thereof and shows the size and location of all visible structures, apparent easements and encroachments if any."

This survey is made for the present owners of the property, and those who purchase, mortgage, or guarantee the title thereto, within one year from the date hereof.

DATED THIS 30 TH, DAY OF JULY 20 00 .

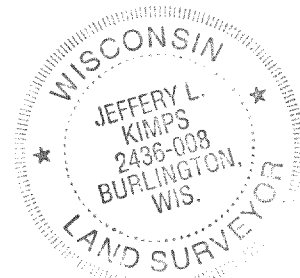

*Jeffrey L. Kimps*  
JEFFREY L. KIMPS S-2436

( original if signed in red )

HMH-43

416-1621