



GEORGE T. DUNHAM
SURVEYING & SUBDIVIDING
DELAVER, WISCONSIN

Extra copy

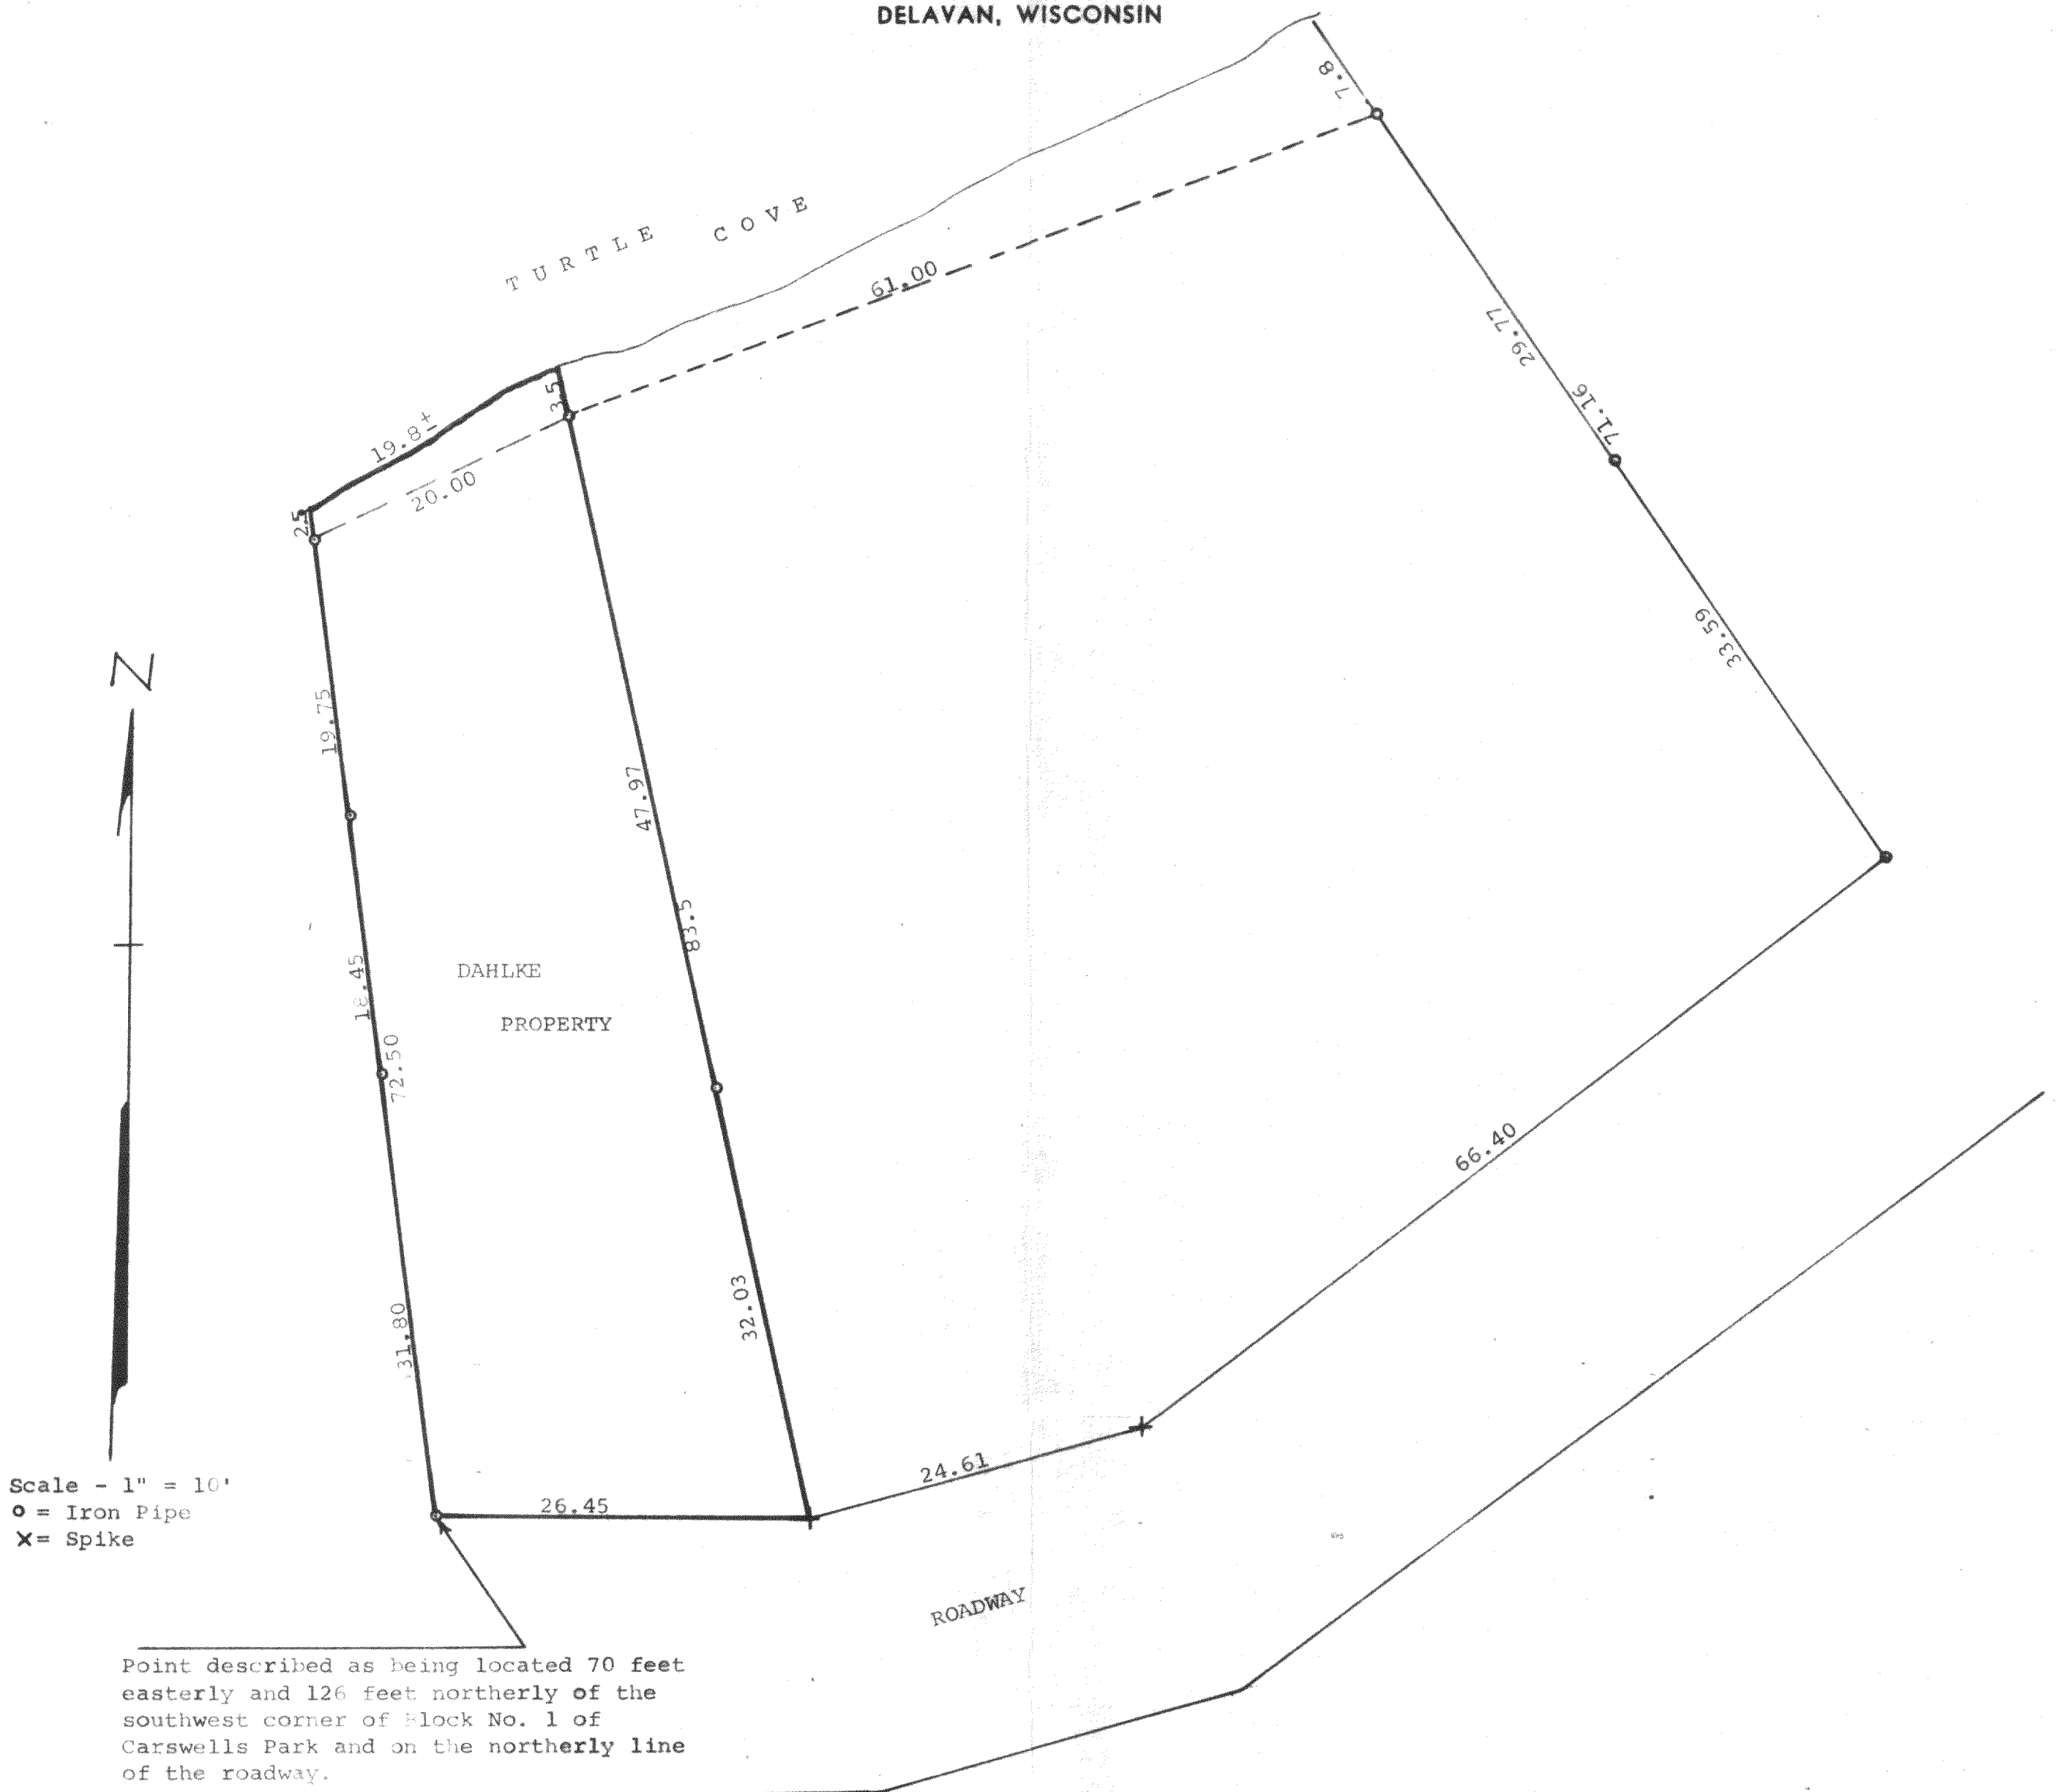

Plat of survey of a parcel of land located in Block 1 of Carswells Park in Sections 35 & 36, T4N, R16E, Walworth County, Wisconsin.
May 11, 1972


George T. Dunham
George T. Dunham, Surveyor

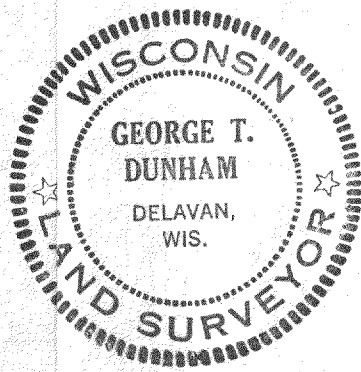

P4 HCA-4

416-121

GEORGE T. DUNHAM
SURVEYING & SUBDIVIDING
DELAVAN, WISCONSIN

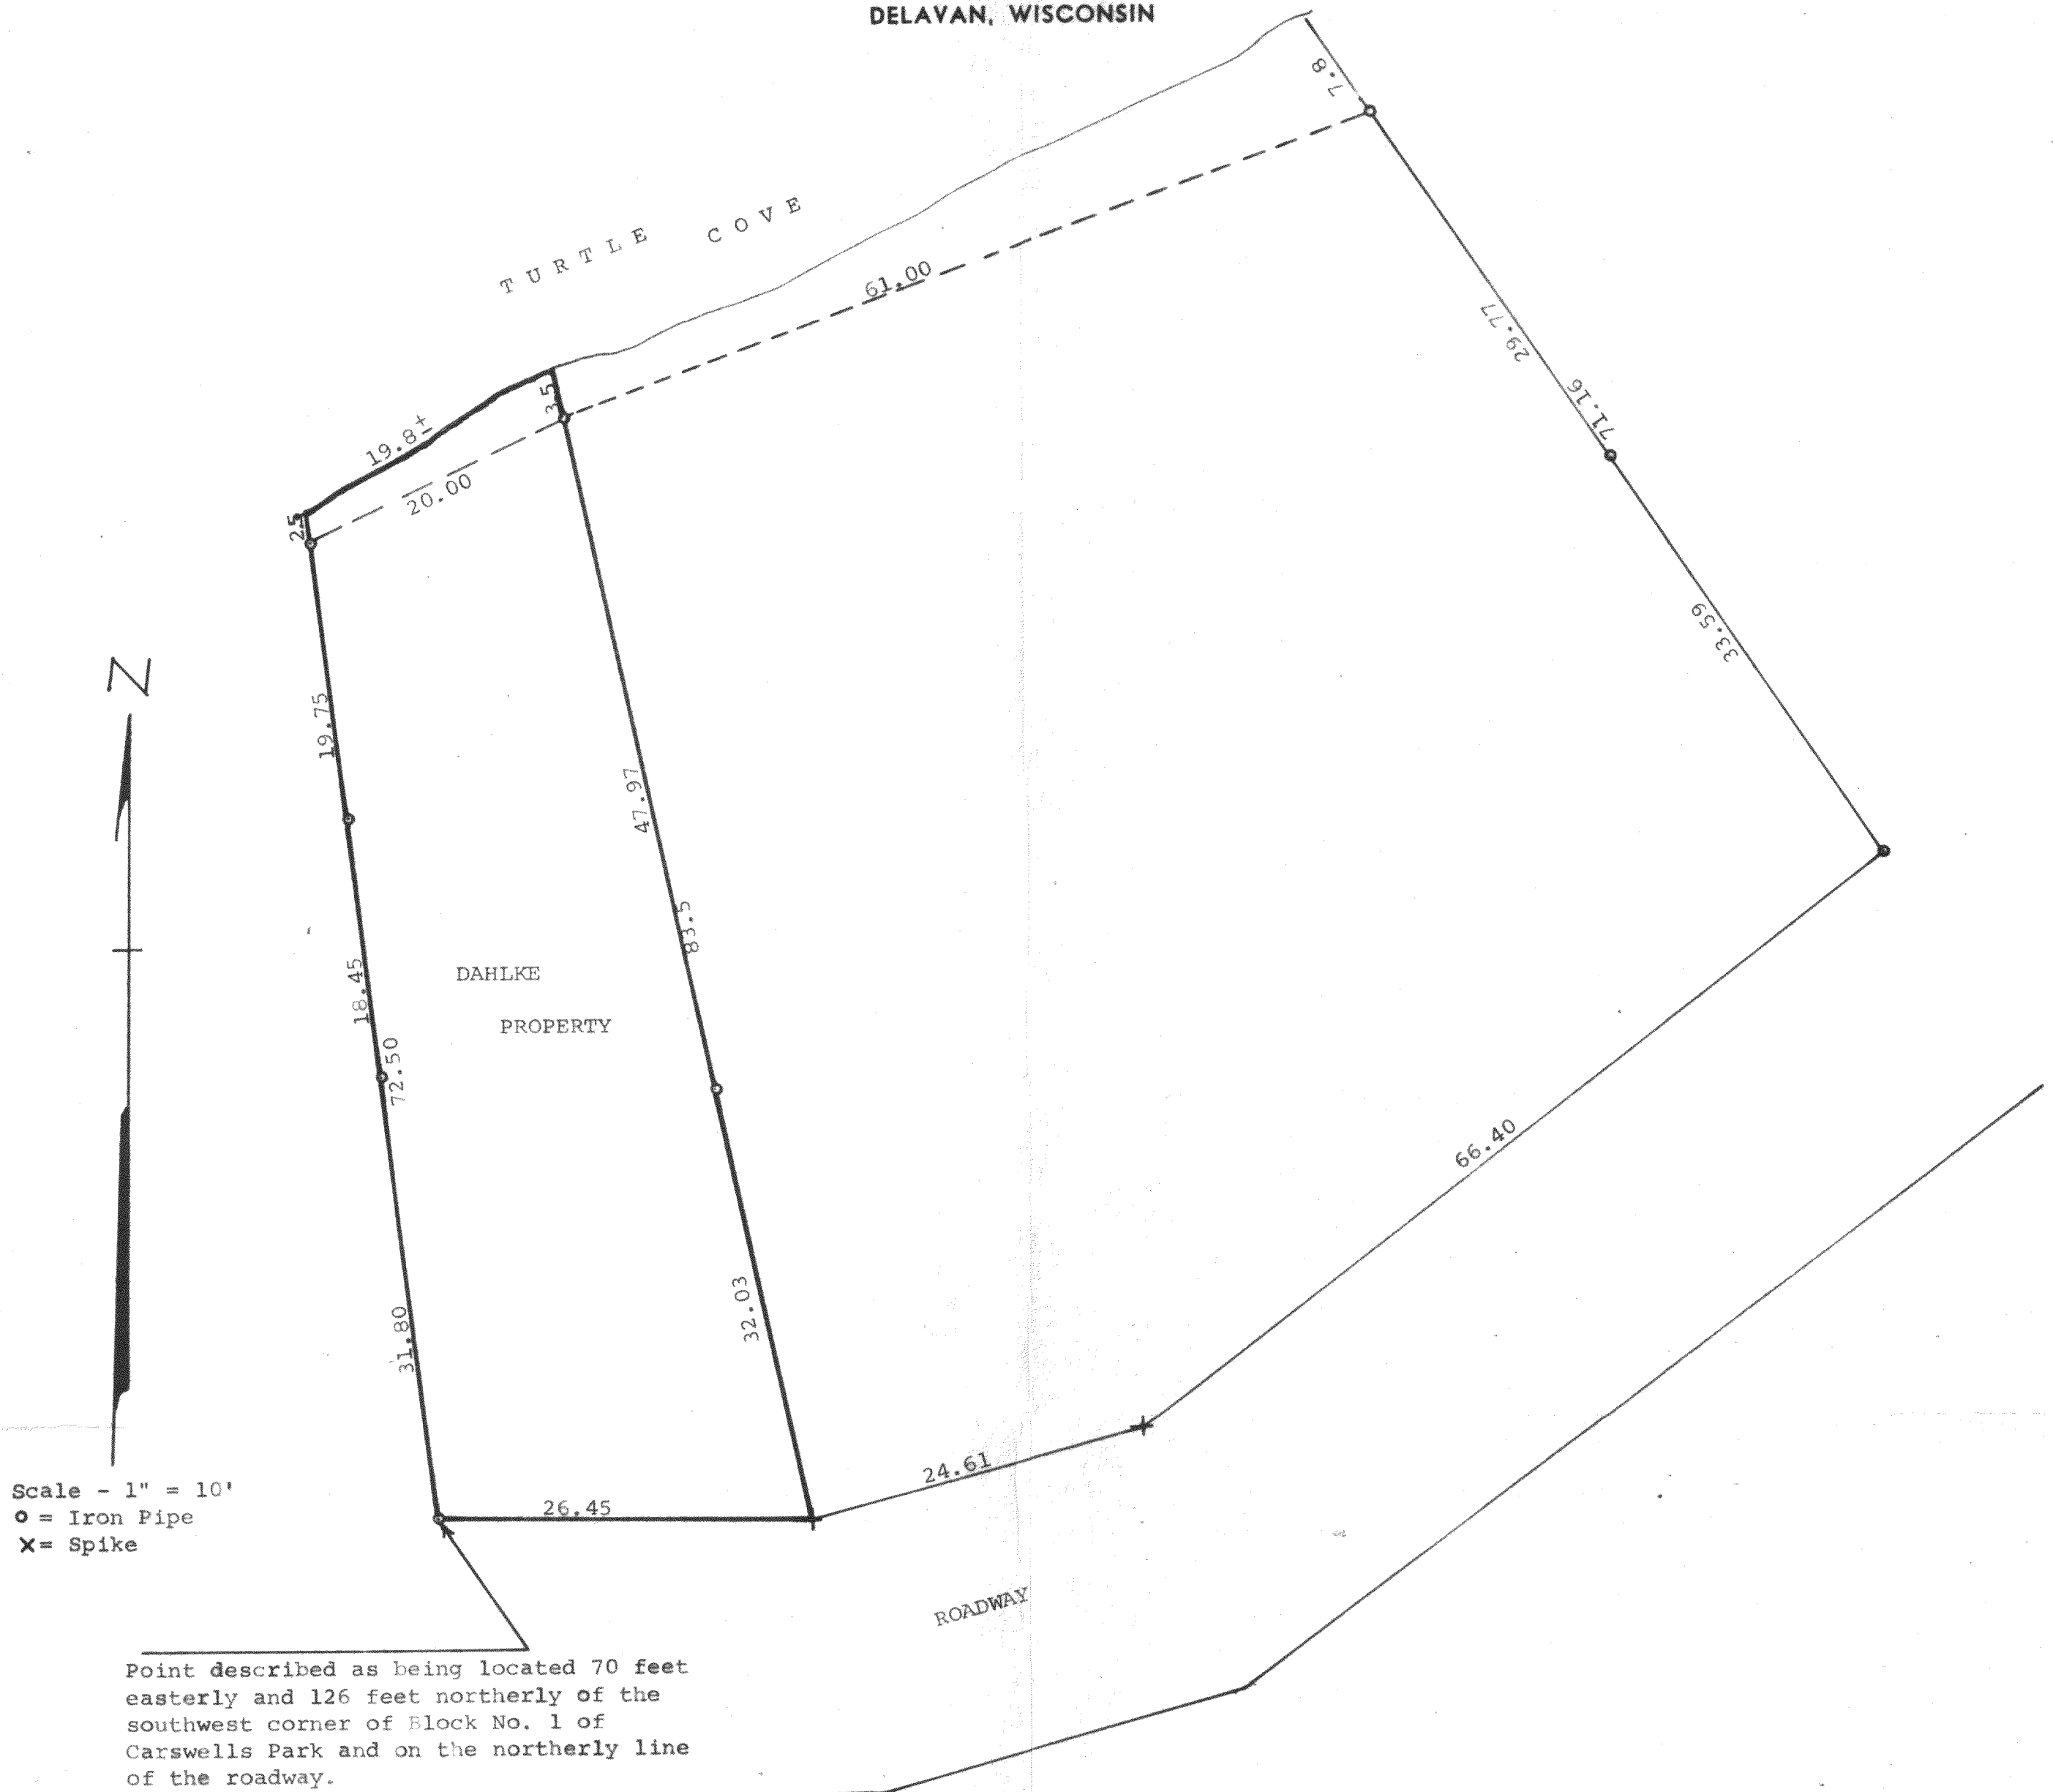

Plat of survey of a parcel of land located in Block 1 of Carswells Park in Sections 35 & 36, T4N, R16E, Walworth County, Wisconsin.
May 11, 1972

George T. Dunham
George T. Dunham, Surveyor

