

PLAT OF SURVEY LOT 4 & THE WEST 25 FEET OF LOT 3 BLOCK 3 OF CARSWELL PARK



PART OF THE SECTIONS 35 & 36, TOWN 4 NORTH,
RANGE 16 EAST, WALWORTH COUNTY, WISCONSIN

NOTE: SIDE YARD SETBACKS ARE DETERMINED BY TAKING
16% OF THE LOT WIDTH AT THE BUILDING SETBACK.
THE LOT WIDTH AT THE BUILDING SETBACK IS 74.93'
AND THEREFORE THE SIDE YARD SETBACK MINIMUM
IS 12.0'.

LEGEND

- = FOUND IRON PIPE STAKE
- = FOUND IRON REBAR STAKE
- (xxx) = RECORDED AS

EXISTING RESIDENCE

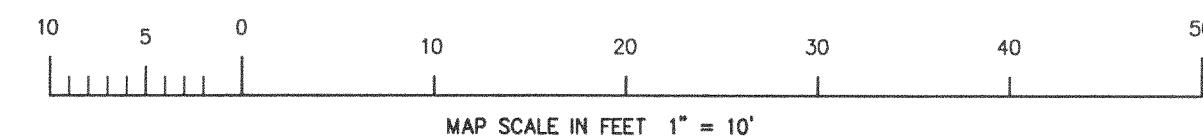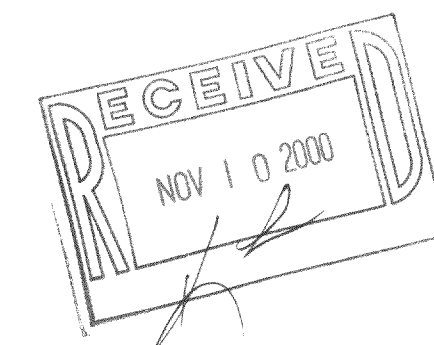

NOTE: COPIES OF THIS MAP TO WHICH THE FOLLOWING
CERTIFICATE WILL APPLY SHOW SURVEYOR'S ORIGINAL SEAL
AND SIGNATURE IN RED INK. COPIES BY ANY OTHER MEANS
MAY HAVE ALTERATIONS WHICH DO NOT REPRESENT THE
SURVEYOR'S WORK PRODUCT.

I HEREBY CERTIFY THAT THE ABOVE DESCRIBED PROPERTY HAS
BEEN SURVEYED UNDER MY DIRECTION AND THAT THE ABOVE MAP
IS A TRUE REPRESENTATION THEREOF AND SHOWS THE SIZE AND
LOCATION OF THE PROPERTY AND ITS EXTERIOR BOUNDARIES.
THIS SURVEY IS MADE FOR THE USE OF THE PRESENT OWNERS
OF THE PROPERTY, AND ALSO THOSE WHO PURCHASE, MORTGAGE,
OR GUARANTEE THE TITLE THERETO WITHIN ONE YEAR FROM THE
DATE HEREOF.

DATED: 04-27-2000

Peter S. Gordon
PETER S. GORDON R.L.S. 2101


REVISED 10-23-2000
TO SHOW SIZE & LOCATION
OF RESIDENCE AS BUILT

WORK ORDERED BY:
BILL HAVLIK
N7233 BAY CIRCLE
ELKHORN, WI. 53121

FARRIS, HANSEN & ASSOCIATES, INC.
Engineering, Architecture, Surveying
7 Ridgway Court P.O. Box 437
ELKHORN, WISCONSIN 53121
Office: (414) 723-2098
Fax: (414) 723-5856

REVISIONS
7/27/2000
ADDED
PROPOSED
RESIDENCE

PROJECT NO.
5568
DATE:
04-27-2000
SHEET NO.
1 OF 1

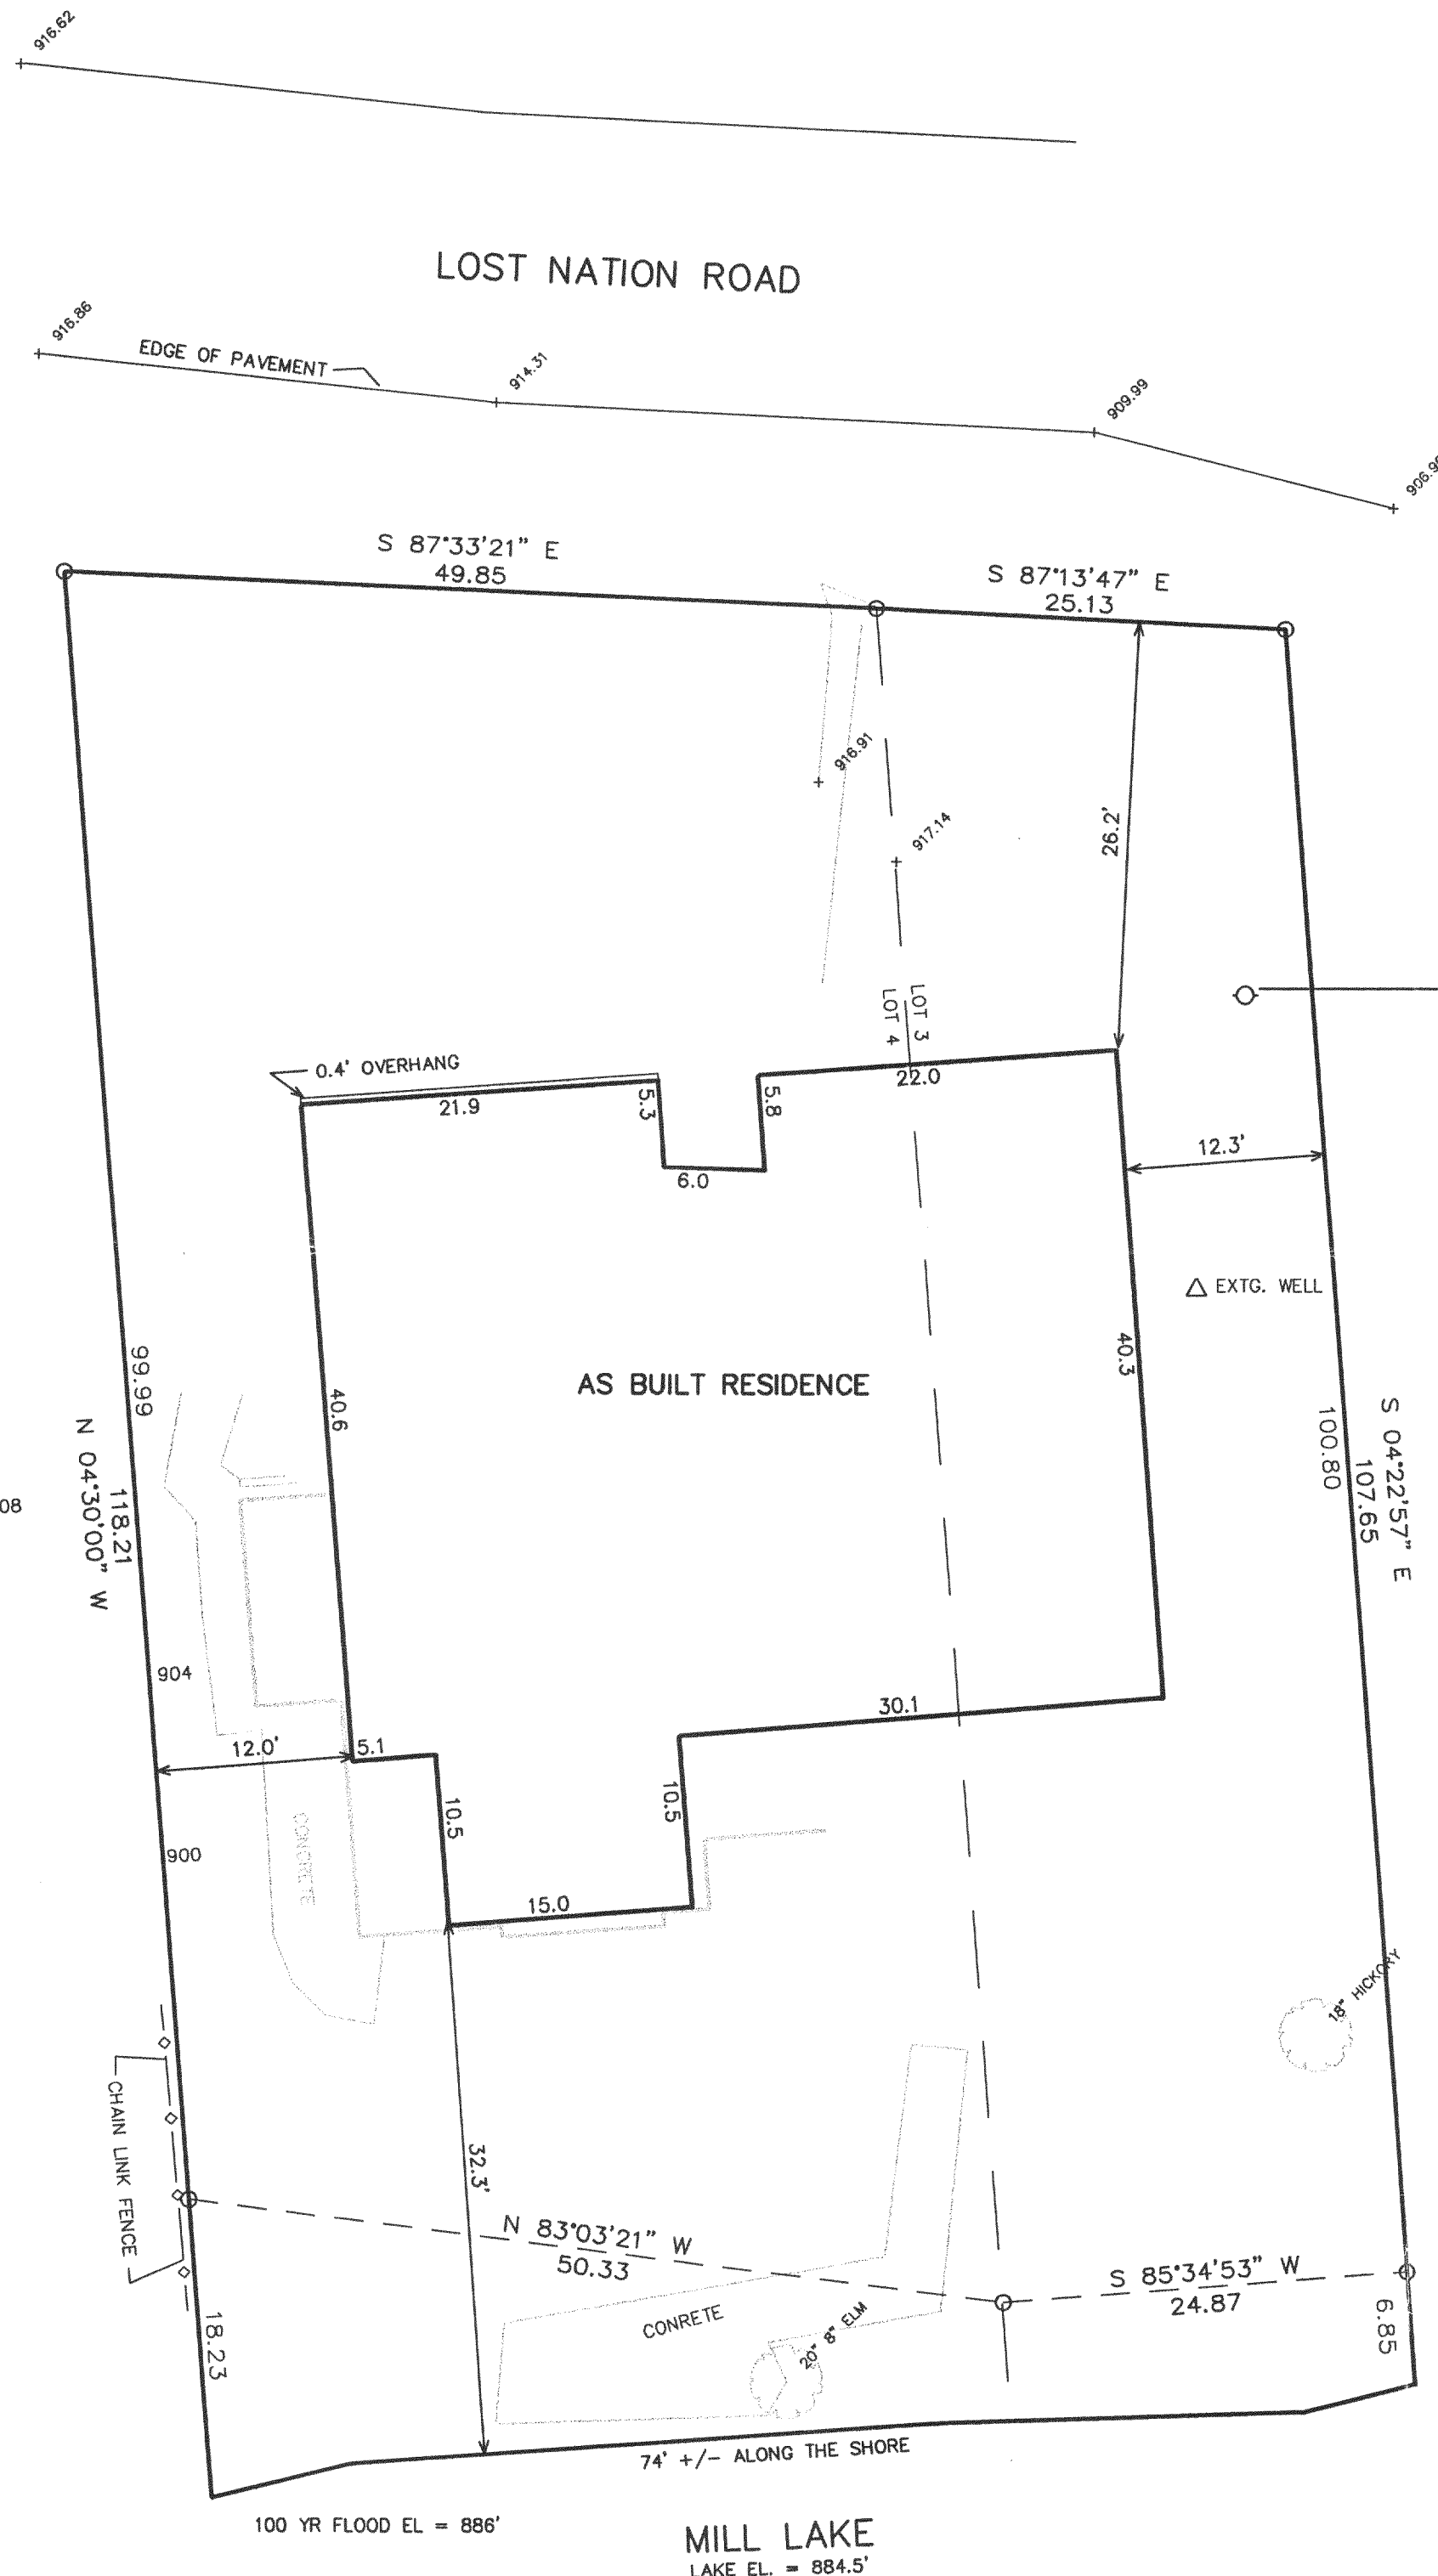

ASSIGNED WEST LINE LOT 4
N 04°30'00" W

HCA-27