


PLAT OF SURVEY

PREPARED FOR: R. DUNCAN BROWN
2047 SWAW WOODS DR.
ROCKFORD IL 61107

J.K. SURVEYING
JEFFREY L. KIMPS R.L.S.
7561 336TH AVE
BURLINGTON WI 53105
262-537-4274

- OF -
PART OF LOTS 11 AND 12 LONG POINT SUBDIVISION, LOCATED
IN SECTION 26, TOWN 4 NORTH, RANGE 16 EAST, WALWORTH
COUNTY, WISCONSIN.
(SEE PAGE 2 FOR COMPLETE LEGAL DESCRIPTION)

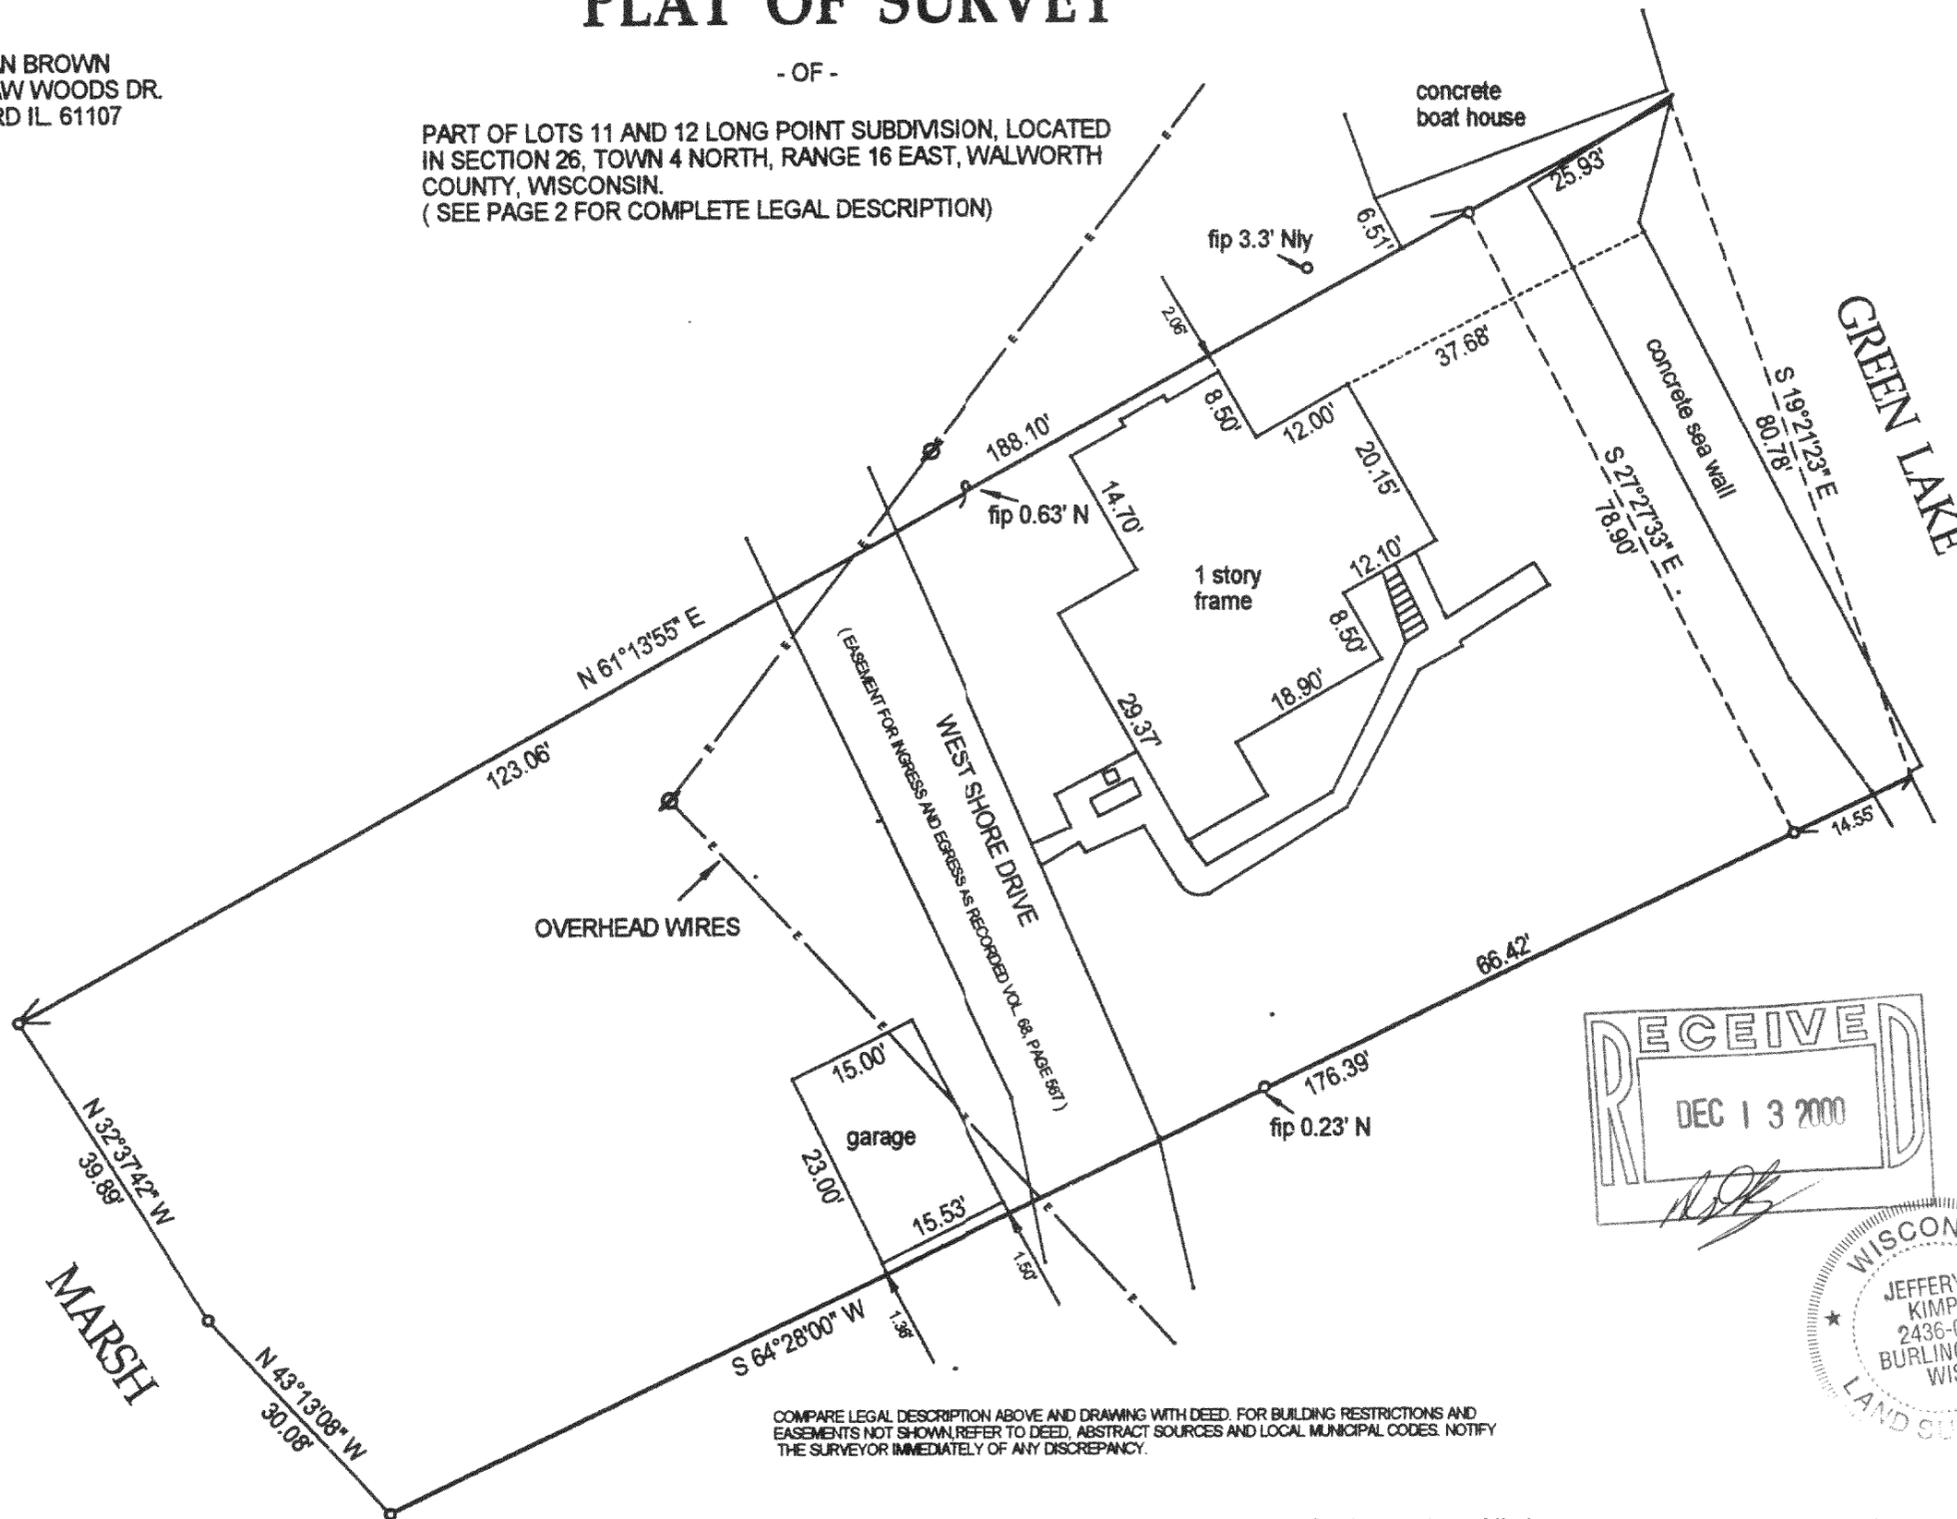

- () = recorded as
- = found iron bar
- = found iron pipe
- = set iron pipe
- = set iron bar


SCALE 1" = 20'

JOB # 98166a

TAX ID # hlpn6

COMPARE LEGAL DESCRIPTION ABOVE AND DRAWING WITH DEED. FOR BUILDING RESTRICTIONS AND EASEMENTS NOT SHOWN, REFER TO DEED, ABSTRACT SOURCES AND LOCAL MUNICIPAL CODES. NOTIFY THE SURVEYOR IMMEDIATELY OF ANY DISCREPANCY.

"I hereby certify that I have surveyed the above described property and that the above map is a true representation thereof and shows the size and location of all visible structures, apparent easements and encroachments if any."
This survey is made for the present owners of the property, and those who purchase, mortgage, or guarantee the title thereto, within one year from the date hereof. DATED THIS 26 TH, DAY OF November 20 00.

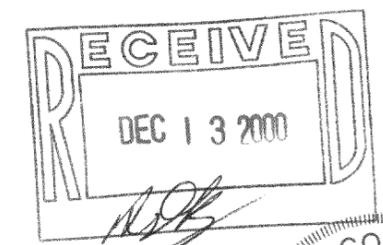

Jeffrey L. Kimps
JEFFREY L. KIMPS S - 2436
Wisconsin Registered Land Surveyor
(original if signed in red)

416-1646

HLPN-6