
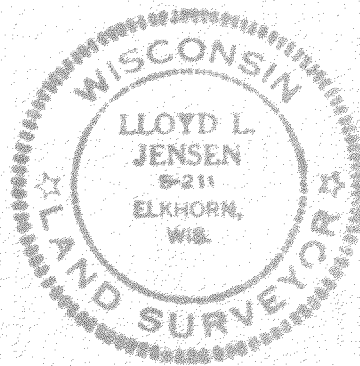


PLAT OF SURVEY

OF
A PARCEL OF LAND LOCATED IN THE SOUTH EAST 1/4 OF THE
SOUTH WEST 1/4 OF SECTION 5, TOWNSHIP 9 NORTH, RANGE
16 EAST, WALWORTH COUNTY, WISCONSIN

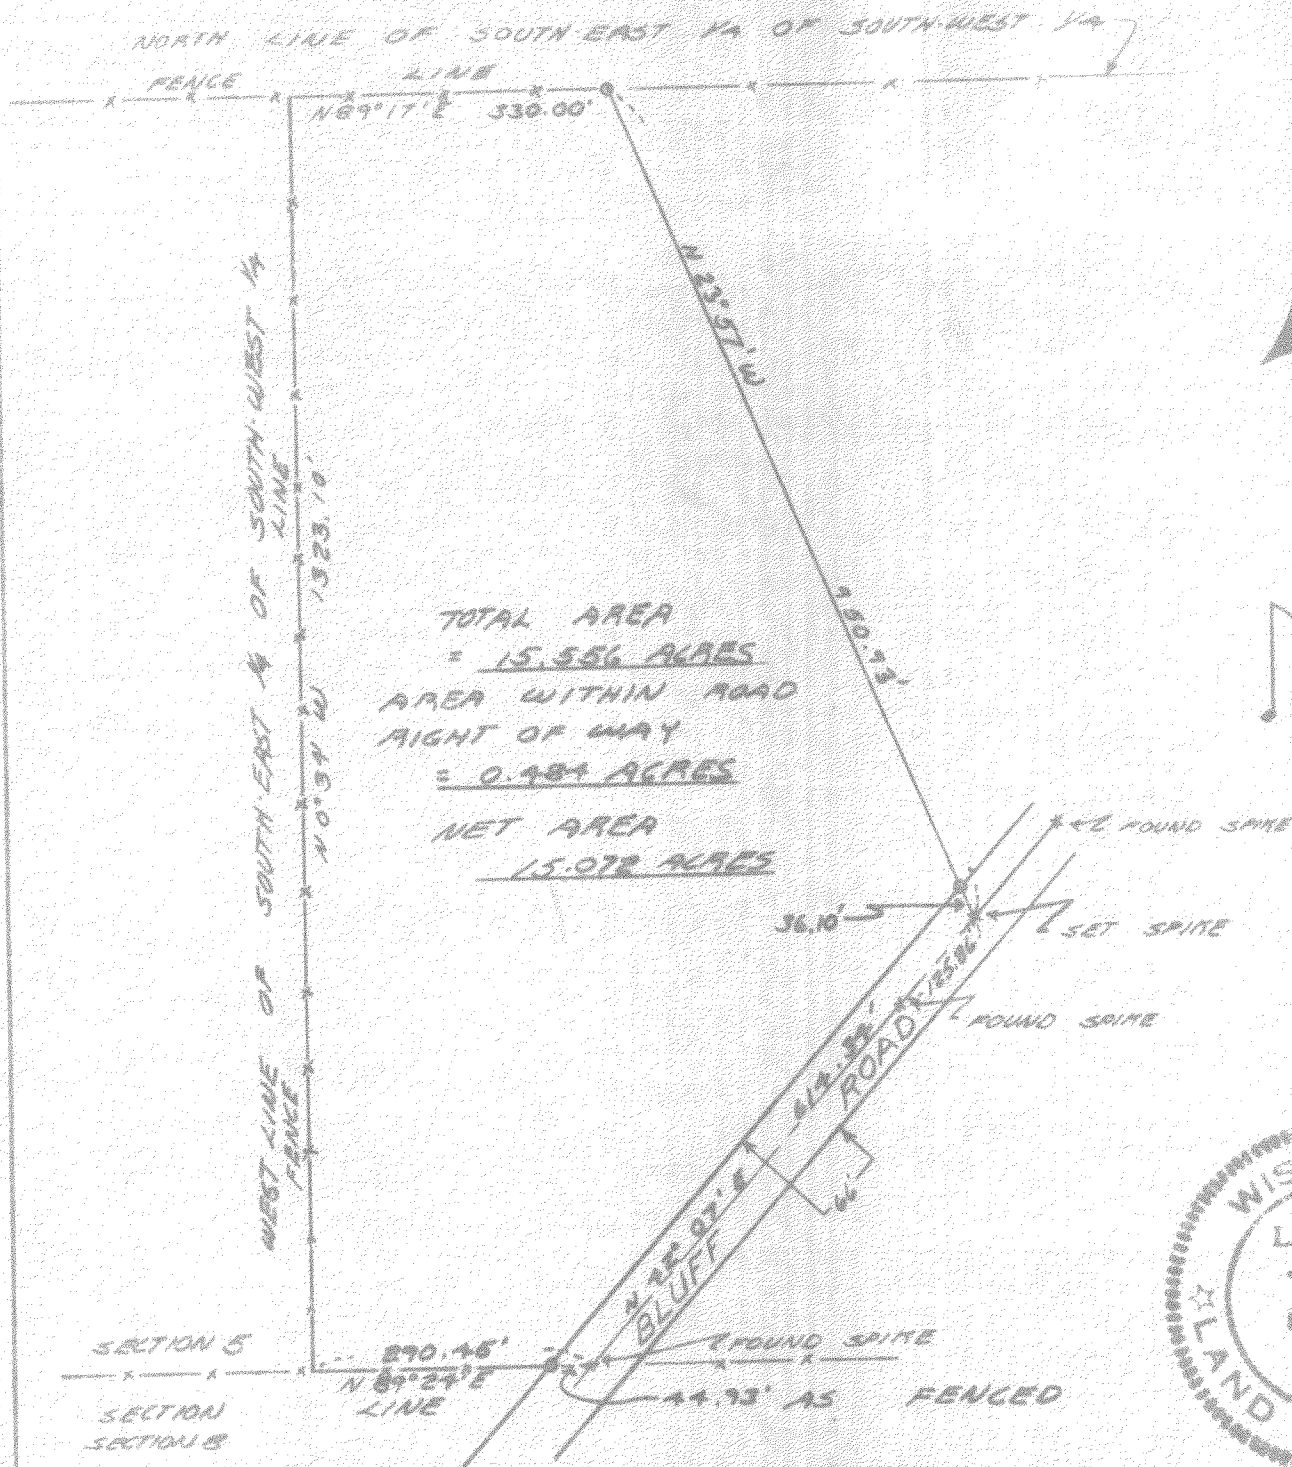

SURVEY AND PLAT BY
JENSEN & JOHNSON, INC.
CIVIL ENGINEERS AND SURVEYORS
Elkhorn, Wisconsin

LEGEND

- — Iron Pipe SET
- — Concrete Monument
- Scale 1" = 200'

WE CERTIFY: That we have surveyed the above described property and that the plat shown hereon is an accurate survey and a true representation thereof and correctly shows the exterior boundary lines and all divisions of said property.

Date MAY 1971

Lloyd L. Jensen
LLOYD L. JENSEN,

Wisconsin Registered Land Surveyor, No. S-211

LG-5-11C

416-165