
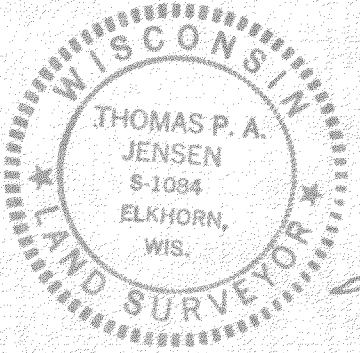


PLAT OF SURVEY

OF
LOT 71 OF LAURELDALE HEIGHTS, A SUBDIVISION LOCATED
IN SECTION 36, T4N R1E, WILKINSON COUNTY, WISCONSIN

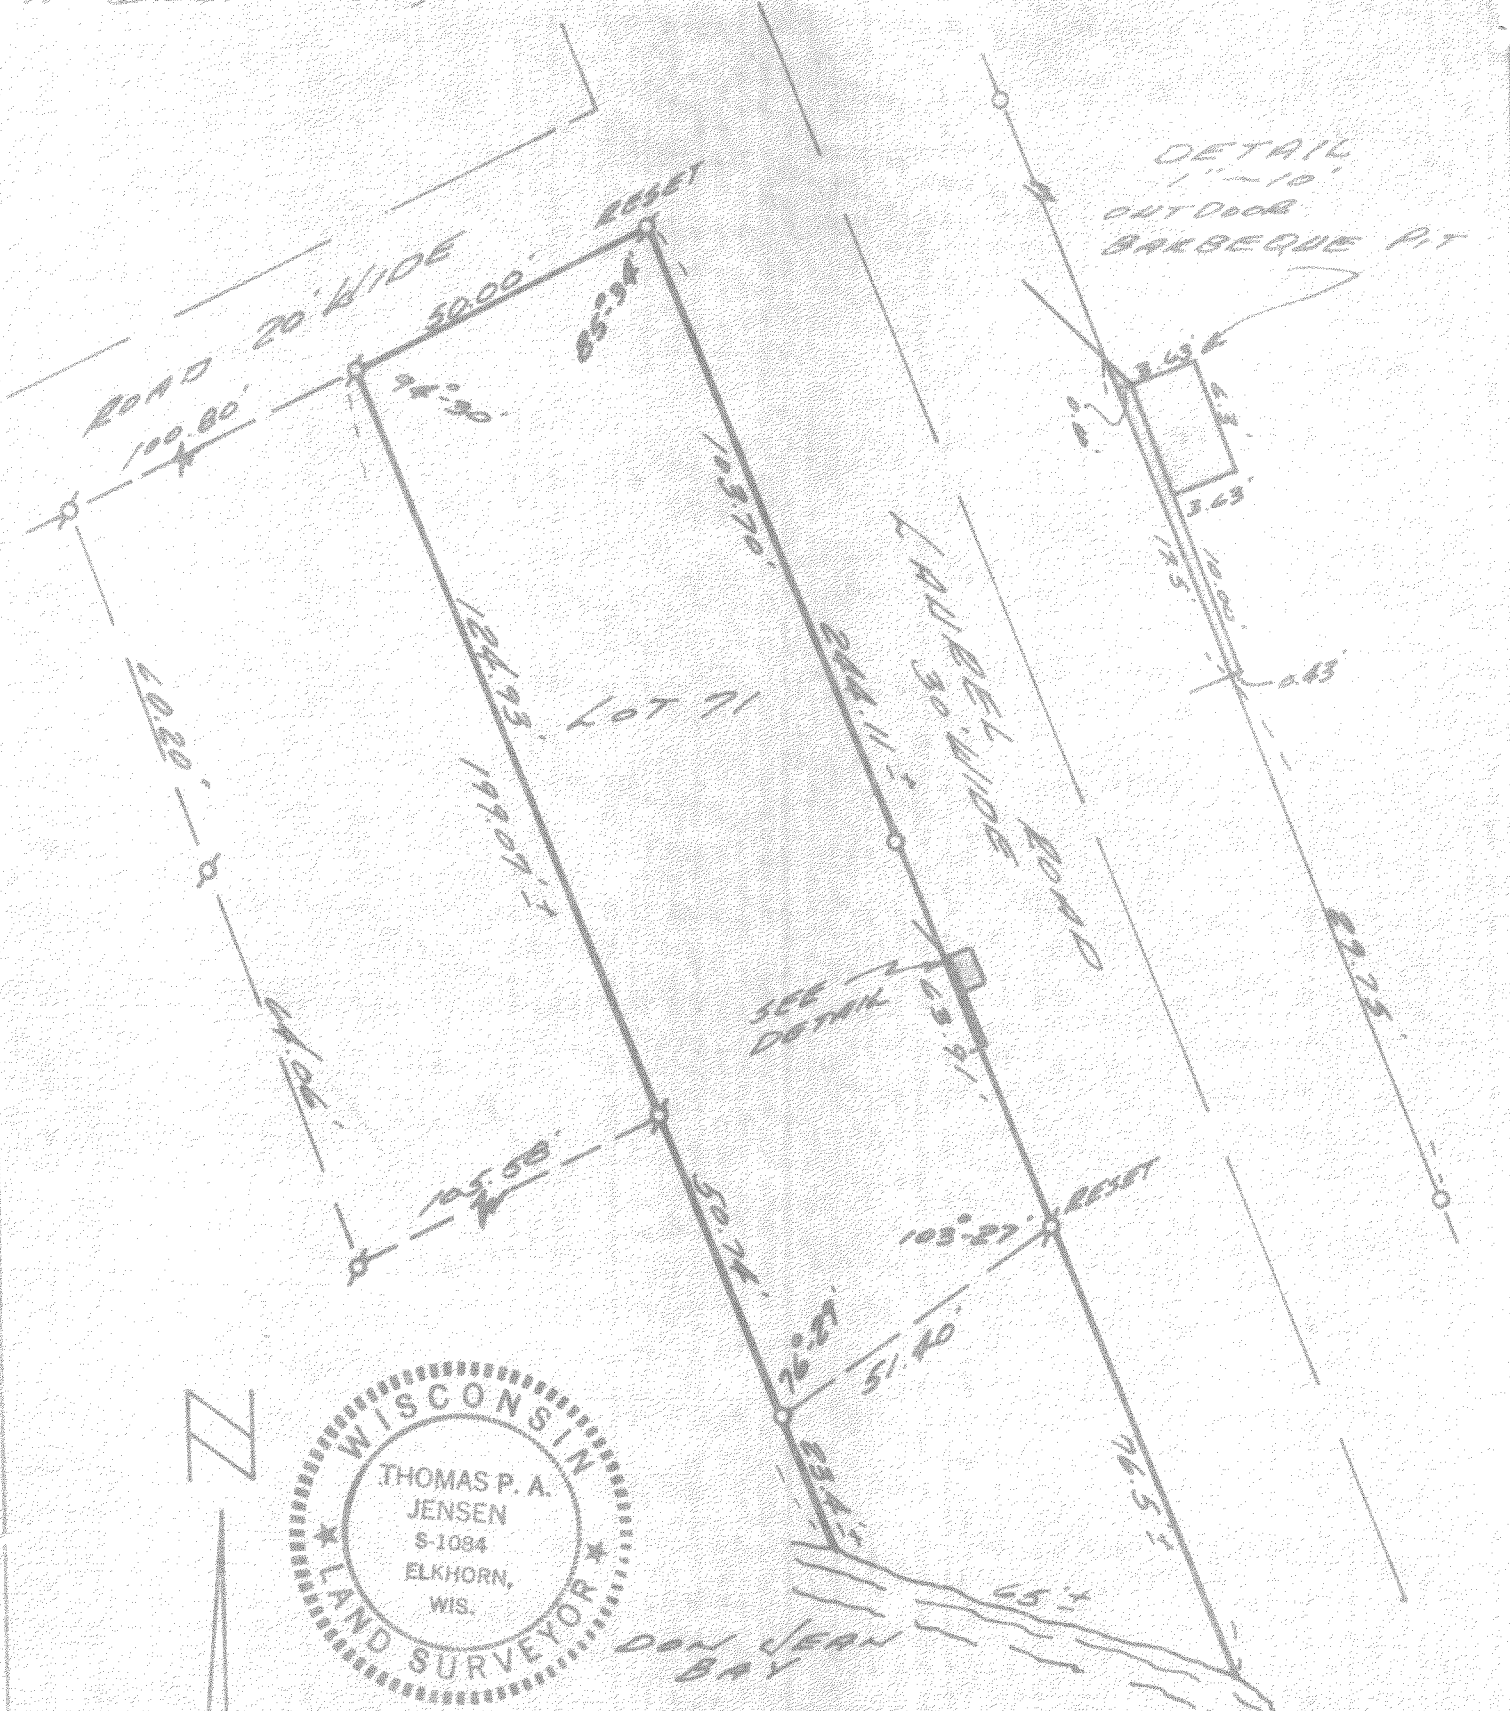

SURVEY AND PLAT BY
JENSEN & JOHNSON, INC.
CIVIL ENGINEERS AND SURVEYORS
Elkhorn, Wisconsin

- LEGEND**
- — Iron Pipe SET
 - — Concrete Monument
 - Scale 1" = 30'
 - ⊗ — IRON PIPE FOUND

WE CERTIFY: That we have surveyed the above described property and that the plat shown hereon is an accurate survey and a true representation thereof and correctly shows the exterior boundary lines and all divisions of said property.

Date MAY 25, 1973 *Thomas P. A. Jensen*

Wisconsin Registered Land Surveyor, [REDACTED]

NLN-30

416-166