
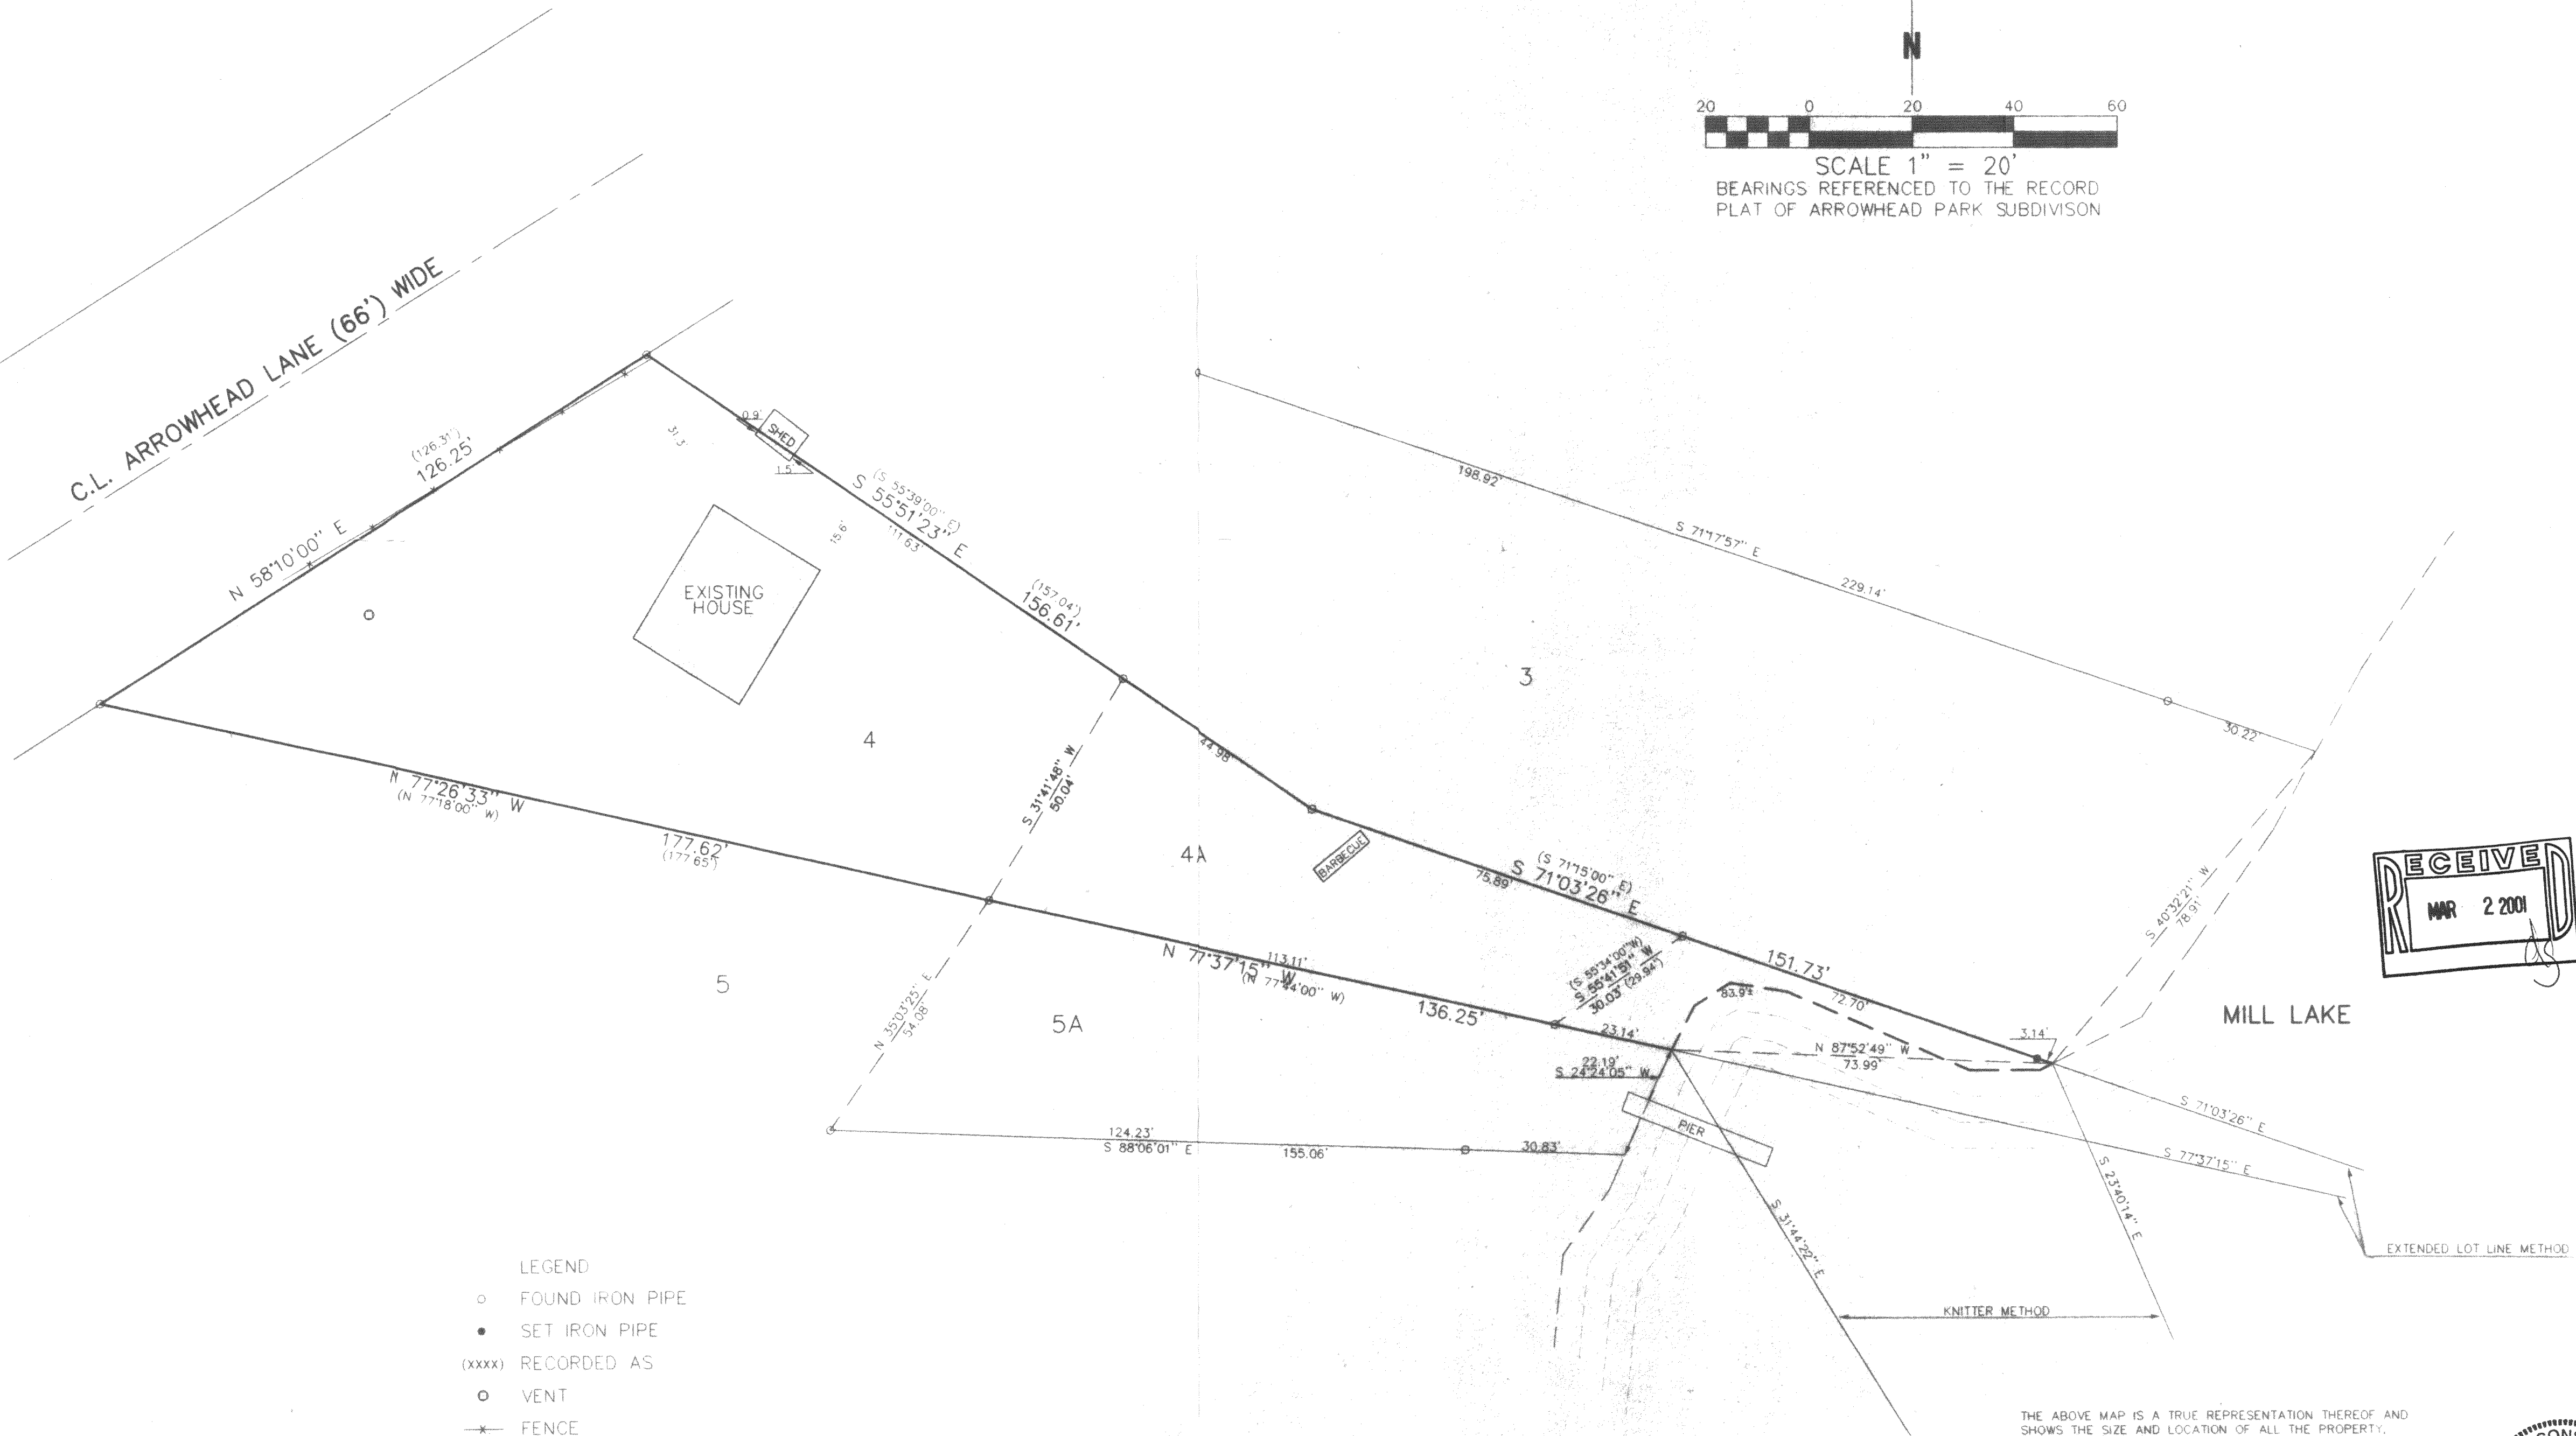


PLAT OF SURVEY

ORDERED BY: CENTURY 21 ZENK REALTY
804 NORTH WISCONSIN
ELKHORN, WI. 53121


DESCRIPTION: LOTS 4 AND 4A OF ARROWHEAD PARK, A SUBDIVISION
LOCATED IN GOVERNMENT LOT 3 IN THE SOUTHEAST 1/4
OF SECTION 35, T4N, R16E, WALWORTH COUNTY,
WISCONSIN

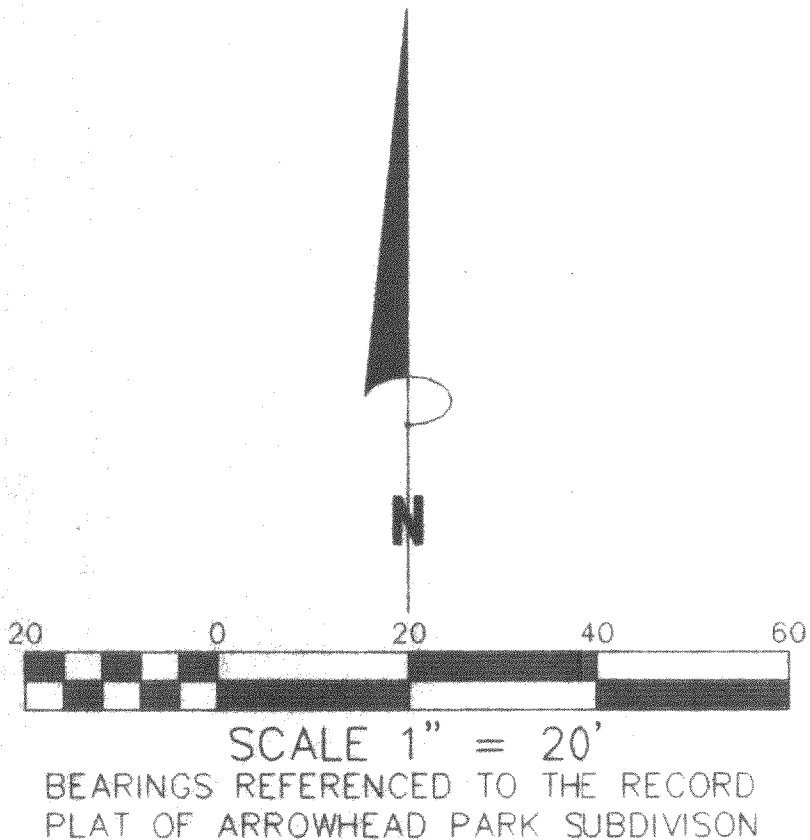

- LEGEND
- FOUND IRON PIPE
 - SET IRON PIPE
 - (XXXX) RECORDED AS
 - VENT
 - ✱ FENCE

THE ABOVE MAP IS A TRUE REPRESENTATION THEREOF AND SHOWS THE SIZE AND LOCATION OF ALL THE PROPERTY, EXTERIOR BOUNDARIES, THE LOCATION OF ALL VISIBLE BOUNDARY FENCES, APPARENT EASEMENTS, ROADWAYS AND VISIBLE ENCROACHMENTS, IF ANY.

THIS SURVEY IS MADE FOR THE USE OF THE PRESENT OWNERS OF THE PROPERTY AND ALSO THOSE WHO PURCHASE, MORTGAGE OR GUARANTEE TITLE THERETO WITHIN ONE (1) YEAR FROM DATE HERETO.

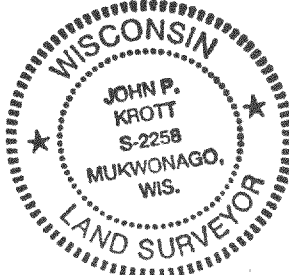

PATHFINDER SURVEYING
FORMERLY KOLB LAND CONSULTING
929 WILLIAMS STREET LAKE GENEVA, WI 53147
(414) 248-3697

JOHN P. KROTT, R.L.S. 2258

DATE: 8-19-1999 NOTE: THIS IS NOT A CERTIFIED COPY UNLESS SEAL IS IN RED JOB NUMBER 99193

HAP-3

416-1660

4-16-HAP-4E4A