


Plat of Survey

of


Lot 4 of Certified Survey Map No. 813,

recorded in Vol. 3 of Certified Survey Maps of Walworth County on Page 356 and located in the Northeast 1/4 of Section 35 and the Northwest 1/4 of Section 36, Town 4 North, Range 16 East, Town of LaGrange, Walworth County, Wisconsin.

Surveyed for: **Keefe Real Estate, Inc.**
751 Geneva Parkway
Lake Geneva, Wisconsin. 53147

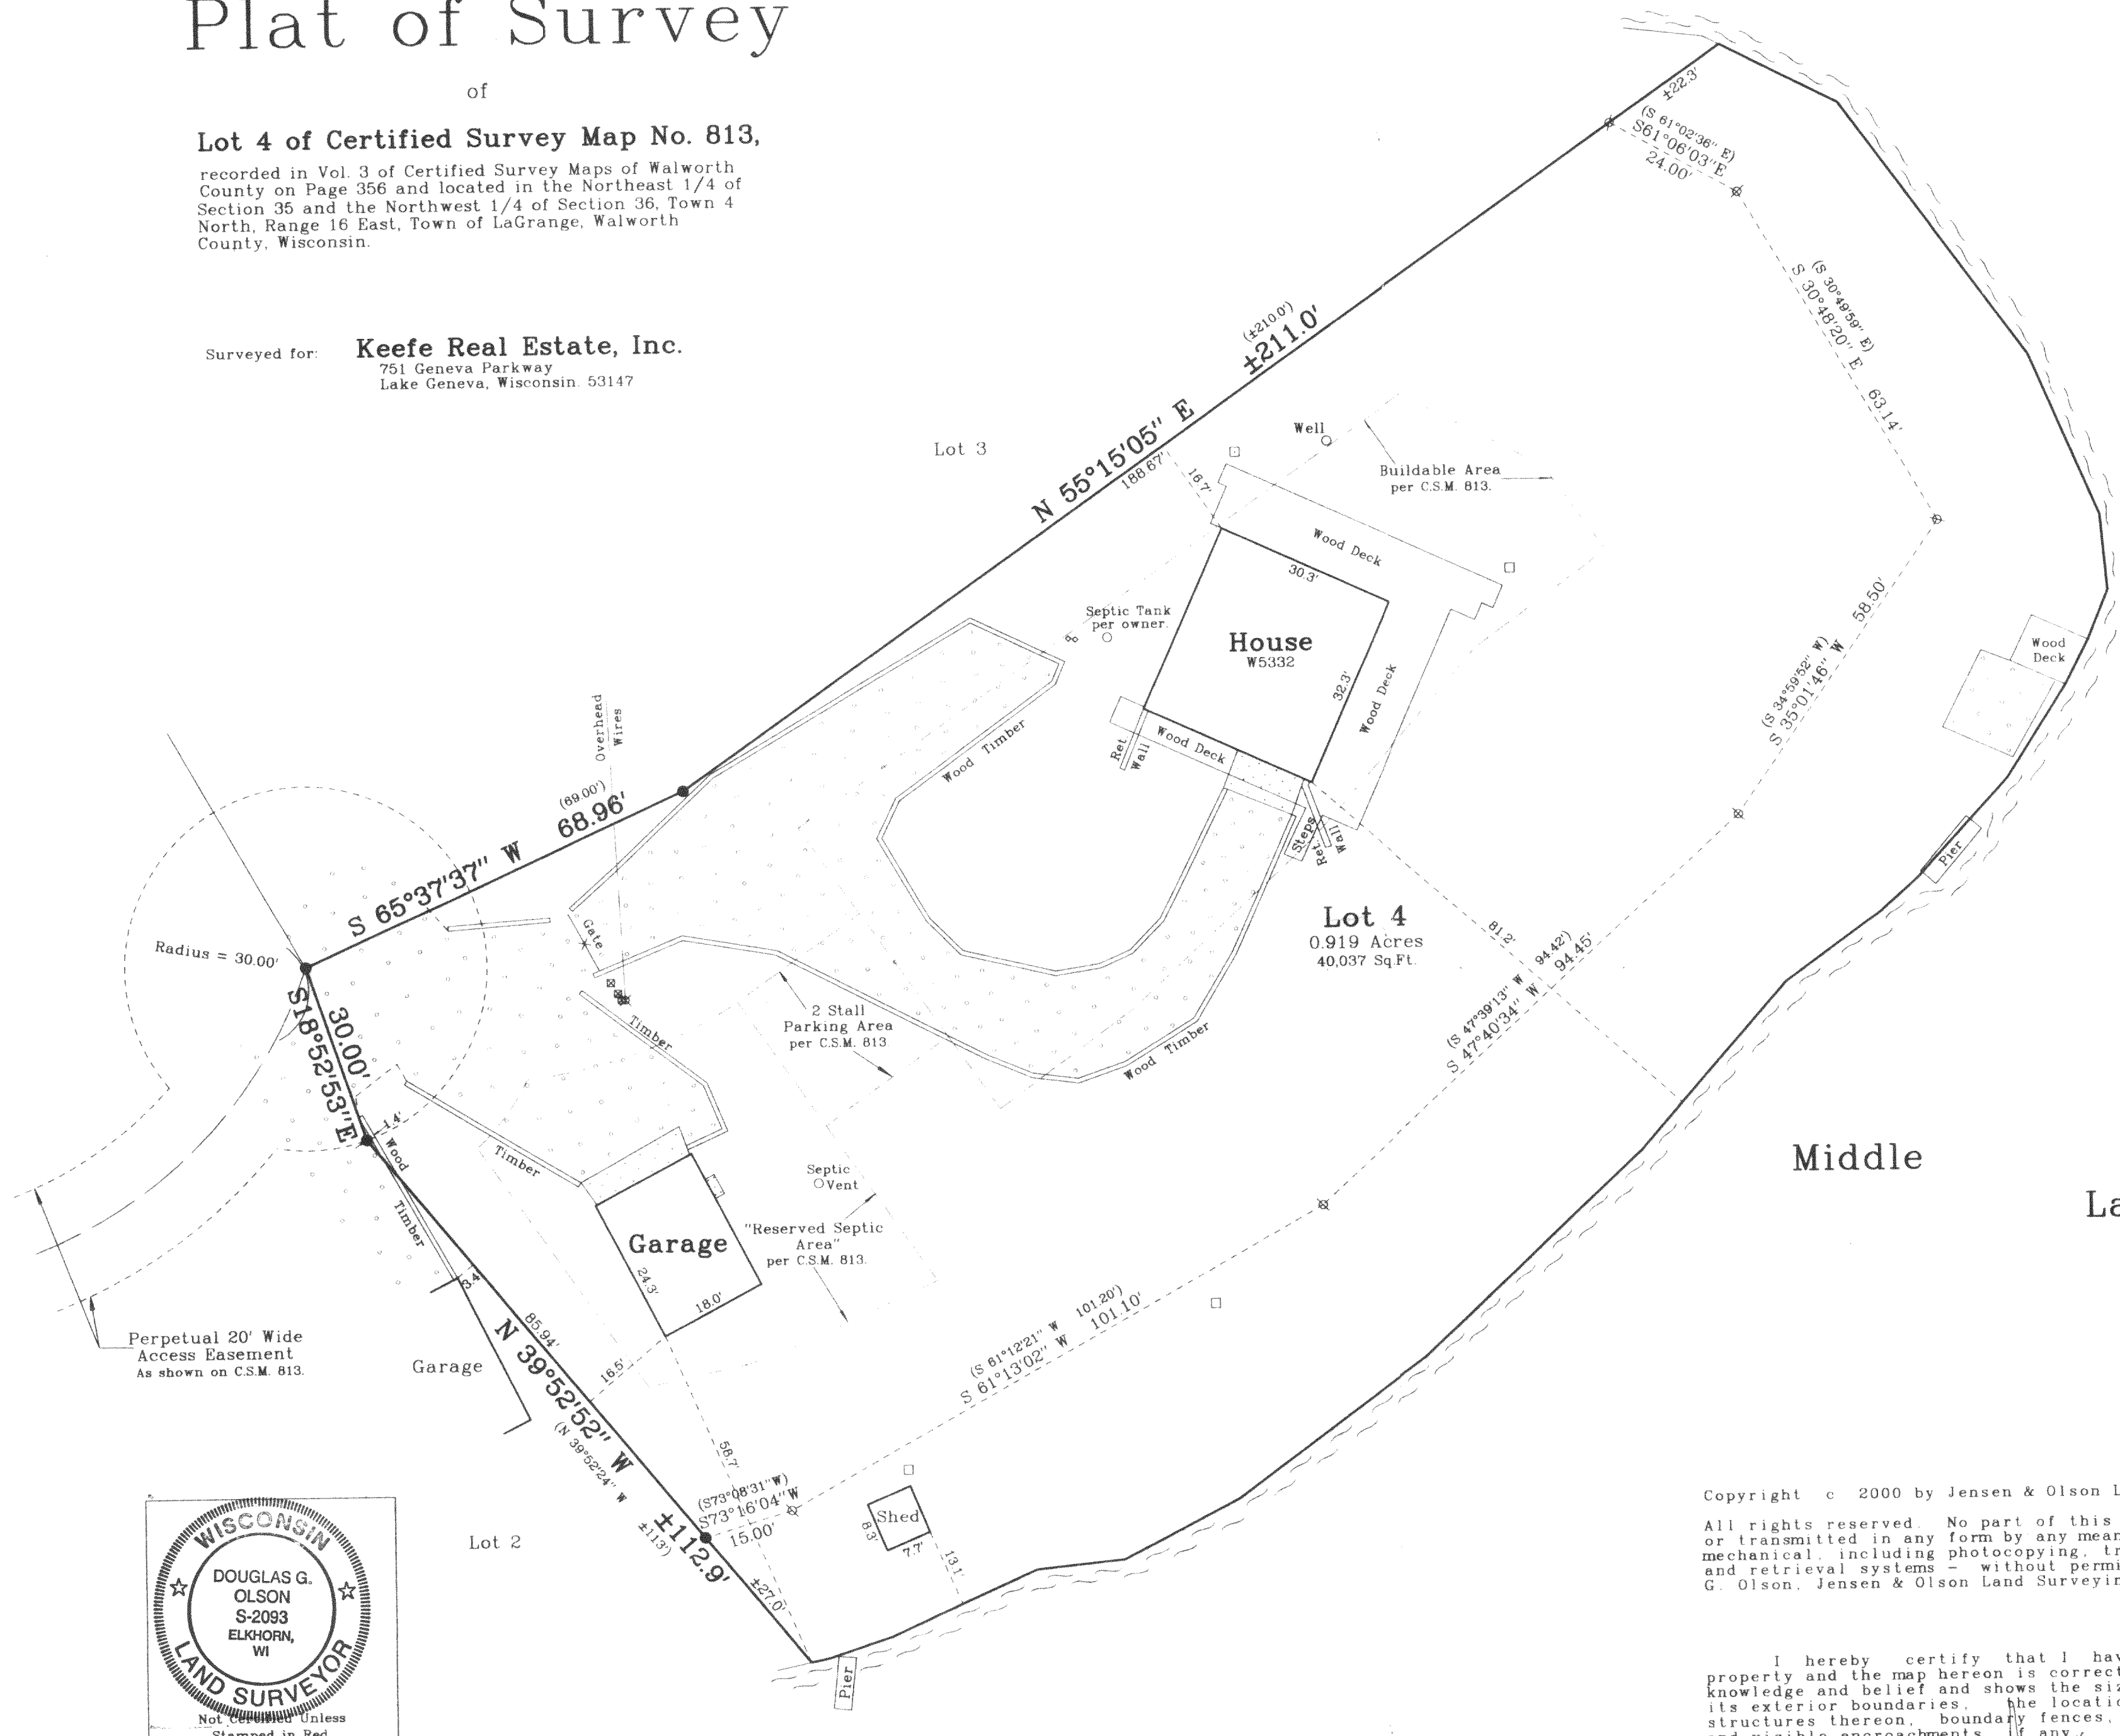

Bearings referenced to Certified Survey Map No. 813.

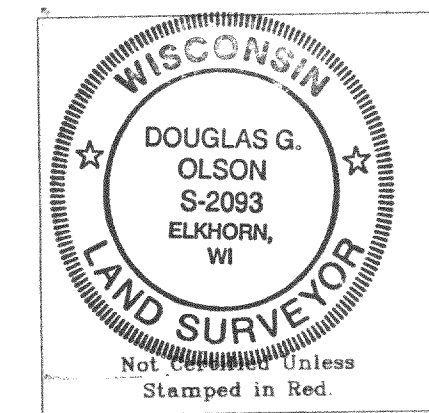

- Notes: 1) This survey plat is not certified unless signed and sealed in red ink.
- 2) This survey is subject to Wisconsin lien laws. This Plat of Survey is the notice of intent to file lien. Lien waiver required.

Copyright © 2000 by Jensen & Olson Land Surveying, LLC.


All rights reserved. No part of this survey plat may be reproduced or transmitted in any form by any means - graphic, electronic, or mechanical, including photocopying, tracing, or information storage and retrieval systems - without permission in writing from Douglas G. Olson, Jensen & Olson Land Surveying, LLC.

I hereby certify that I have surveyed the above described property and the map hereon is correct to the best of my professional knowledge and belief and shows the size and location of the property, its exterior boundaries, the location and dimensions of all visible structures thereon, boundary fences, apparent easements and roadways and visible encroachments, if any.

This survey is made for the exclusive use of the present owners of property, and also those who purchase, mortgage or guarantee title thereto, within one year from the date hereof.

Douglas G. Olson
Wisconsin Registered Land Surveyor - 2093

Survey Date: Nov. 3, 2000.
Revisions:

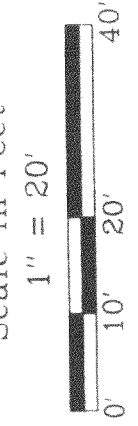

Jensen & Olson Land Surveying, LLC
45 South Wisconsin Street
Elkhorn, Wisconsin 53121
P.O. Box 322
Telephone (262) 723-3434
Facsimile (262) 723-8044

- Legend
- Found Iron Rod 1 3/16" dia.
 - Found Iron Rod 3/4" dia.
 - Found Iron Rod 1/2" dia.
 - Utility Pedestal
 - Sprinkler Control Box
 - Concrete Surface
 - Utility Pole
 - Gravel Surface
 - PVC Pipe

Sheet 1 of 1 Sheets
Job Reference Number
2000.139
2000.139

HA-813-4 416-1667