


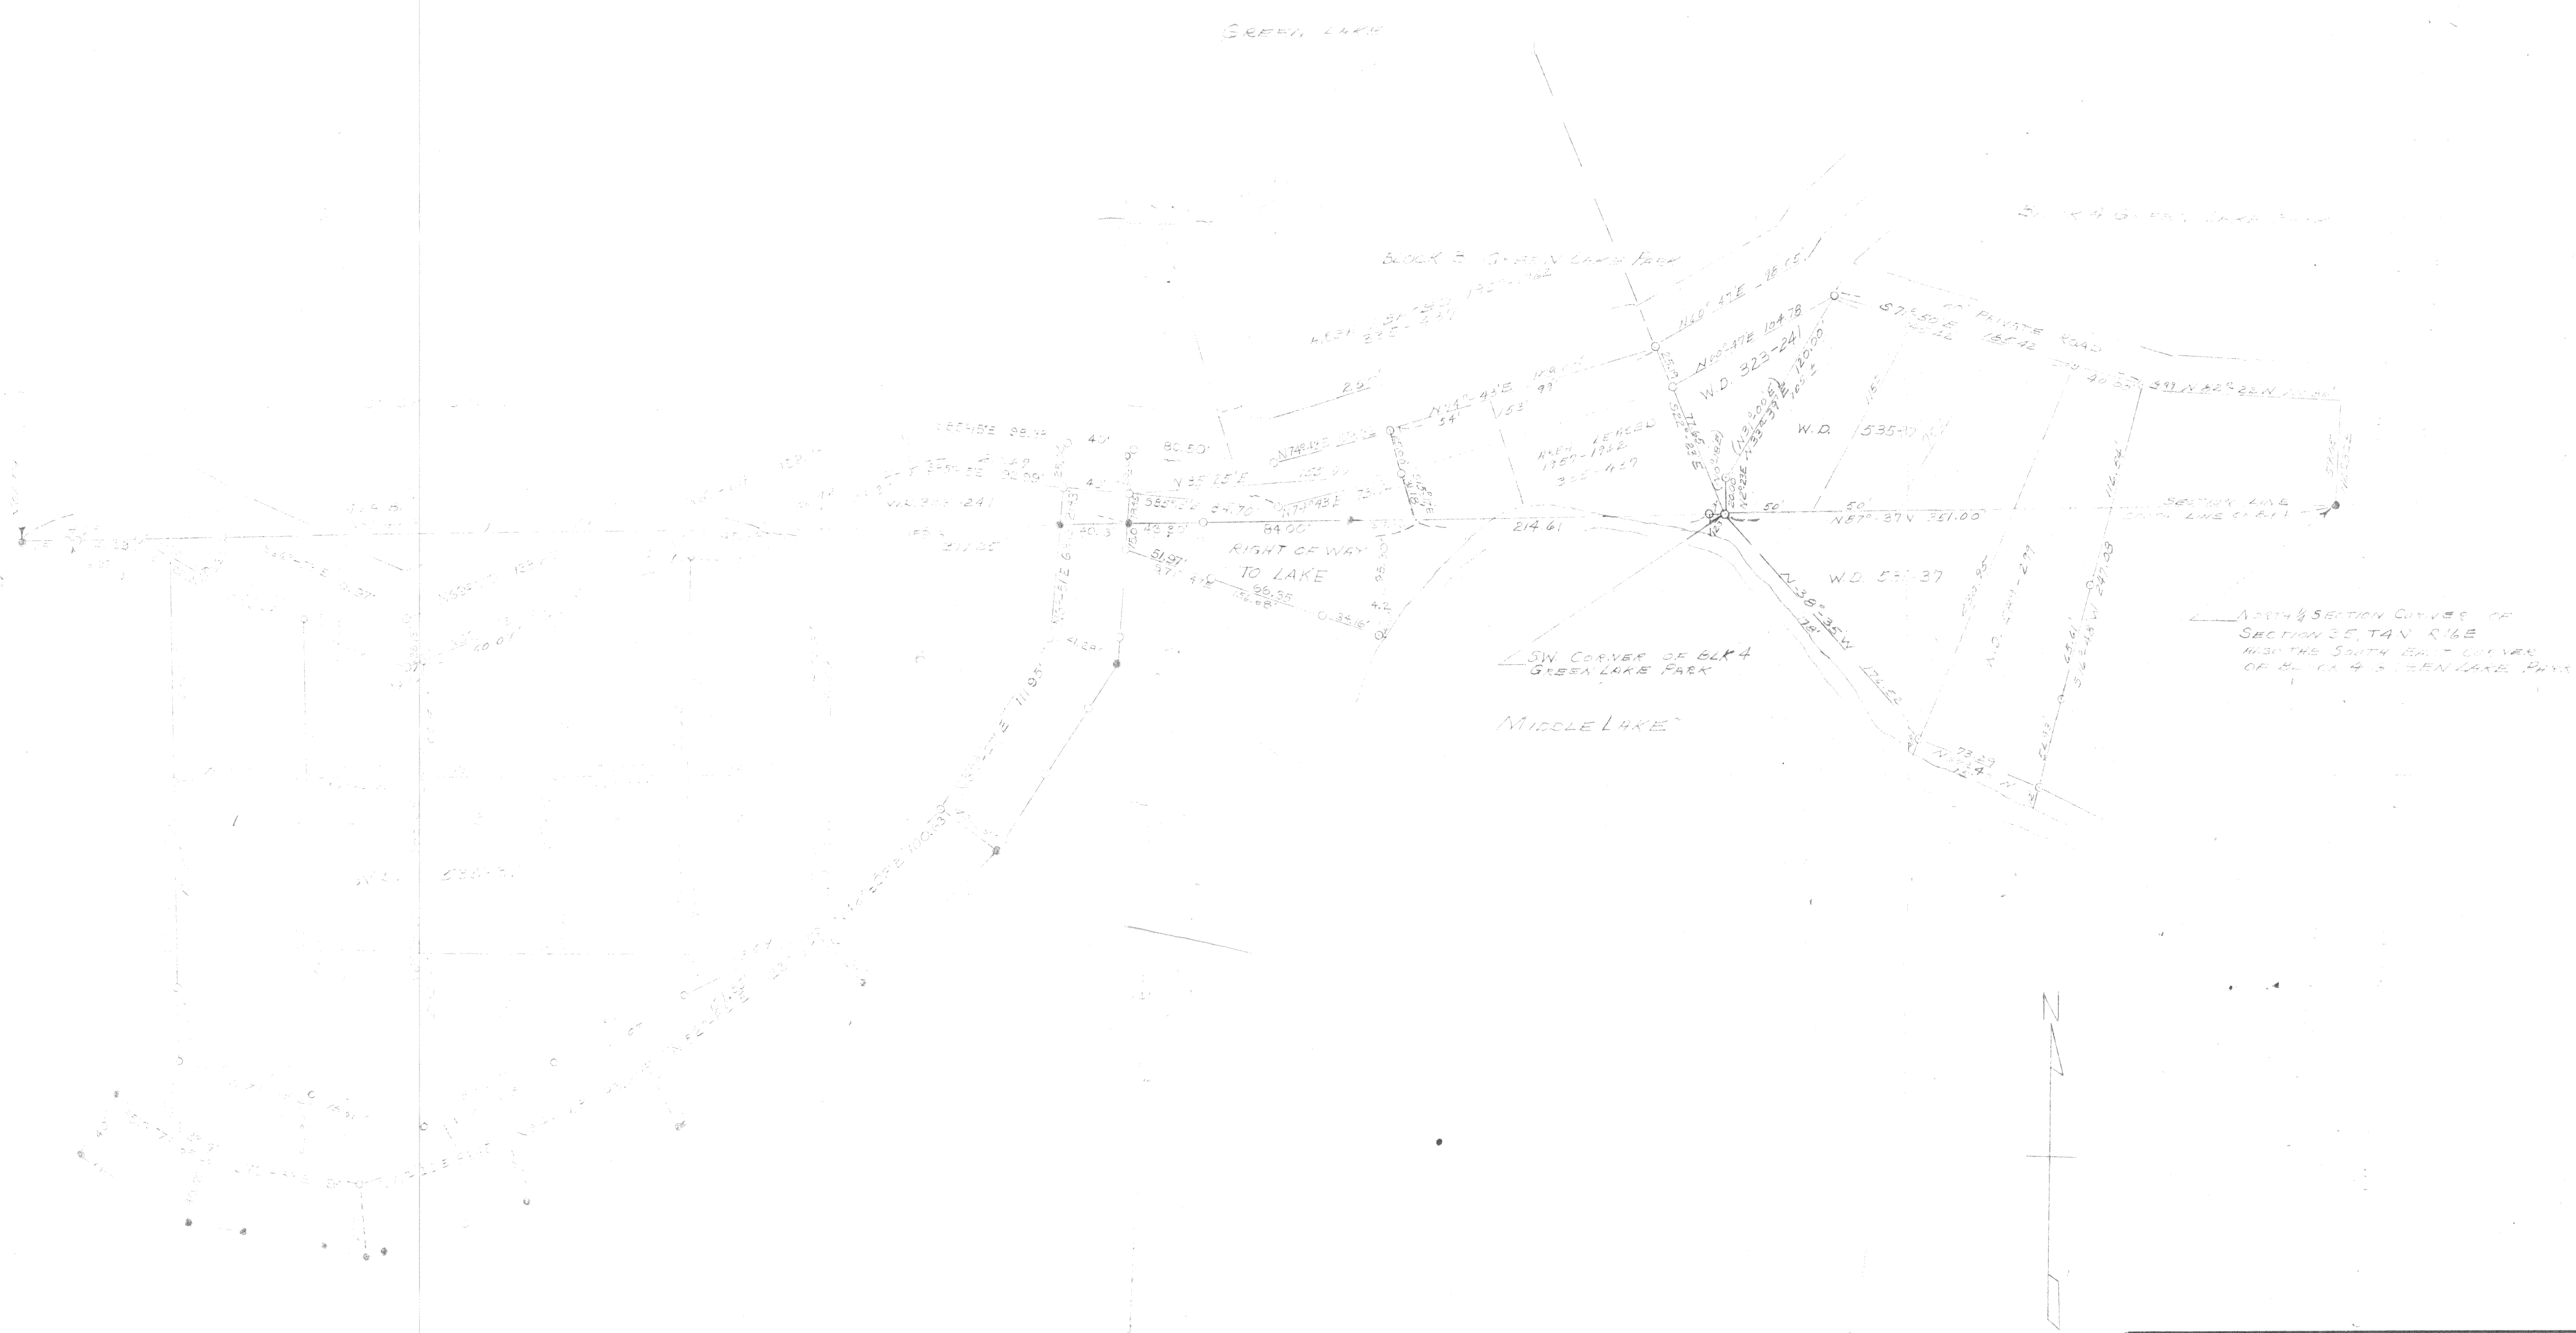

LG-35-34 LG-35-35
 " 21 LG-35-37
 " 30 + 31 + 32 LG-35-38
 35-1E, 1D, 1C " 39A, 39B, 39C 39D, 39E 39F
 " 25
 35-26 + 27 + 28 + 29
 35-22
 35-23 + 24 Blk 3 - Green Lake

PLAT OF SURVEY OF PART OF BLOCK 3, 3RD GREEN LAKE PARK SUBDIVISION IN THE SW 1/4 OF SECTION 35, T4N R16E AND A PART OF THE NW 1/4 OF SECTION 36, T4N R16E, WILCOX CO. WIS.		
DRAWN BY T. JOHNSON	JENSEN & JOHNSON CIVIL ENGINEERS ELKHORN, WIS. DATE: FEBRUARY 1960	SCALE: 1"=50' REVISED SHEET NO. 1 OF 1
CHECKED BY _____		
APPROVED BY _____		

North 1/16 CORNER OF THE NW 1/4
OF SECTION 35, T4N, R16E
NORTH LINE OF SECTION 35, T4N, R16E
NORTH LINE OF SECTION 35, T4N, R16E

NORTH LINE OF SECTION 35, T4N, R16E
NORTH LINE OF SECTION 35, T4N, R16E

GREEN LAKE

BLOCK 3 GREEN LAKE PARK

AREA LEASED
1957-1962
325-437

BLOCK 4 GREEN LAKE PARK

20' PRIVATE ROAD
18642

RIGHT OF WAY
TO LAKE

SW CORNER OF BLK 4
GREEN LAKE PARK

MIDDLE LAKE

NORTH SECTION CORNER OF
SECTION 35, T4N, R16E
NE30 THE SOUTH EAST CORNER
OF BLOCK 4 GREEN LAKE PARK

NOTE: BRGS, DIMENSIONS & OTHER INFO IN
RED ADDED BY THIS OFFICE - ORIGINAL
IN POOR CONDITION & DOES NOT
COPY WELL

Jlc
06/29/98

LG-35-34 LG-35-35
" 21 LG-35-37
" 30 + 31 + 32 LG-35-38
" 35-IE, + 1D, 1C " 39
" 35-26 + 27 + 28 + 29 " 39A, 39B, 39C, 39D, 39E 39F
35-22 LG-35-47
35-23 + 24 Blk 3-Green Lake

PLAT OF SURVEY OF PART OF BLOCK 3 & 4 GREEN LAKE PARK SUBDIVISION IN THE SW 1/4 OF SECTION 35, T4N, R16E AND A PARCEL IN THE NE 1/4 NW 1/4 OF SECTION 35, T4N, R16E WHL CO. WIS.		
DRAWN BY TJENSEN	JENSEN & JOHNSON CIVIL ENGINEERS ELKHORN, WIS. DATE FEBRUARY 1960	SCALE: 1"=50'
CHECKED BY		REVISED
APPROVED BY		SHEET NO. 1 OF 1