


#136-68

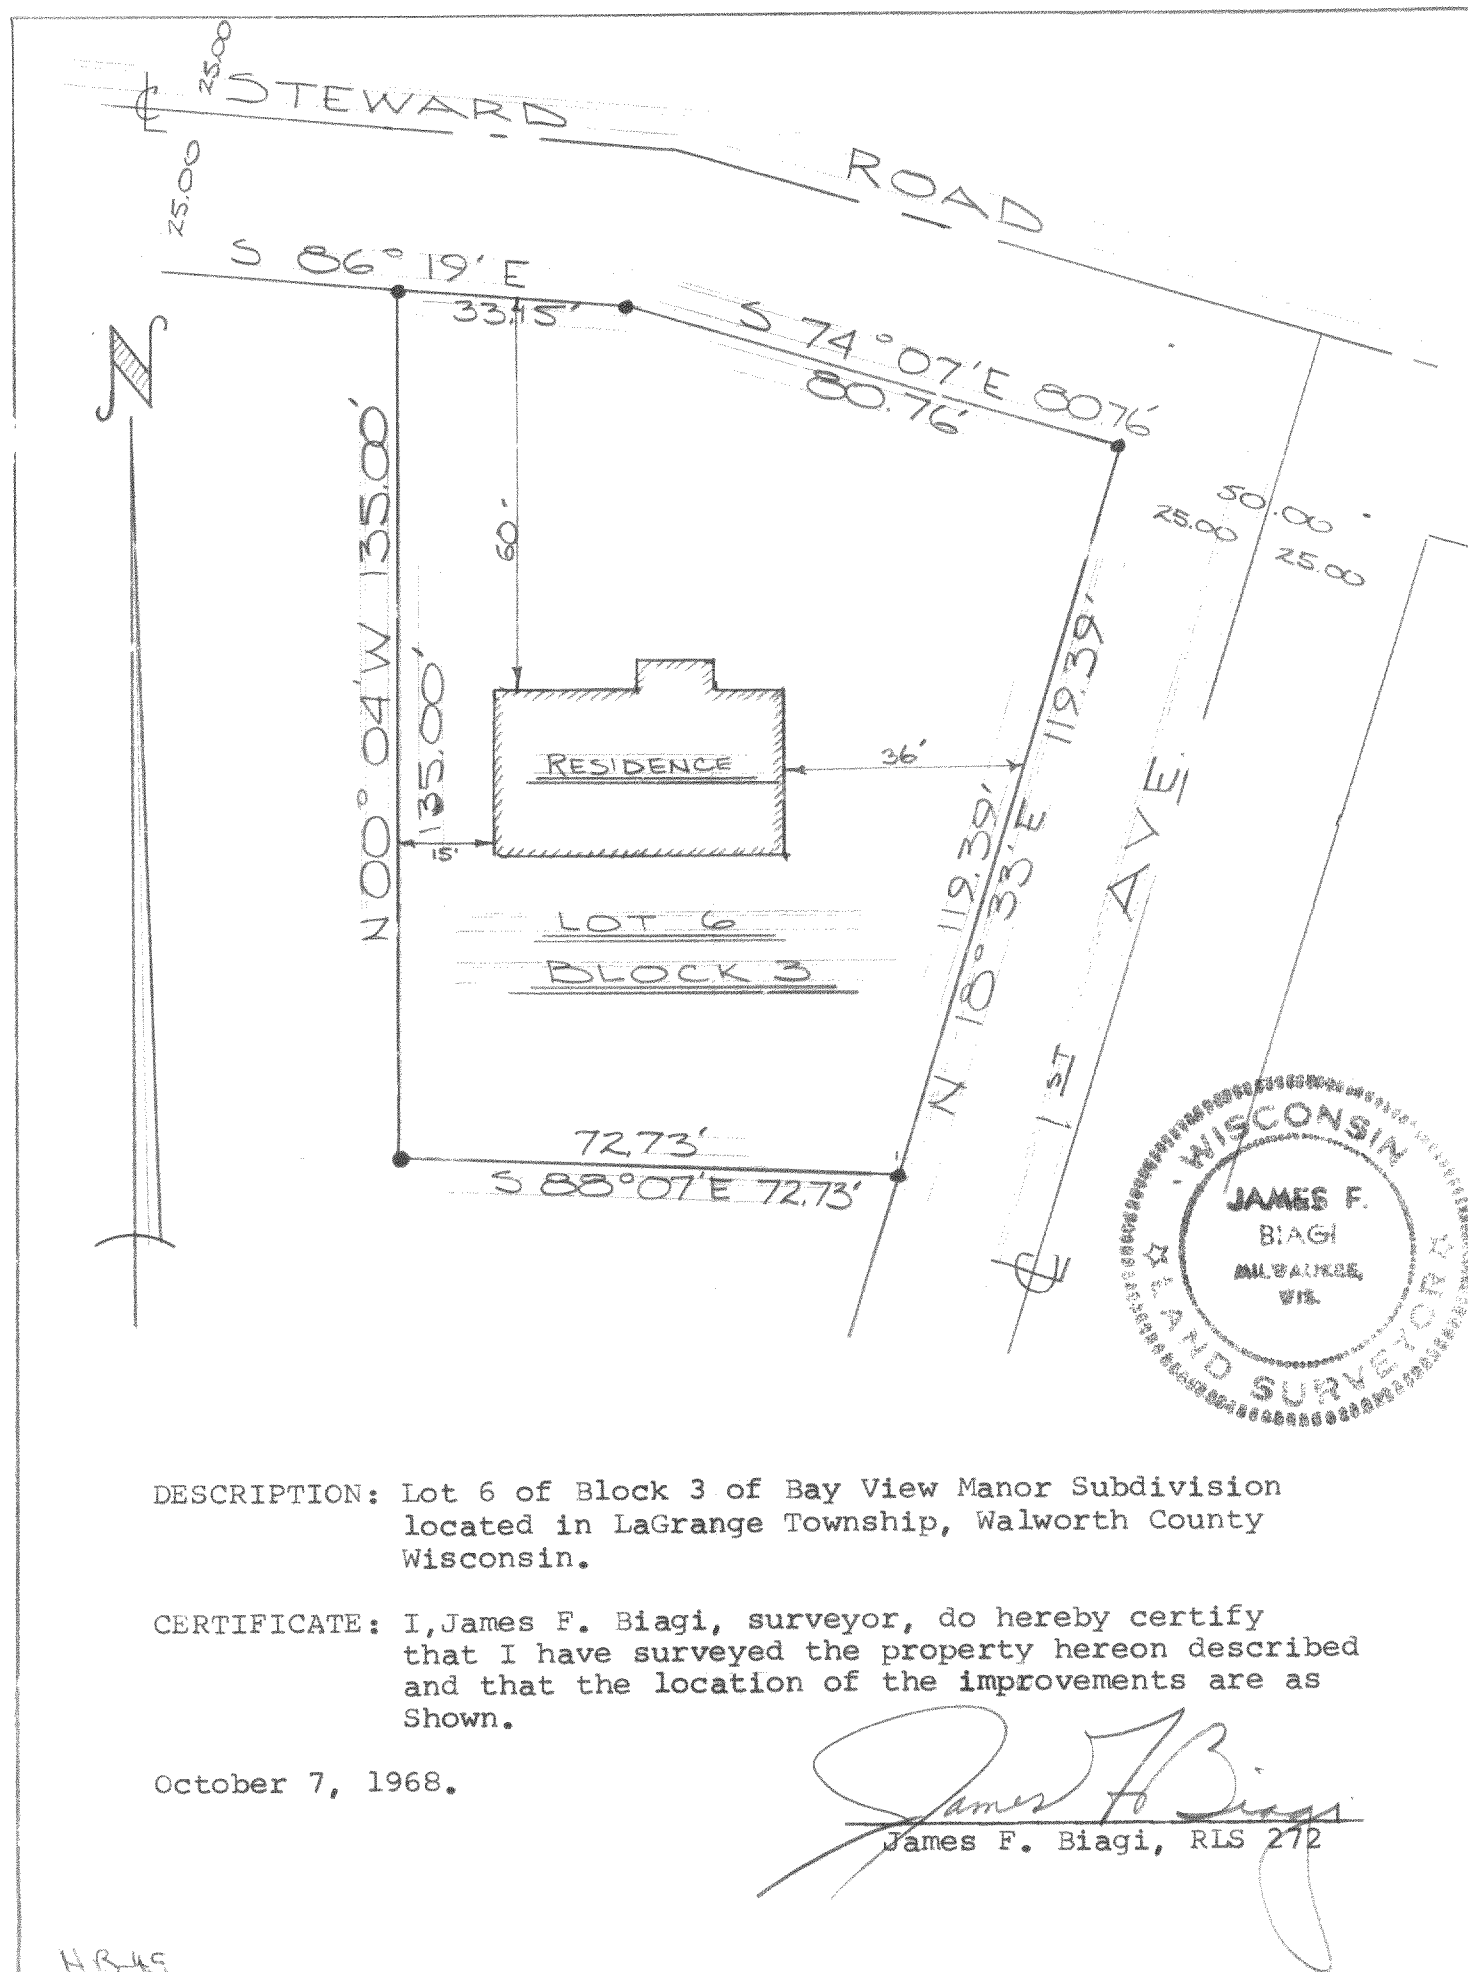

DESCRIPTION: Lot 6 of Block 3 of Bay View Manor Subdivision located in LaGrange Township, Walworth County Wisconsin.

CERTIFICATE: I, James F. Biagi, surveyor, do hereby certify that I have surveyed the property hereon described and that the location of the improvements are as Shown.

October 7, 1968.

James F. Biagi, RLS 272

H345

416-1693