

ABERNATHY and ASSOCIATES

Kenneth B. Abernathy Jr.

Wisconsin Registered Land Surveyor S-1594

Rt. 3, Box 273
Elkhorn, Wisconsin 53121
Phone: (414) 723 4260 (office)
(414) 723 7209 (FAX)

PLAT OF SURVEY

Lot 5 of Block 1 of Pebble Beach Subdivision,
located in part of the Northwest 1/4 of
Section 25, Town 4 North, Range 16 East, Town of
La Grange, County of Walworth, State of Wisconsin.

Owners: David & Ruth Hilt
21340 West Douglas Lane
Plainfield, IL 60544

B
L
O
C
K

Lot 6


United States Highway "12"

66' wide

Lot 5
0.58 Acres ±


EXISTING
FOUNDATION
LOCATED 8/27/01

Meadow Lane

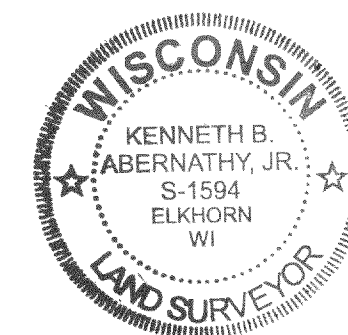

Legend

- FOUND IRON PIPE
- FOUND IRON ROD
- FOUND BRASS CAPPED MONUMENT
- FOUND CONCRETE MONUMENT
- CHISEL CUT IN CONCRETE
- SET IRON ROD, 24" LONG, WEIGHING 1.5 LBS., LINEAL FT. 3/4" DIA.
- SET IRON ROD, 30" LONG, WEIGHING 4.5 LBS., LINEAL FT. 1 1/16" DIA.
- RECORDED AS DIMENSION
- EXISTING FENCE

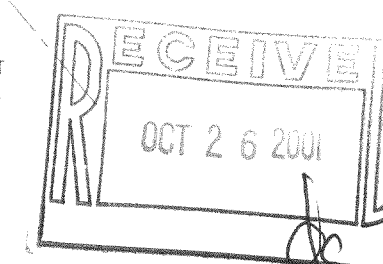

SCALE: 1" = 20 FEET

Lot 4

REVISED 6/20/01 TO SHOW
PROPOSED RESIDENCE

REVISED 8/30/01 TO SHOW
EXISTING FOUNDATION

I hereby certify that the above described property has been surveyed
by me in under my direction and that the above map is a true
representation thereof and shows the size and location of the property, its
exterior boundaries, the location of all visible structures and dimensions of
all principal buildings thereon, boundary fences, apparent easements,
roadways and visible encroachments, if any.

This survey is made for the use of the present owners of the property,
and also those who purchase, mortgage, or guarantee the title thereto within
one year from date hereof.

Kenneth B. Abernathy, Jr.

KENNETH B. ABERNATHY, JR.
WISCONSIN REGISTERED LAND SURVEYOR,
S-1594

Date: May 31, 1996 Job No. 1996.515

HPE-51 416-1737