

DESCRIPTION:

Lot 106, 2nd Addition to Bubbling
Springs Subdivision, Section 34,
T4N, R16E, Walworth County, Wisconsin.

CERTIFICATE:

I, James F. Biagi, surveyor, do hereby
certify that I have surveyed the lands
hereon described.

October 26, 1991

James F. Biagi

R.L.S. 272




NBS2-27

Other Copy

173B
416-104

MIDDLE LAKE

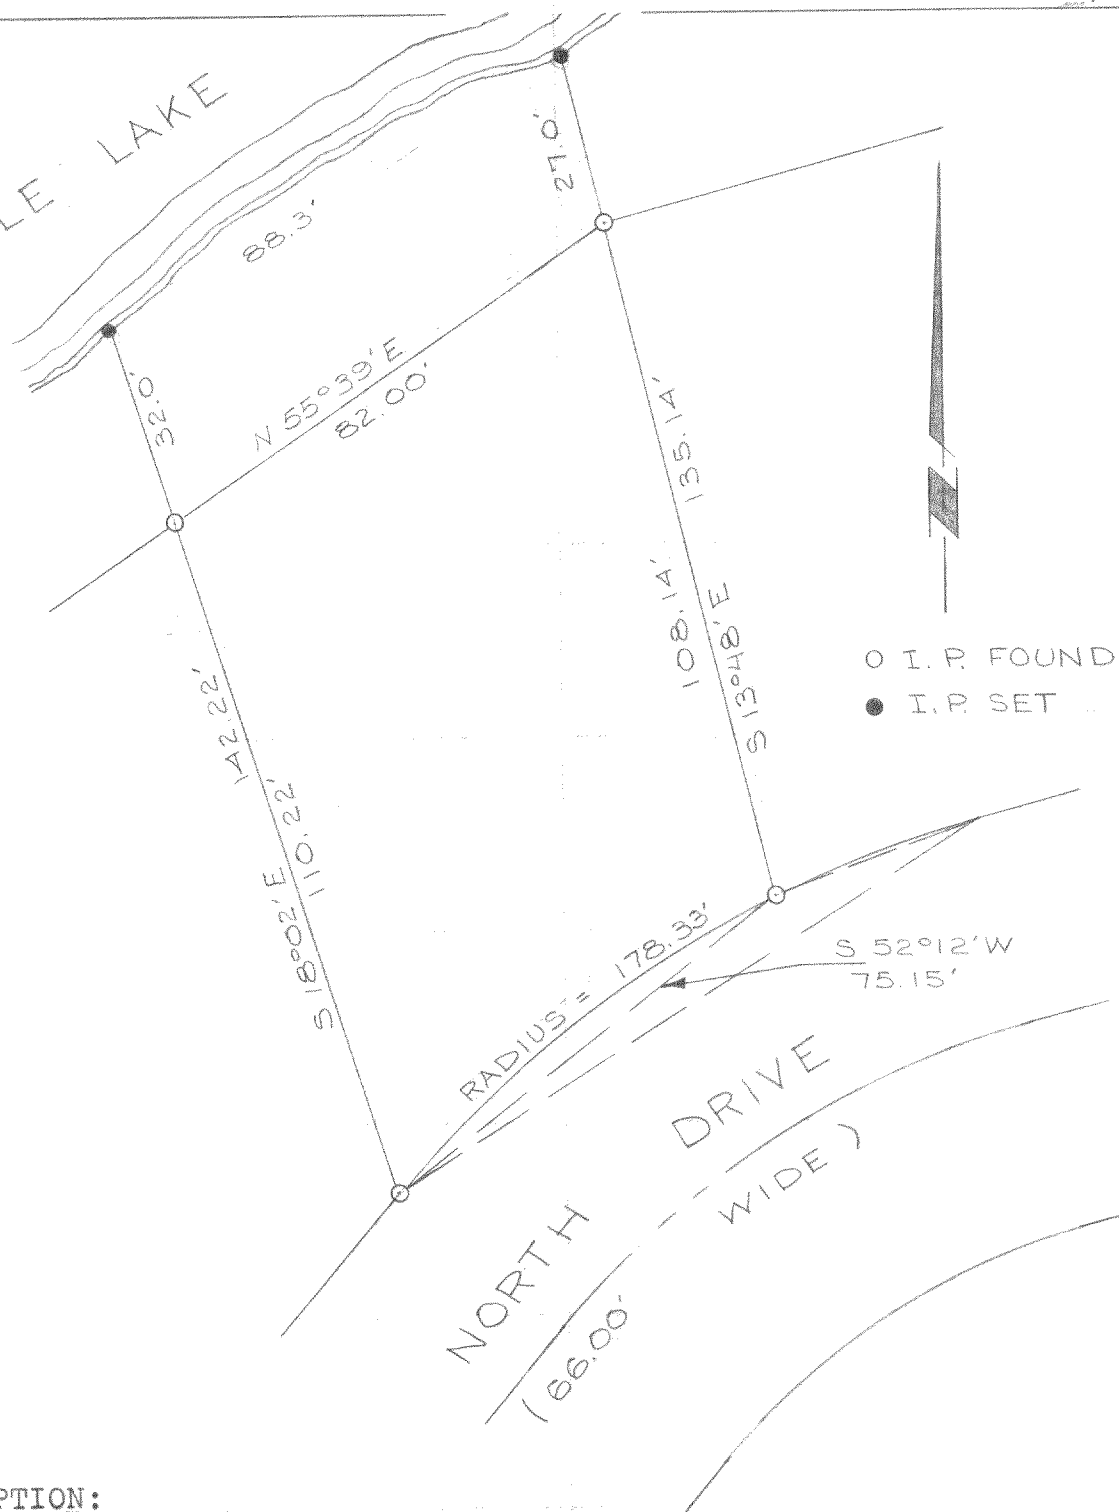DESCRIPTION:

Lot 106, 2nd Addition to Bubbling
Springs Subdivision, Section 34,
T4N, R16E, Walworth County, Wisconsin.


CERTIFICATE:

I, James F. Biagi, surveyor, do hereby
certify that I have surveyed the lands
hereon described.

October 26, 1971

James F. Biagi

R.L.S. 272

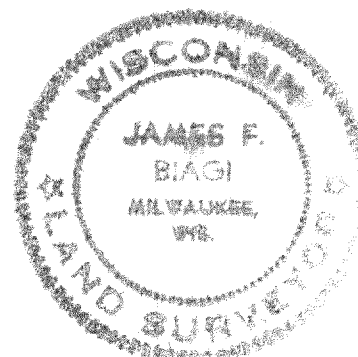

416-473B