



-OF-

SURVEY FOR: HACKBARTH BUILDERS


ROBERT J. WETZEL S-1778

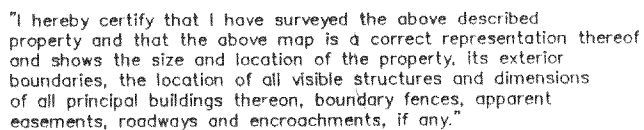

"This survey is made for the use of the present owners of the property, and those who purchase, mortgage, or guarantee the title thereto within one year from date hereof."

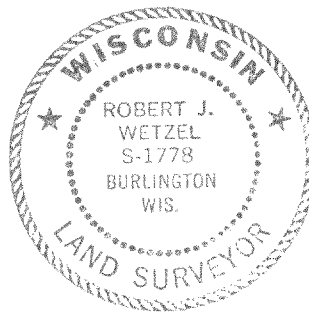

THIS IS NOT AN ORIGINAL PRINT
UNLESS THIS SEAL IS RED.

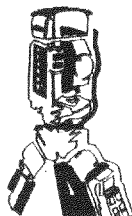

412 N. PINE STREET
BURLINGTON, WI 53105
(262)-767-0225

Robert J. Wetzel
ROBERT J. WEITZEL S-1778

NOVEMBER 30, 2001

5235
JOB NUMBER

416-1753 / HMH-107