


PLAT OF SURVEY

OF

Lot 18, Block 3 of CARSWELLS PARK, being a subdivision of part of the Southwest Quarter of Section 25, part of the Southeast Quarter of Section 26, part of the Northeast Quarter of Section 35 and part of the Northwest Quarter of Section 36, all in Town 4 North, Range 16 East of the 4th Principal Meridian, Town of LaGrange, Walworth County, Wisconsin.

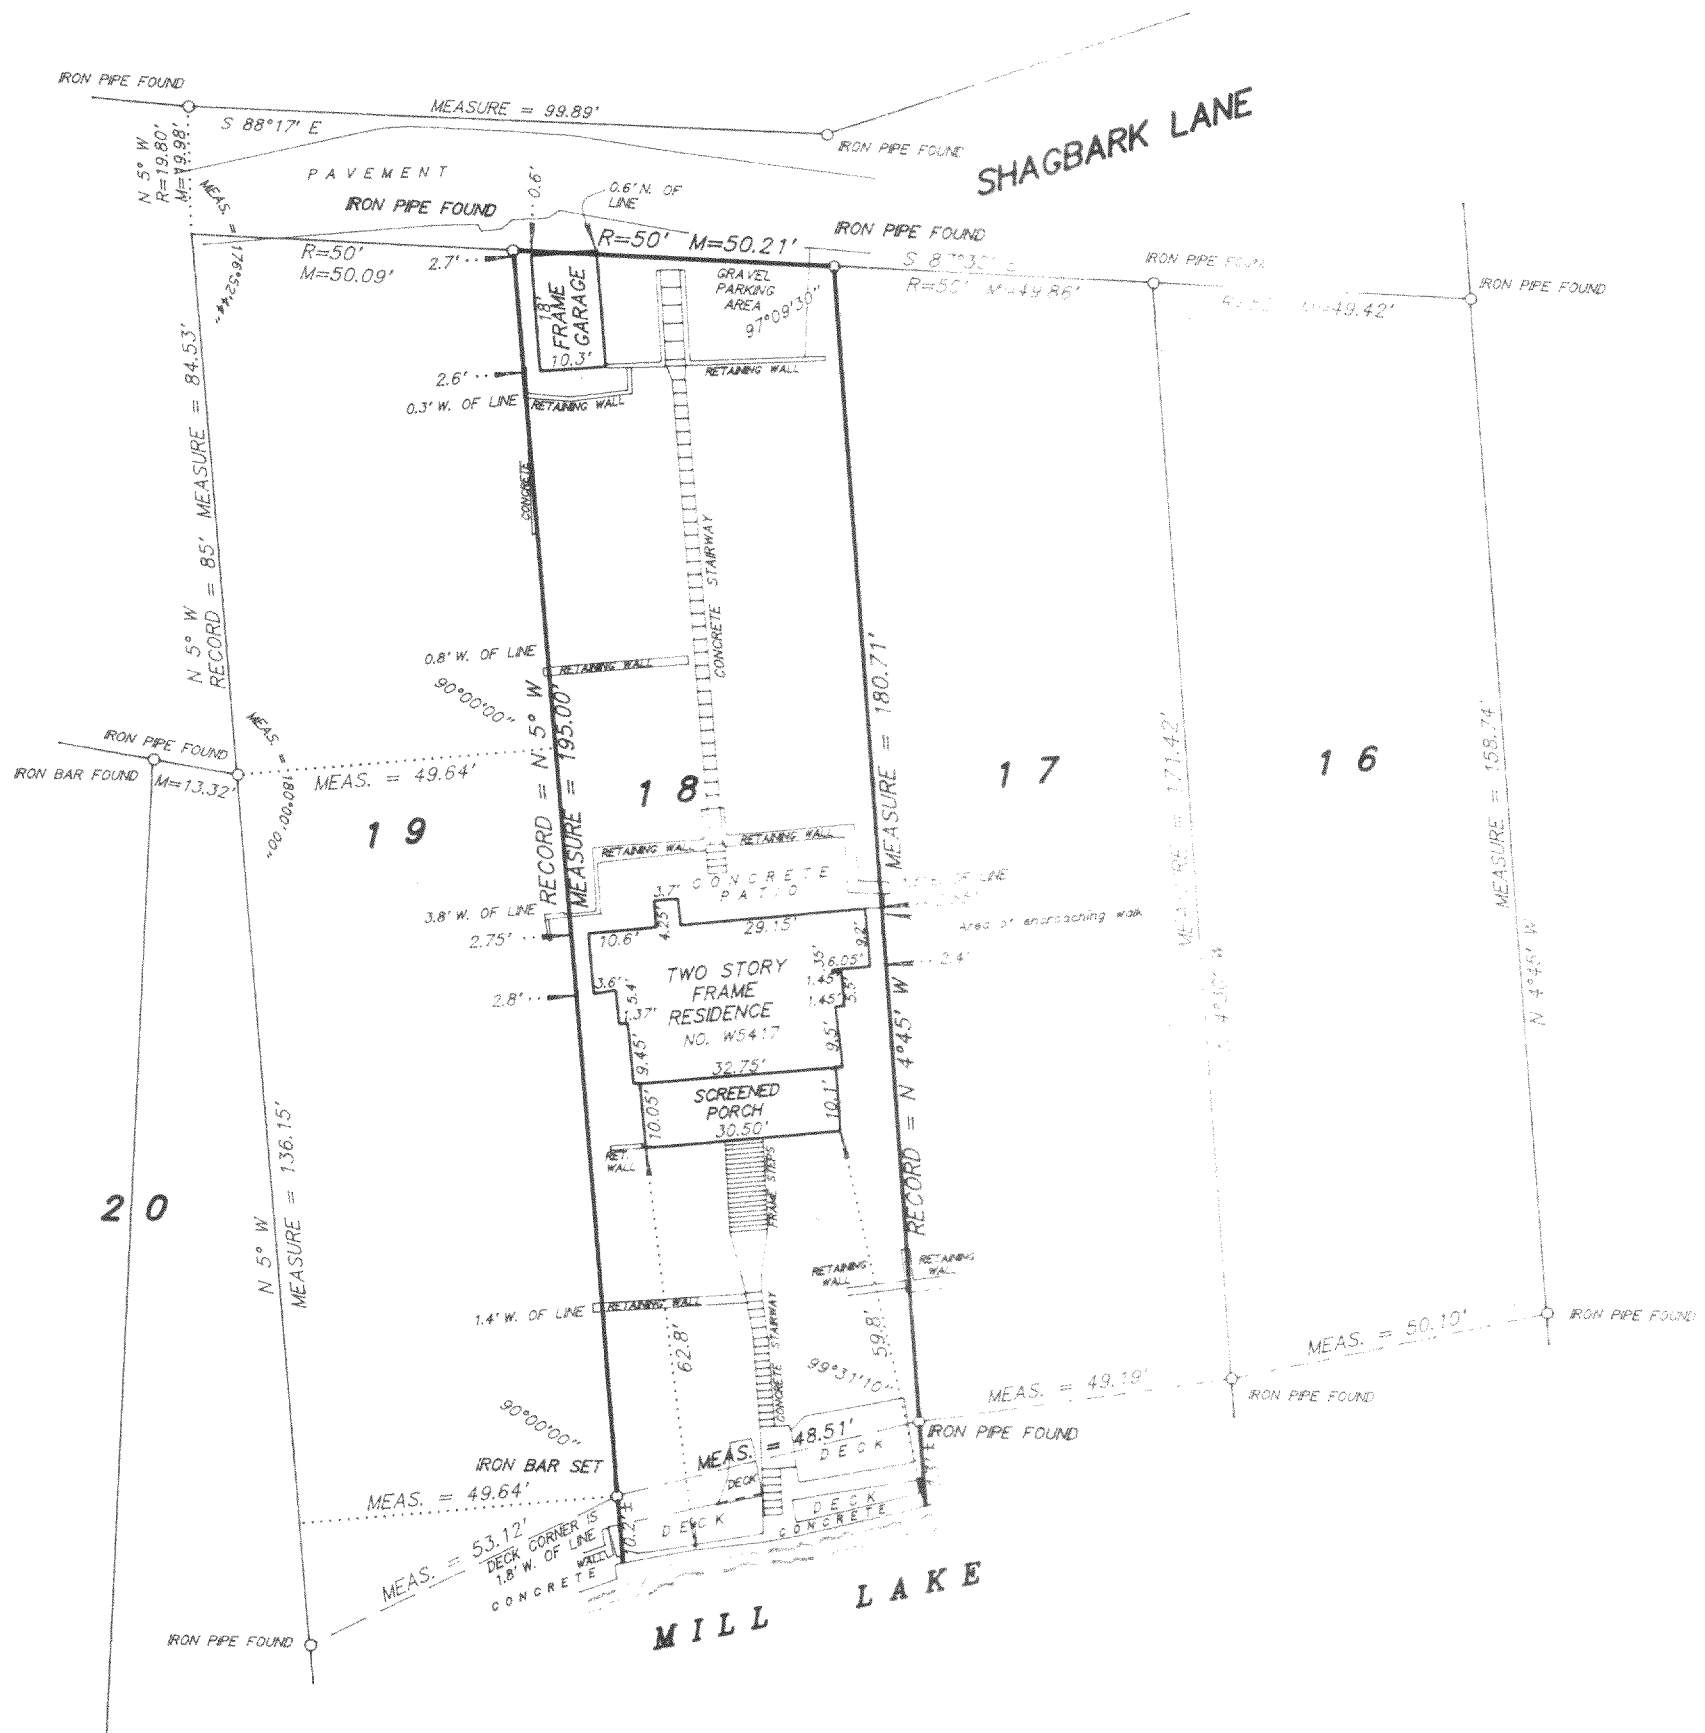

NOTE:

Retaining walls are all concrete. Only visible portions of the retaining walls are shown.
Not all retaining walls may be shown due to being in disrepair and earth or leave covered.
There is a concrete walk along east side of residence that is encroaching onto Lot 17 before it bents around to the rear of the residence.



SCALE 1 inch = 30 feet

ORDERED BY D. Pierce / A. R. Pierce & Associates


JOB NO. 01301

I hereby certify that I have surveyed the above described property and the above plat is a true representation thereof and shows the size and location of the property, its exterior boundaries, the location and dimensions of all visible structures thereon, boundary fences, apparent easements and roadways and visible encroachments, if any.

This survey is made for the exclusive use of the present owners of the property, and also those who purchase, mortgage, or guarantee the title thereto within one year from the date hereof.

Dated at Bassett, Wisconsin this _____ day of _____, 2001.

Mark A. Bolender
Wisconsin Registered Land Surveyor S - 1784

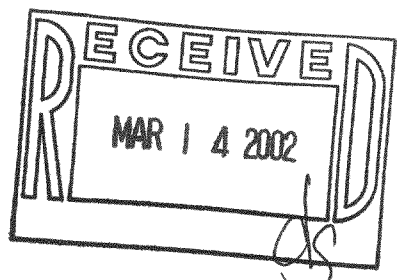

HCA-38
416-1759