

TELETYPE POST 18AE.10E-12X18

LAUDERDALE

LAKE



LEGEND

- - IRON PIPE FOUND
- - IRON PIPE SET
- 2"x30" 3.65 LBS./LN. FT.

SCALE: 1"=30 FT.


REVISIONS			ROBERT BARTON SURVEY LOT 6 STRAWBERRY BANKE		
NO.	DATE	BY			
1					
2					
3					
4			DRAWN BY	SCALE	MATERIAL
5			CHK'D	DATE	DRAWING NO.
			TRACED	APP'D	

DESCRIPTION:

LOT 6, STRAWBERRY BANKE SUB-DIVISION, LOCATED IN SECTION 36 T.4N, R.16E, WALWORTH COUNTY, WISC.

Hsf-46

CERTIFICATE:
I, JOSEPH M. BIAGI, SURVEYOR, DO
HEREBY CERTIFY THAT I HAVE
SURVEYED THE PROPERTY HEREON
DESCRIBED.

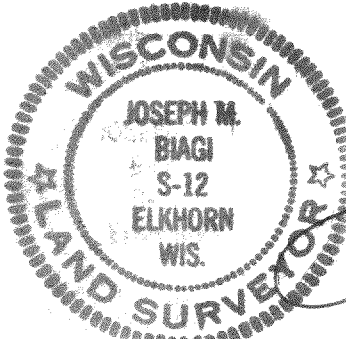

Joseph M. Biagi
JOSEPH M. BIAGI RLS #12
ELKHORN, WISCONSIN


416-3177

#81-74

TEI FRYNE POST 18AE10E-12X18

LAUDERDALE

LAKE

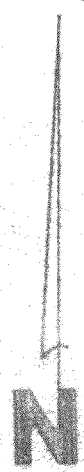


LEGEND
● - IRON PIPE FOUND
○ - IRON PIPE SET
2"x30" 3.65 LBS./LN. FT.
SCALE: 1"=30 FT.

REVISIONS			DRAWN BY JTR		SCALE 1"=30'		MATERIAL	
NO.	DATE	BY						
1			LOT 6 STRAWBERRY BANKE		DATE 7-24-74		DRAWING NO. 81-74	
2								
3								
4								
5			ROBERT BARTELOU SURVEY		APPD			
			CHK'D					
			TRACED					

ROAD (76.00' WIDE)
PLANTATION

CERTIFICATE:
I, JOSEPH M. BIAGI, SURVEYOR, DO
HEREBY CERTIFY THAT I HAVE
SURVEYED THE PROPERTY HEREON
DESCRIBED.

DESCRIPTION:
LOT 6, STRAWBERRY BANKE SUB-
DIVISION, LOCATED IN SECTION 36
T4N, R16E, WALWORTH COUNTY, WISC.

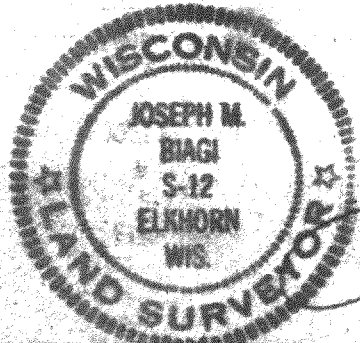

Joseph M. Biagi
JOSEPH M. BIAGI R/S #12
ELKHORN, WISCONSIN

#1-18#

U11-177