




Plat of Survey

Survey For: DONNA HAND
Location: N8925 TAMARACK ROAD, TOWN OF LAGRANGE, WALWORTH COUNTY
Description: LOT 4, OF CERTIFIED SURVEY MAP No. 3282, RECORDED DECEMBER 22, 2000 IN VOLUME 18 OF
CERTIFIED SURVEYS, ON PAGE 210 AS DOCUMENT No. 458544, AND LOCATED IN THE SW 1/4 OF SECTION 11
AND THE SE 1/4 OF SECTION 10, T4N, R16E, TOWN OF LAGRANGE, WALWORTH COUNTY, WISCONSIN.
SUBJECT TO ALL RIGHTS, RESERVATIONS, RESTRICTIVE COVENANTS, AND EASEMENTS OF RECORD.

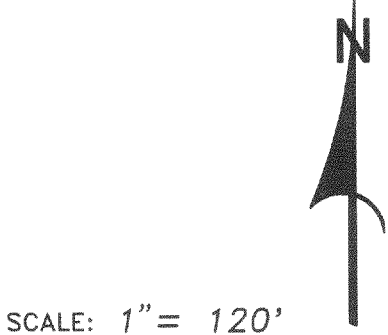


NOTES:

- 1) INTERIOR FENCE LINES AND FENCE REMNANTS ARE NOT SHOWN ON THIS SURVEY.
- 2) PARCEL SUBJECT TO A MANAGED FOREST LAND PETITION, ORDER NUMBER 65 033 1994 OWNER ADVISED TO CONTACT THE DEPARTMENT OF NATURAL RESOURCES, FOR FURTHER INFORMATION.
- 3) THE WILDLIFE EASEMENT AREA IS SUBJECT TO ALL RIGHTS, RESERVATIONS, RESTRICTIVE COVENANTS AND PROVISIONS, THAT ARE RECORDED IN THE WILDLIFE HABITAT RESTORATION EASEMENT, AS RECORDED IN VOLUME 676 ON PAGE 8432 AS DOCUMENT NUMBER 461770.

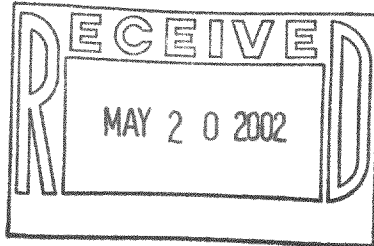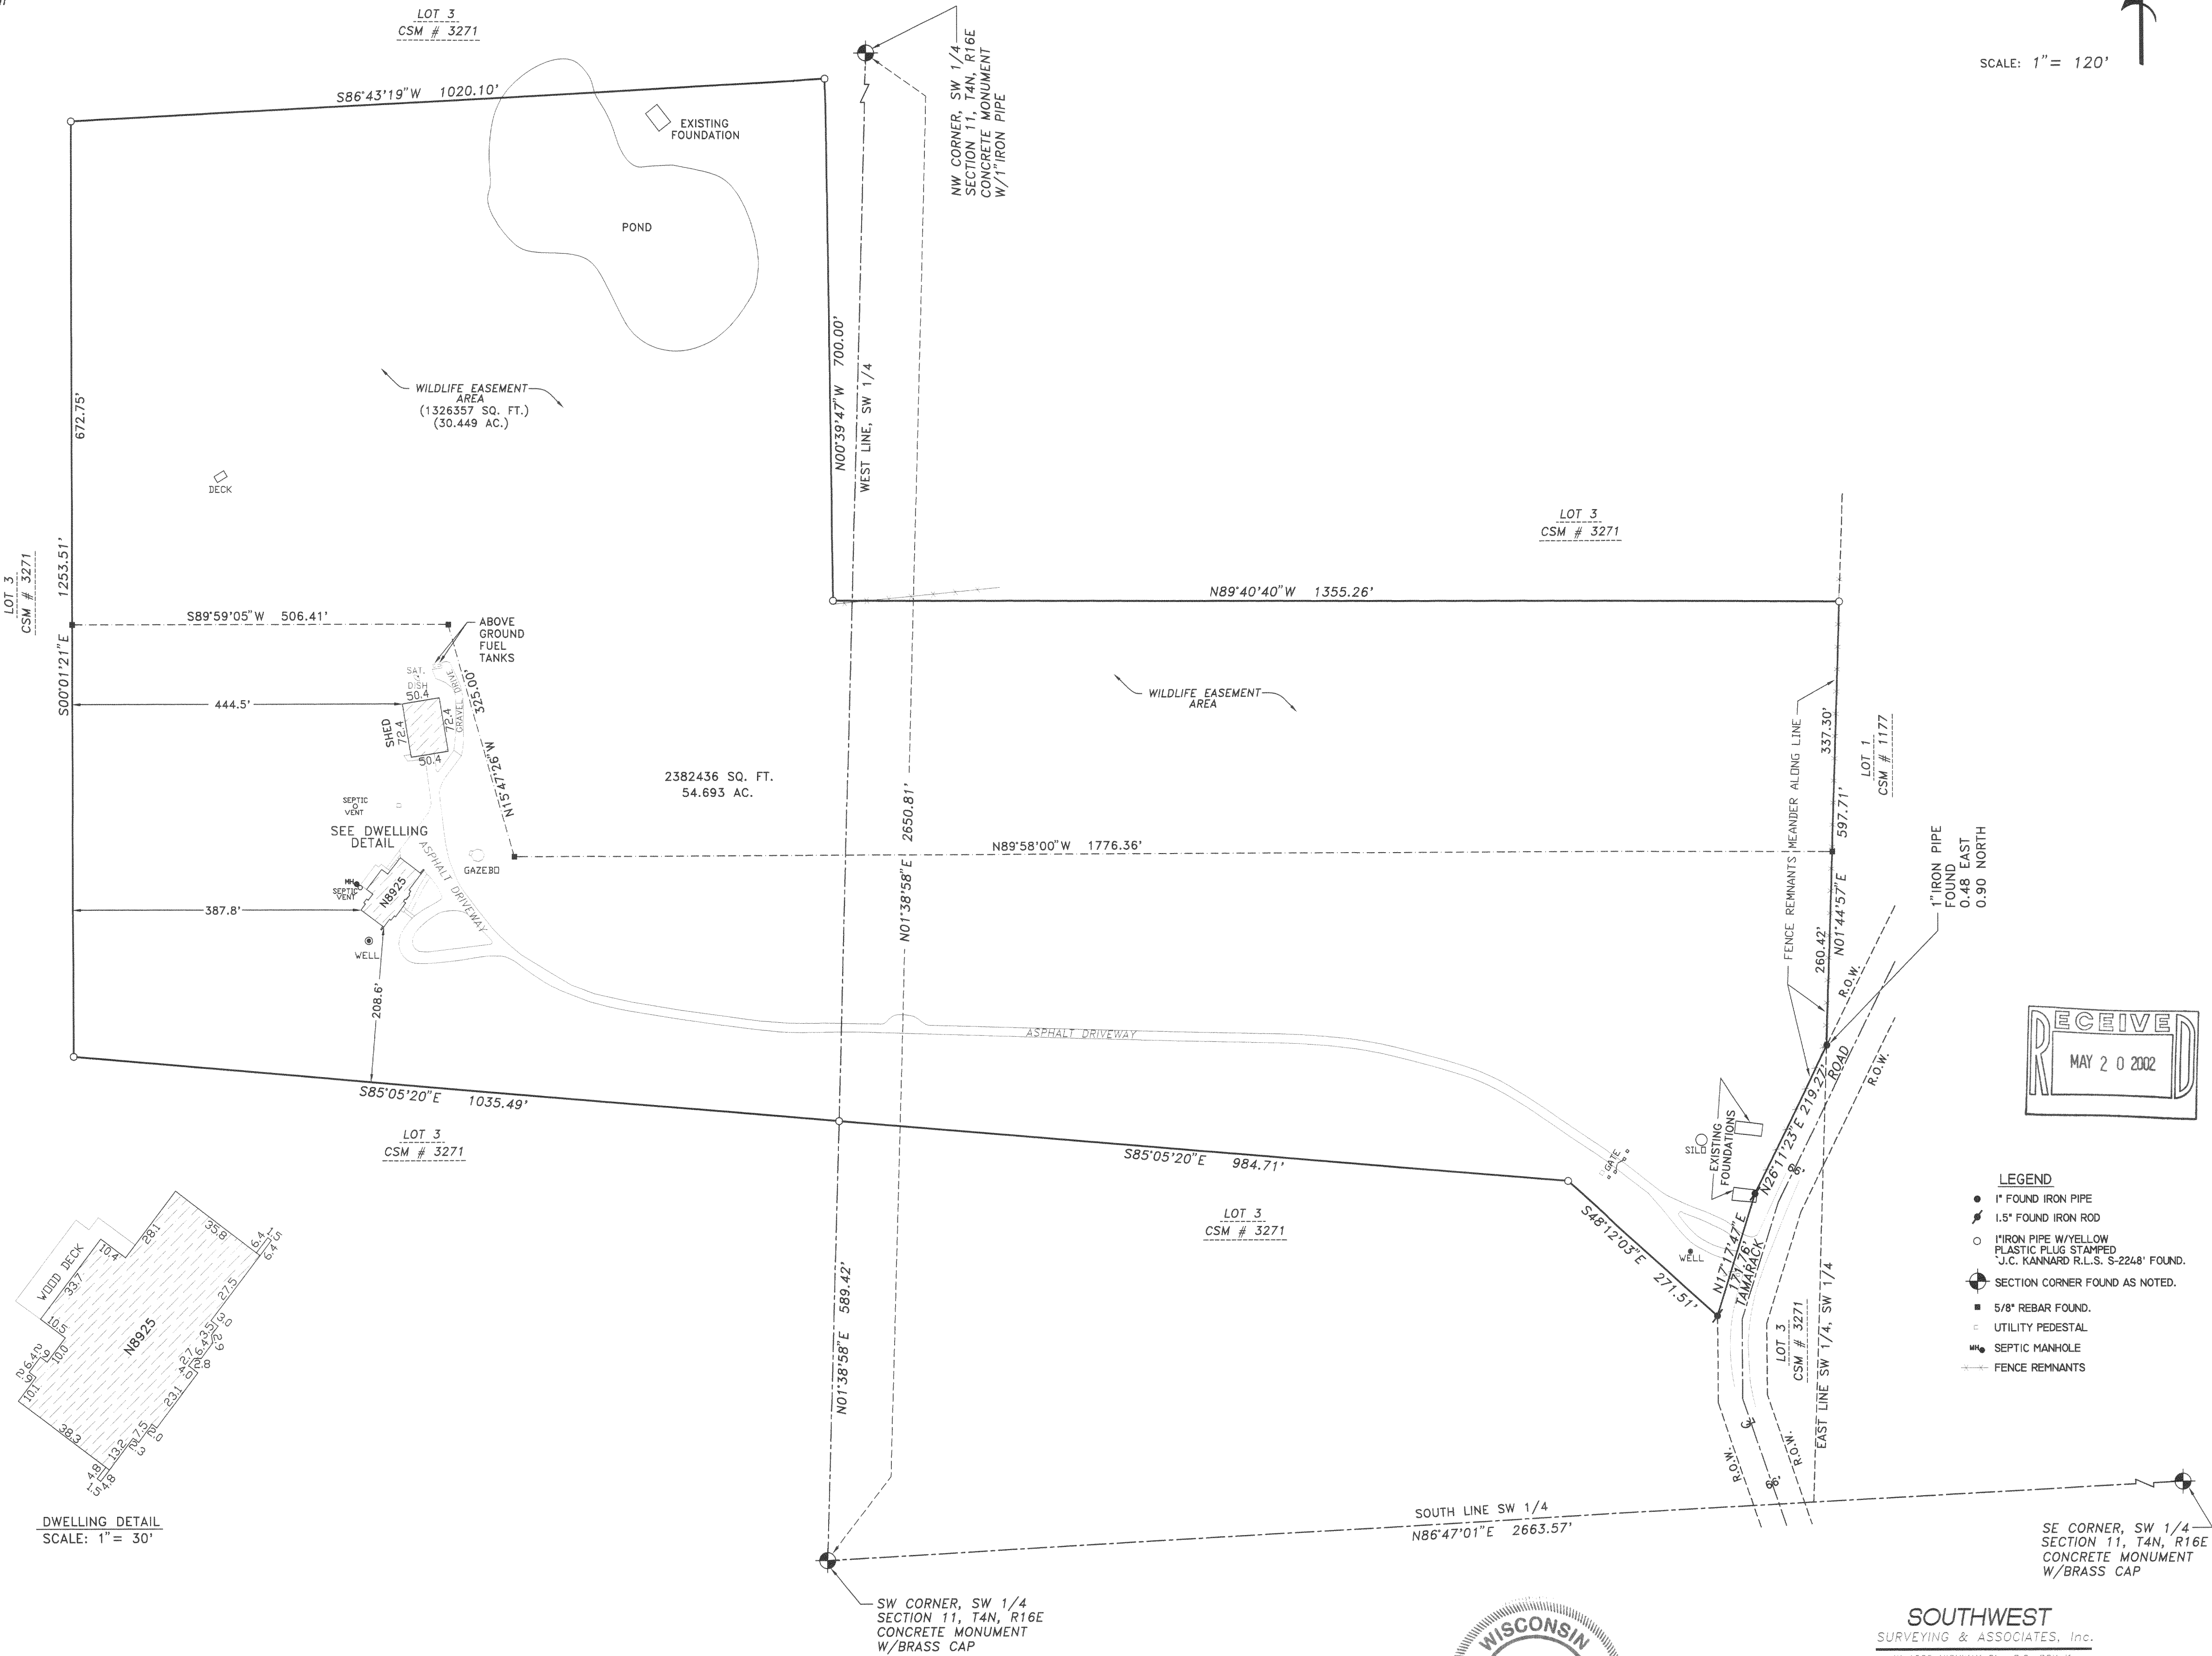

- LEGEND
- 1" FOUND IRON PIPE
 - ⚡ 1.5" FOUND IRON ROD
 - IRON PIPE W/YELLOW PLASTIC PLUG STAMPED J.C. KANNARD R.L.S. S-2248 FOUND.
 - ⊙ SECTION CORNER FOUND AS NOTED.
 - 5/8" REBAR FOUND.
 - UTILITY PEDESTAL
 - ⊕ SEPTIC MANHOLE
 - FENCE REMNANTS

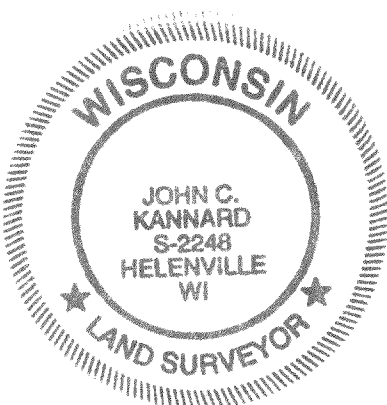

SOUTHWEST
SURVEYING & ASSOCIATES, Inc.
W 1065 HIGHWAY CL, P.O. BOX K
PALMYRA, WI 53156
262-495-4910

State of Wisconsin) ss I certify that I have surveyed the above described (property) and the above map is a true representation thereof and shows the size and location of the Property, its exterior boundaries, the location and dimensions of all visible structures thereon, fences, apparent easements and roadways and visible encroachments, if any.

This survey is made for the exclusive use of the present owners of the Property, and also those who purchase, mortgage, or guarantee title thereto within one (1) year hereof.

THIS IS A JOHN C. KANNARD AUTHORIZED PRINT ONLY IF SIGNATURE APPEARS IN RED INK ON BLACK LINE PRINT.

JOHN C. KANNARD, Registered Land Surveyor

SHEET 1 OF 1
DATE: MAY 1, 2002
JOB NO: W-20136A

416-1774
HA-3282-4