


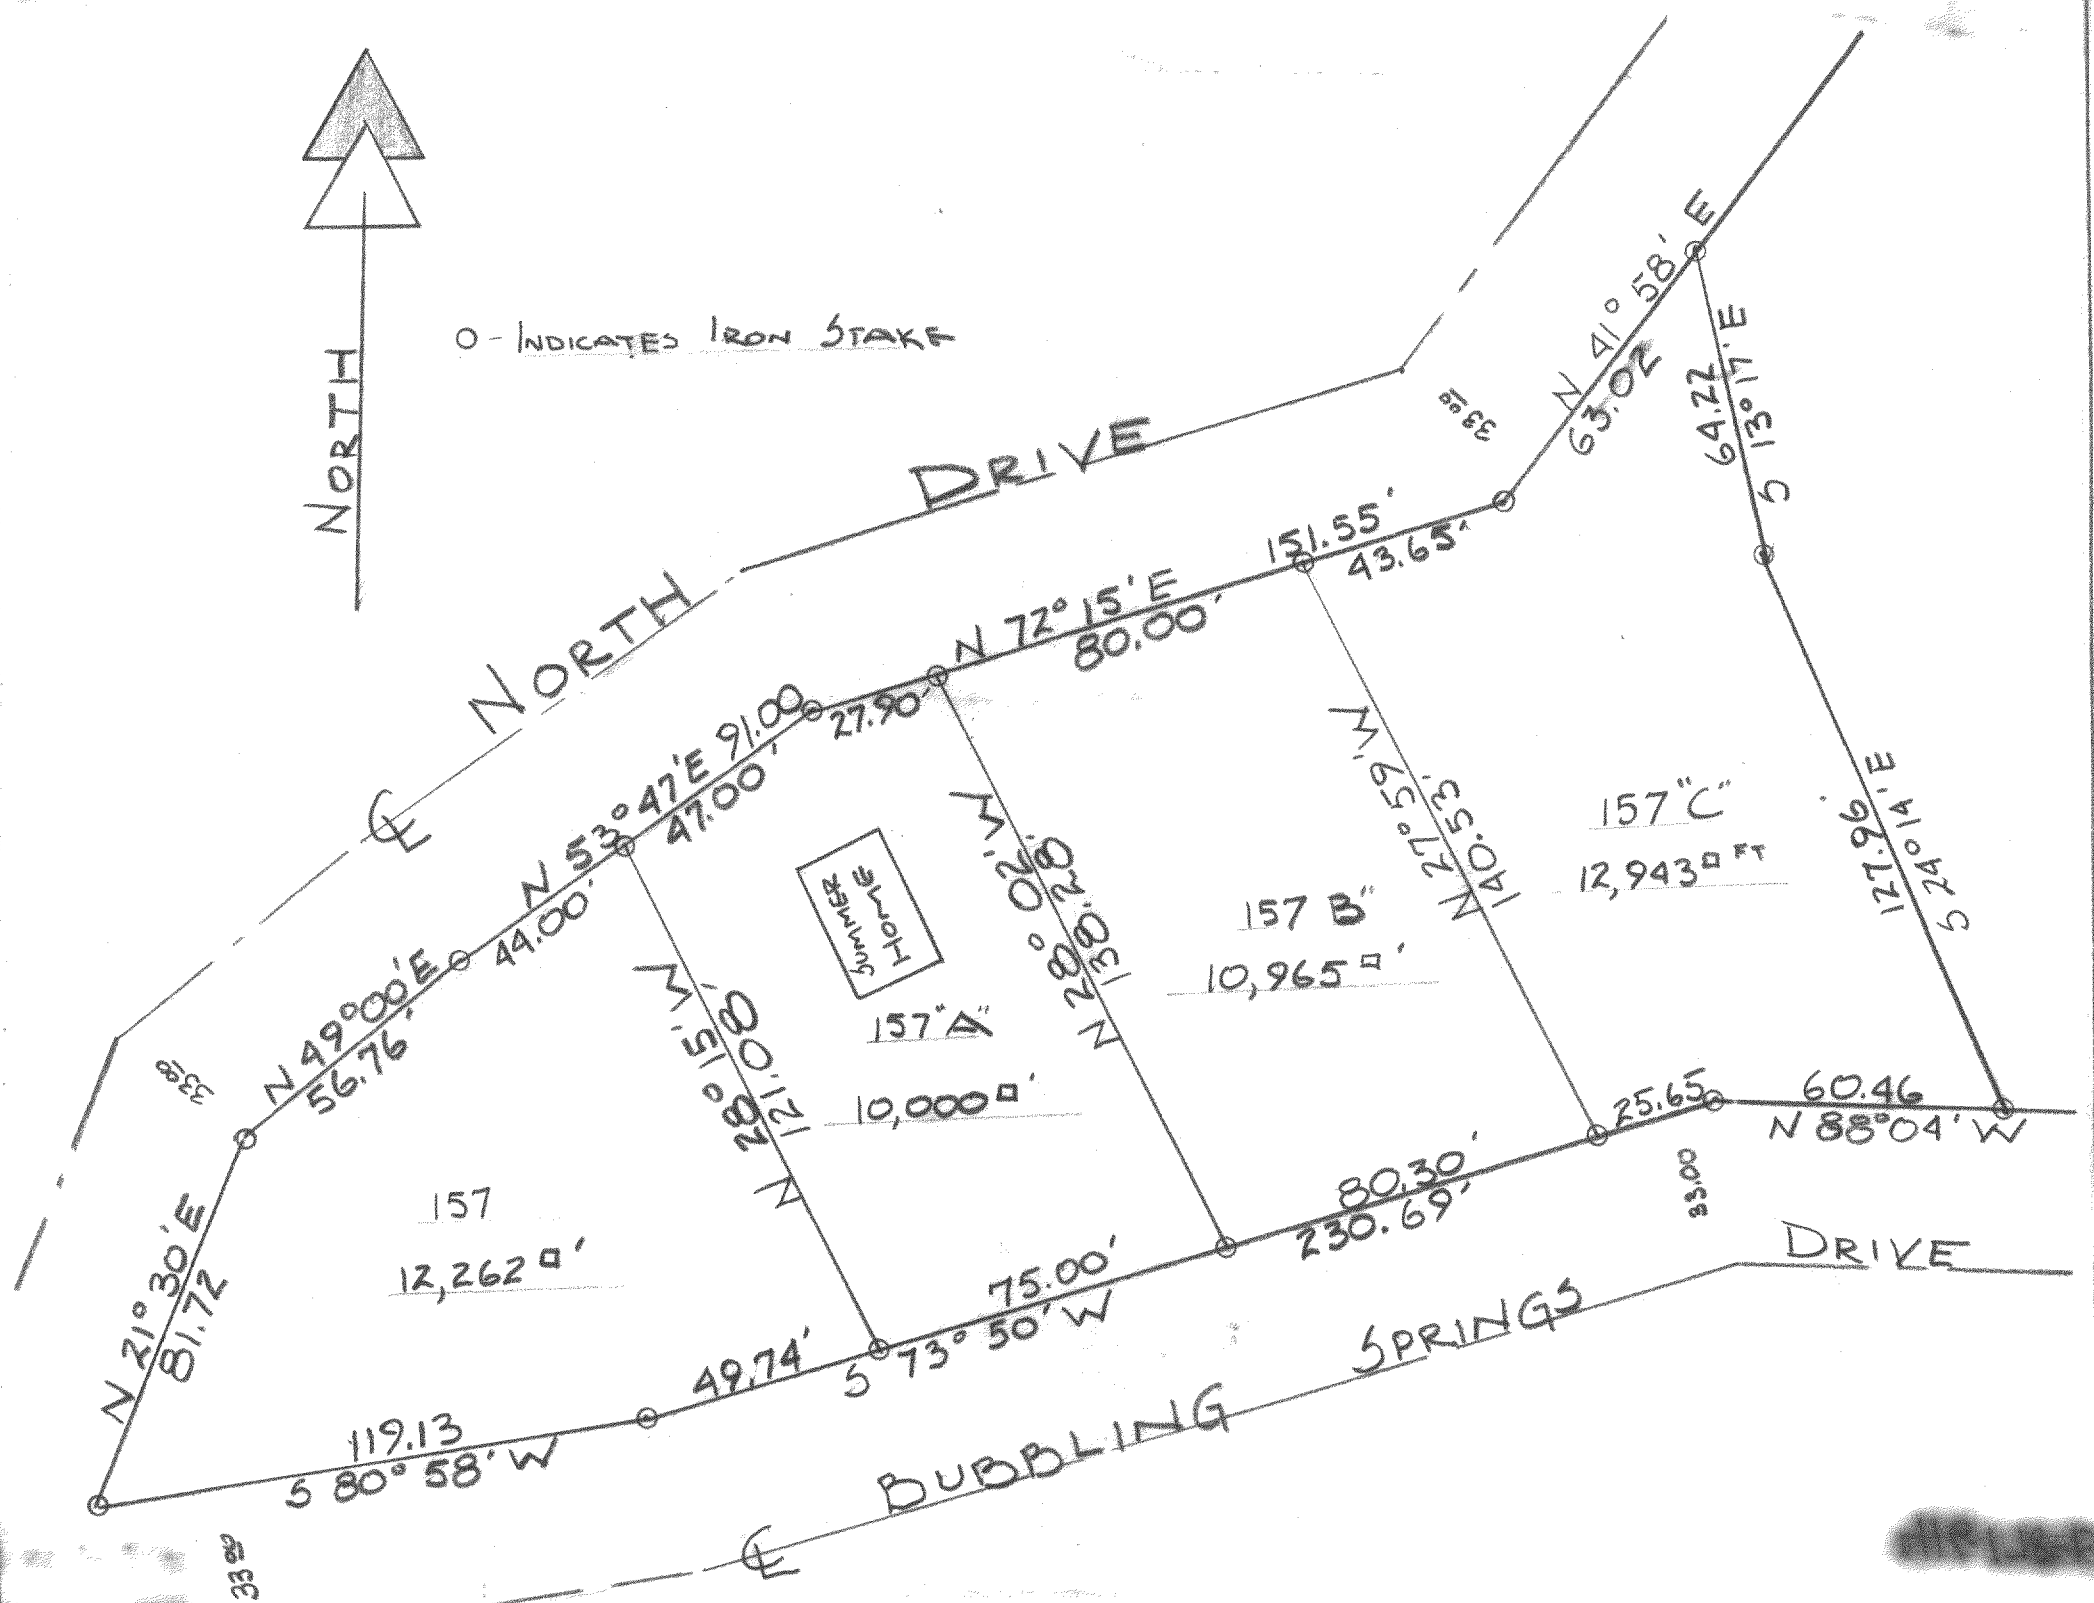

LOT 157

DESCRIPTION: Commencing at the N.E. corner of the intersection of North Drive and Bubbling Springs Drive, said corner being the S.W. lot corner of Large Lot 157 of the 2nd Addition to Bubbling Springs Subd., in Sec. 34 T 4 N., R. 16 E., Walworth County, Wisconsin; thence N. 80° 58' E 119.13 ft. to an iron stake, thence N. 73° 50' E 49.74 ft. to an iron stake, thence N. 28° 15' W. 121.08 ft. to an iron stake, thence S. 53° 47' W 44.00 feet to an iron stake, thence S. 49° 00' W. 56.76 ft. to an iron stake, thence S. 21° 30' W. 81.72 ft. to the place of beginning.

LOT 157 "A"

Commencing at an iron stake that is 119.13 feet N. 80° 58' E of and 49.74 ft. N. 73° 50' E. of the N.E. corner of the intersection of North Drive and Bubbling Springs Drive, said corner being the S.W. lot corner of Large Lot 157 of the 2nd Addition to Bubbling Springs Subd., in Sec. 34 T. 4 N., R. 16 E., Walworth County, Wisconsin; thence N. 73° 50' E 75.00 ft. to an iron stake, thence N. 28° 02' W. 138.28 ft. to an iron stake, thence S. 72° 15' W. 27.90 ft. to an iron stake thence S. 53° 47' W. 47.00 feet to an iron stake, thence S. 28° 15' E. 121.08 ft. to the place of beginning

LOT 157 "B"

Commencing at an iron stake that is 119.13 feet N. 80° 58' E of and 124.74 ft. N. 73° 50' E of the N.E. corner of the intersection of North Drive and Bubbling Springs Drive, said corner being the S.W. lot corner of Large Lot 157 of the 2nd Addition to Bubbling Springs Subd., in Sec. 34 T. 4 N., R. 16 E., Walworth County, Wisconsin; thence N. 53° 50' E. 80.30 ft. to an iron stake thence N. 27° 59' W. 140.53 ft. to an iron stake, thence S. 72° 15' W. 180.00 ft. to an iron stake, thence S. 28° 02' E. 138.28 feet to the place of beginning.

LOT 157 "C"

Commencing at an iron stake that is 119.13 feet N. 80° 58' E. of, and 205.04 ft. N. 73° 50' E. of the N.E. corner of the intersection of North Drive and Bubbling Springs Drive, said corner being the S.W. lot corner of Large Lot 157 of the 2nd Addition to Bubbling Springs Subd., in Sec. 34 T 4 N., R 16 E., Walworth County, Wisconsin; thence N. 73° 50' E 25.65 ft. to an iron stake, thence S. 88° 04' E. 60.46 ft. to an iron stake, thence N. 24° 14' W. 127.96 ft. to an iron stake, N. 13° 17' W. 64.22 ft. to an iron stake, thence S. 41° 58' W. 63.02 ft. to an iron stake, thence S. 72° 15' W. 43.65 ft. to an iron stake, thence S. 27° 59' E. 140.53 ft. to the place of beginning

CERTIFICATE

I, James F. Biagi, surveyor do hereby certify that I have surveyed the property herein described and that the bearings and lengths of the exterior boundaries are as shown on the drawing above.

Signed and Sealed, November 1, 1960

James F. Biagi
James F. Biagi, Surveyor.

416-17818