


**HAROLD H. KOLB**

REGISTERED PROFESSIONAL LAND SURVEYOR  
LAKE GENEVA, WISCONSIN

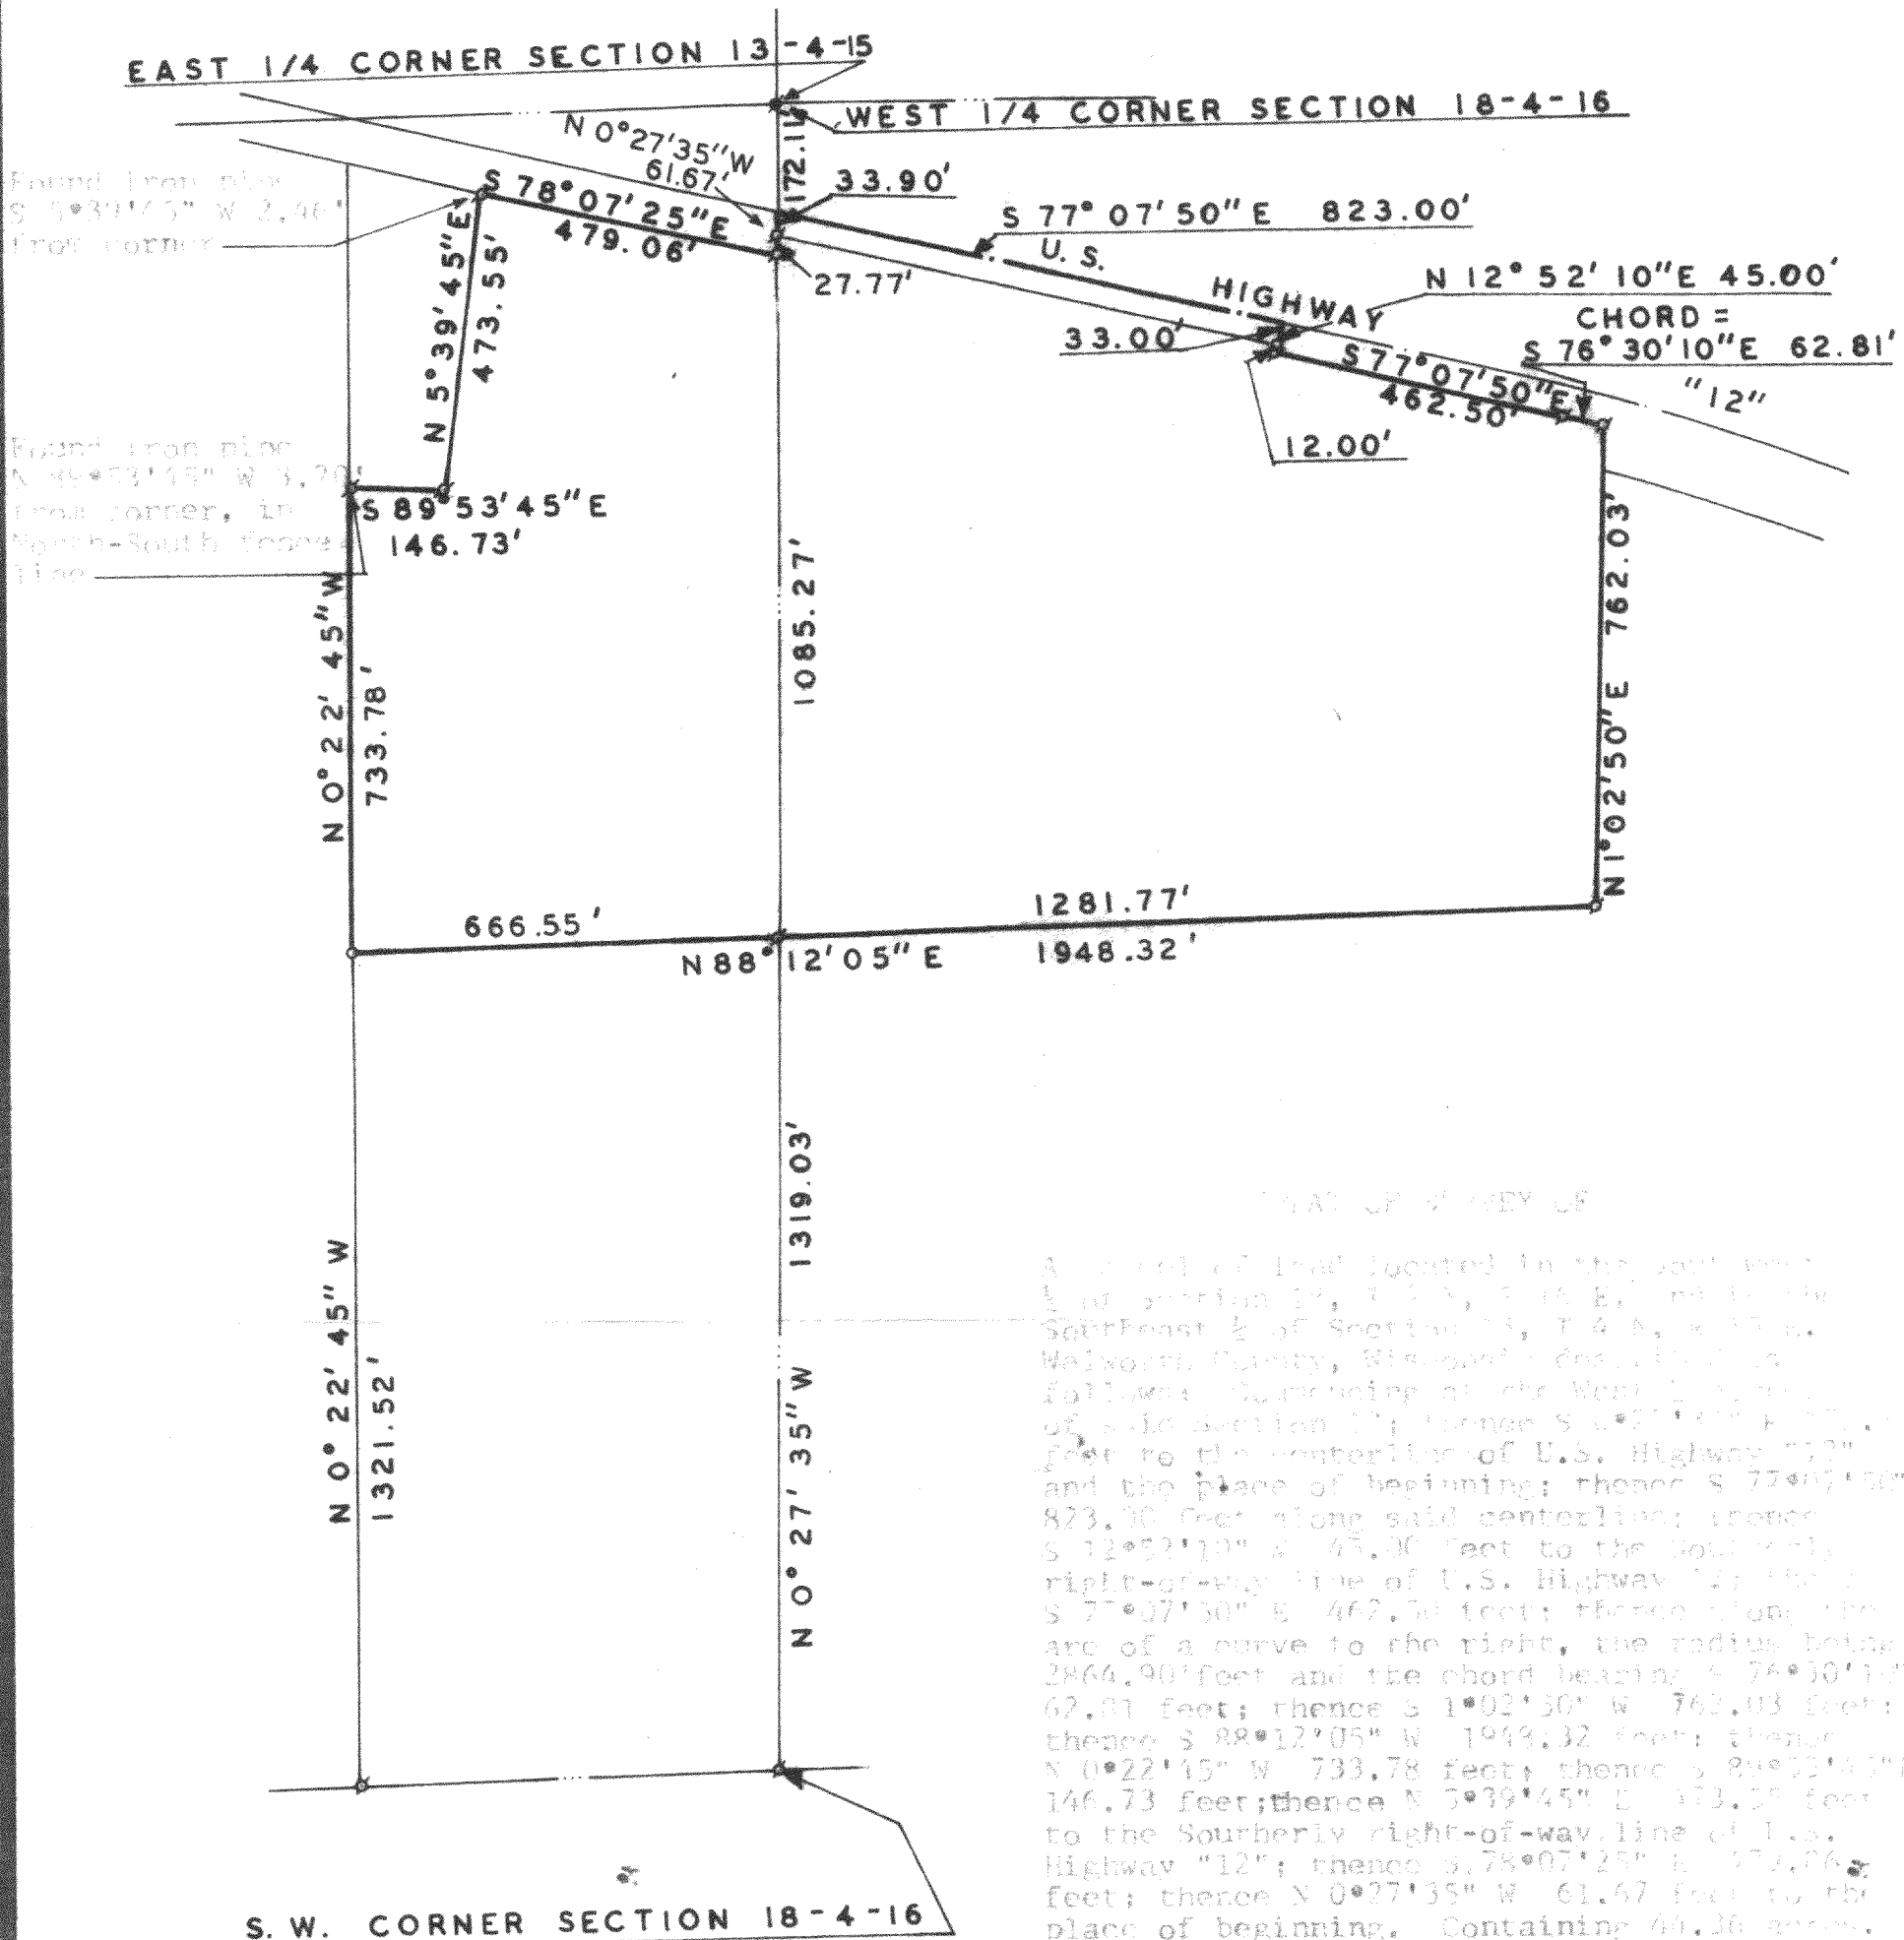

THAT OF THE WAY OF

A parcel of land located in the South West 1/4 of Section 18, T. 4 N., R. 16 E., and in the South East 1/4 of Section 13, T. 4 N., R. 16 E., Walworth County, Wisconsin, containing 40.36 acres, follows: Commencing at the West 1/4 corner of said Section 13; thence S 0°27'35" W 61.67 feet to the centerline of U.S. Highway "12"; and the place of beginning; thence S 77°07'50"E 823.00 feet along said centerline; thence S 12°52'10" E 45.00 feet to the Southerly right-of-way line of U.S. Highway "12"; thence S 77°07'50" E 462.50 feet; thence along the arc of a curve to the right, the radius being 2864.90 feet and the chord bearing S 76°30'10"E 62.81 feet; thence S 1°02'50" W 762.03 feet; thence S 88°12'05" W 1948.32 feet; thence N 0°22'45" W 733.78 feet; thence S 89°53'45" E 146.73 feet; thence N 5°39'45" E 473.55 feet to the Southerly right-of-way line of U.S. Highway "12"; thence S 78°07'25" E 479.06 feet; thence N 0°27'35" W 61.67 feet to the place of beginning. Containing 40.36 acres.


NOTE: The bearing on the West line of Section 18 is assumed.



SCALE: 1" = 300'

**LEGEND**

- — IRON PIPE FOUND
- — IRON PIPE PLACED
- — CONCRETE MONUMENT
- X — SPIKE

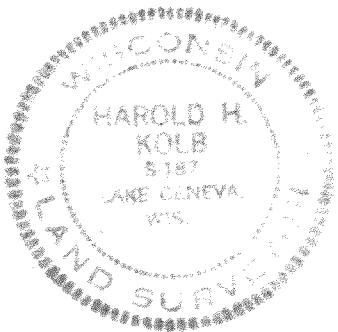

I, HAROLD H. KOLB, DO HEREBY CERTIFY THAT I HAVE SURVEYED THE PROPERTY HEREON DESCRIBED ACCORDING TO THE OFFICIAL RECORDS, AND THAT THE PLAT HEREON IS A CORRECT REPRESENTATION OF THE LOT LINES.

*Harold H. Kolb*  
HAROLD H. KOLB

WISCONSIN REGISTERED LAND SURVEYOR, S-187  
DATE June 18, 1974

LG-18-5B

and W-13-8B

416-179