



Plat of Survey

of
Unit 90 of Lauderdale Shores
a Recreational Vehicle Condominium,
located in the Northwest 1/4 of Section 25, Town 4 North, Range
16 East, Town of LaGrange, Walworth County, Wisconsin.

Vicinity Map

1"=60'


Surveyed for: **Frank Mitilieri**
1232 White Fence Lane
Addison, Illinois 60101

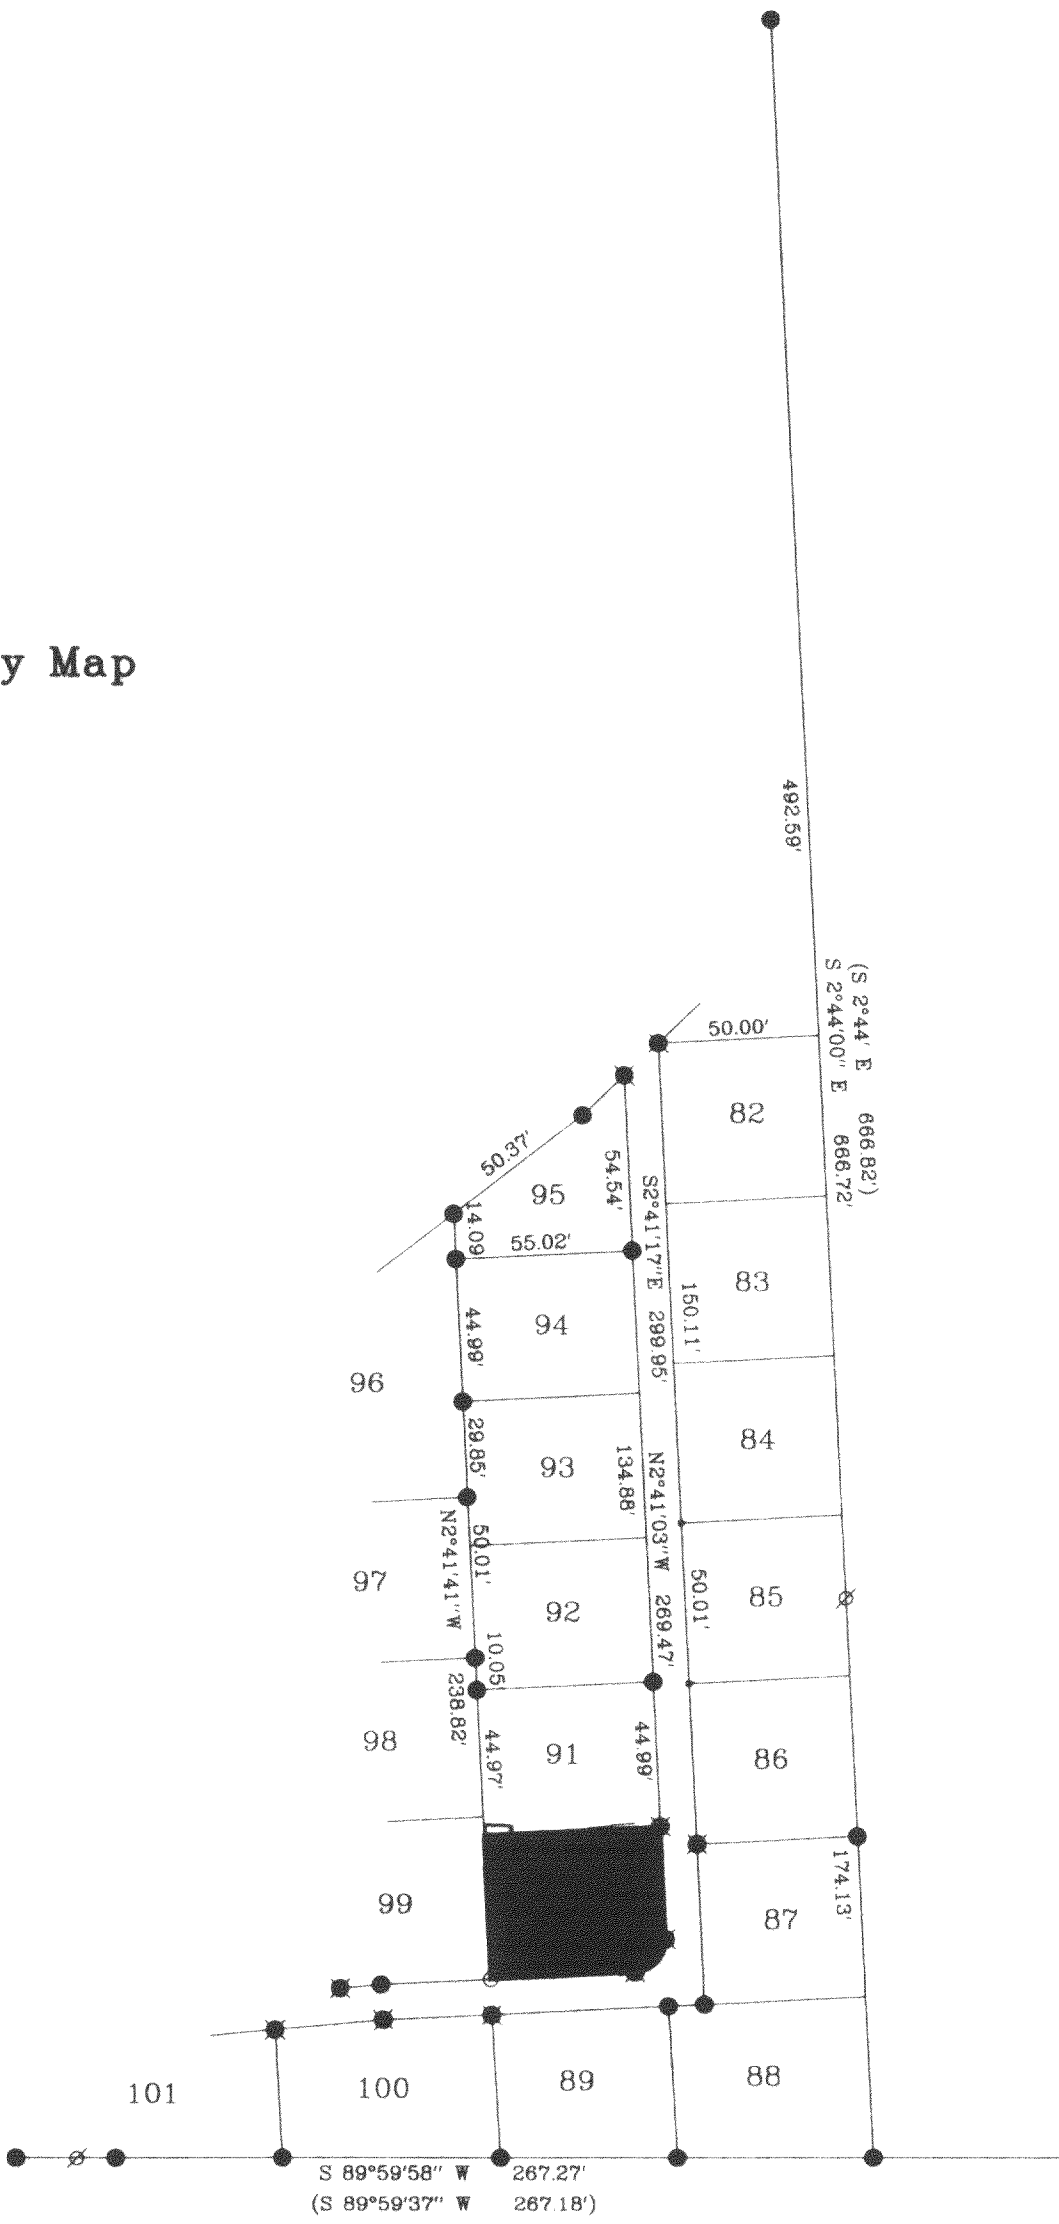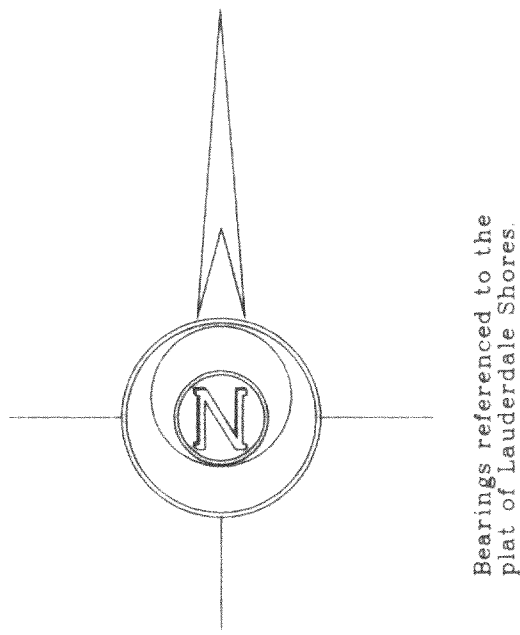

Copyright © 2001 by Jensen & Olson Land Surveying, LLC.


All rights reserved. No part of this survey plat may be reproduced or transmitted in any form by any means - graphic, electronic, or mechanical, including photocopying, tracing, or information storage and retrieval systems - without permission in writing from Douglas G. Olson, Jensen & Olson Land Surveying, LLC.

Notes: 1) This survey plat is not certified unless signed and sealed in red ink.
2) This survey is subject to Wisconsin lien laws. This Plat of Survey is the notice of intent to file lien. Lien waiver required.

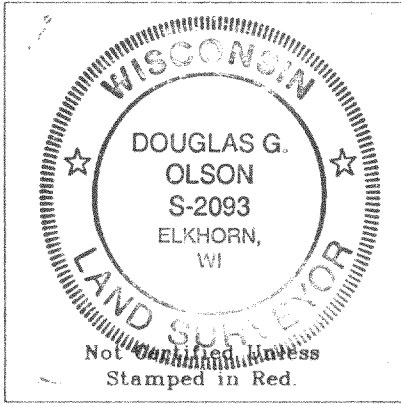

I, Douglas G. Olson, Wisconsin Registered Land Surveyor, do hereby certify that this survey was performed by me or under my direction in full compliance with the owner's/agent's instructions and Chapter A-E 7 of the Wisconsin Administrative Code - Minimum Standards for Property Surveys, and that this map is an accurate representation thereof to the best of my knowledge and belief.

Douglas G. Olson
Wisconsin Registered Land Surveyor - 2093

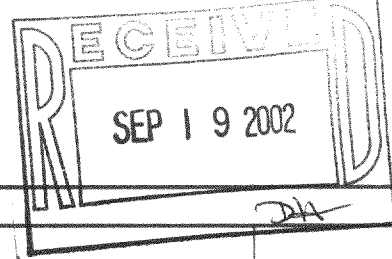

Sheet 1 of 1 Sheets.

Job Reference Number

2001.021

Legend

- Found Iron Rod
- Found Iron Pipe
- Found Railroad Spike
- Found Chiselled Cross
- Set Iron Rod, 3/4" dia
- Recorded Information
- Asphalt Surface
- Concrete Surface




Jensen & Olson Land Surveying, LLC

45 South Wisconsin Street P.O. Box 322
Elkhorn, Wisconsin 53121
Telephone: (262) 723-3434
Facsimile: (262) 723-8044

Scale in Feet

1" = 10'

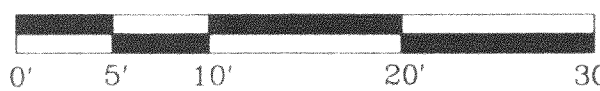

Survey date: May 22, 2001.

Revisions: