


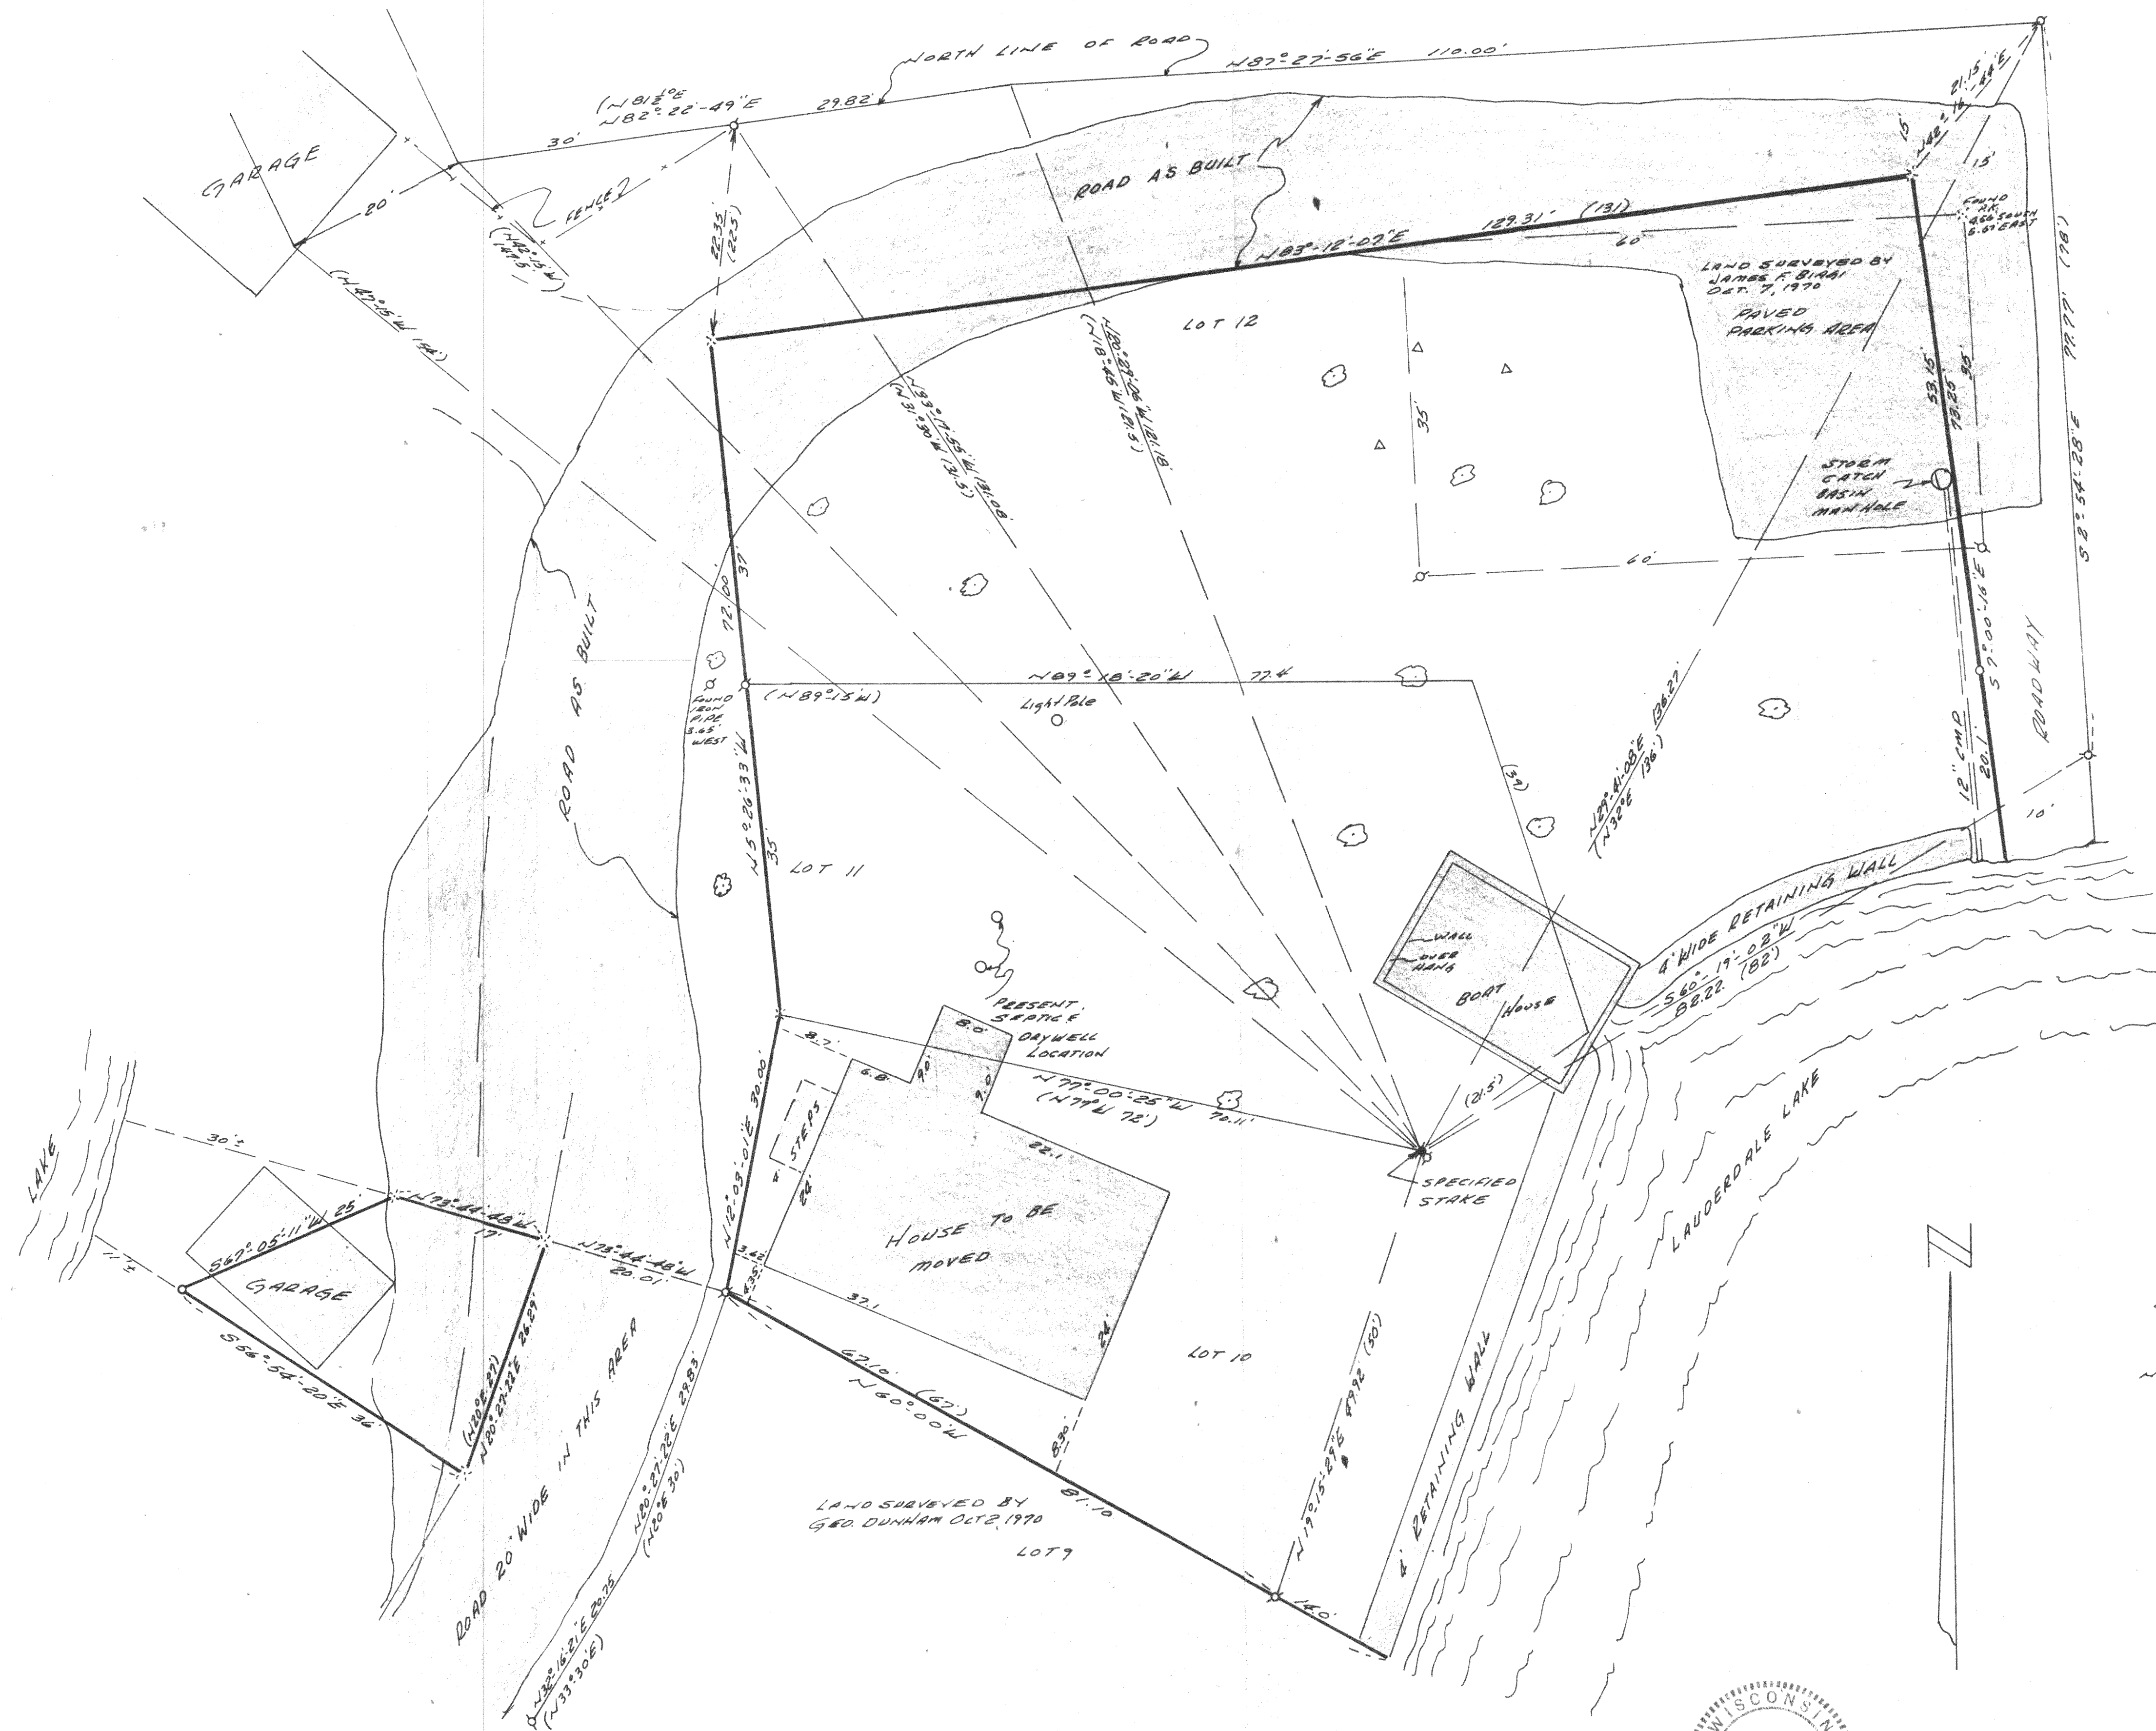


- x ~ P.K. NAIL
- o ~ IRON PIPE SET
- o ~ IRON PIPE FOUND
- o ~ CONC. MONUMENT FOUND
- () ~ RECORDED AS
- BEARING REFERENCED TO THE NORTHERLY LINE OF LOT 9
- Δ ~ RECOLLECTION TEST HOLE
- o ~ TREE LOCATION

NOTE: ROAD INFORMATION TAKEN FROM FIELD NOTES AND SKETCHES OF Wm. CHILD FORMER COUNTY SURVEYOR.

LAND SURVEYED BY
GEO. DUNHAM OCT 2, 1970

LAND SURVEYED BY
JOSEPH M. BINGI JUNE 14, 1974

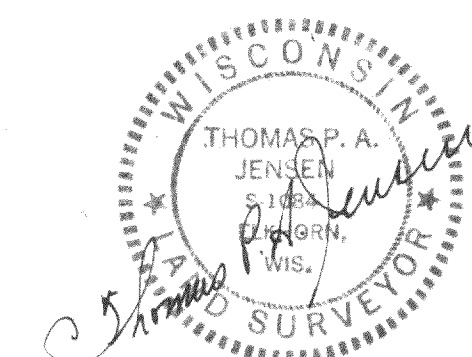

PLAT OF SURVEY OF LOTS 10, 11, 12, BLOCK 1, AND LAND ACROSS ROADWAY FROM LOT 9, CARSWELL'S PARK, SECTIONS 35, 36, TAN RICE, WALWORTH COUNTY, WISCONSIN.		
DRAWN BY T.A. JENSEN	JENSEN & JOHNSON CIVIL ENGINEERS ELKHORN, WIS. DATE OCT. 25, 1974	SCALE: 1"=10'
CHECKED BY		REVISED
APPROVED BY		SHEET NO. 1 OF 1

CA-9
11 10
11 11