

Plat of Survey


of

The Northerly 10 feet of Lot 5 and all of Lots 6 and 7 of La Selva, a subdivision located in the Fractional Southeast 1/4 of Section 26, Town 4 North, Range 16 East, Town of LaGrange, Walworth County, Wisconsin.



Surveyed for: **Czar Construction**
W5154 Stewart Drive
Elkhorn, Wisconsin. 53121

Detail



Lots 1 thru 7.
1"=50'

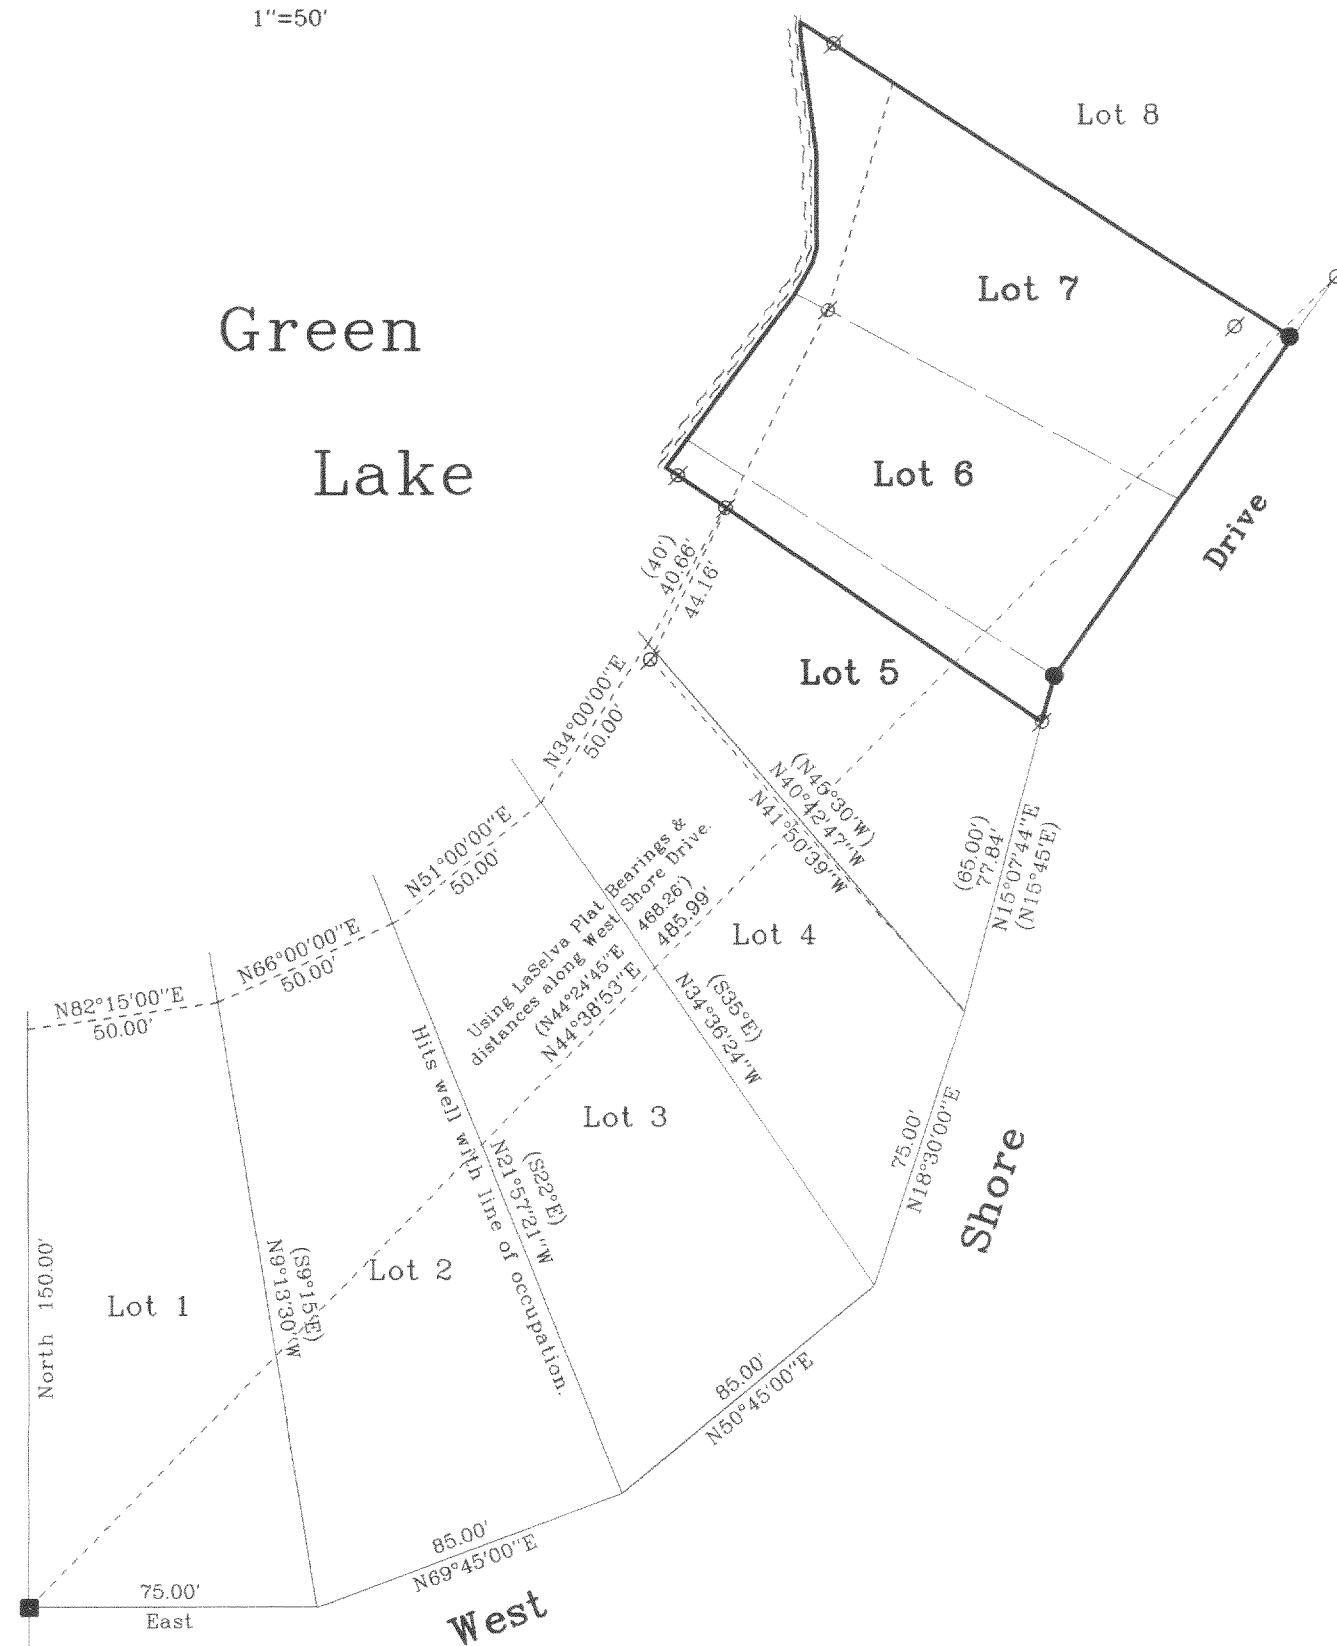

Green
Lake

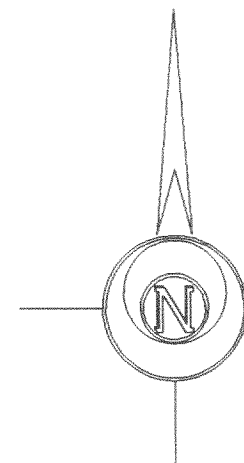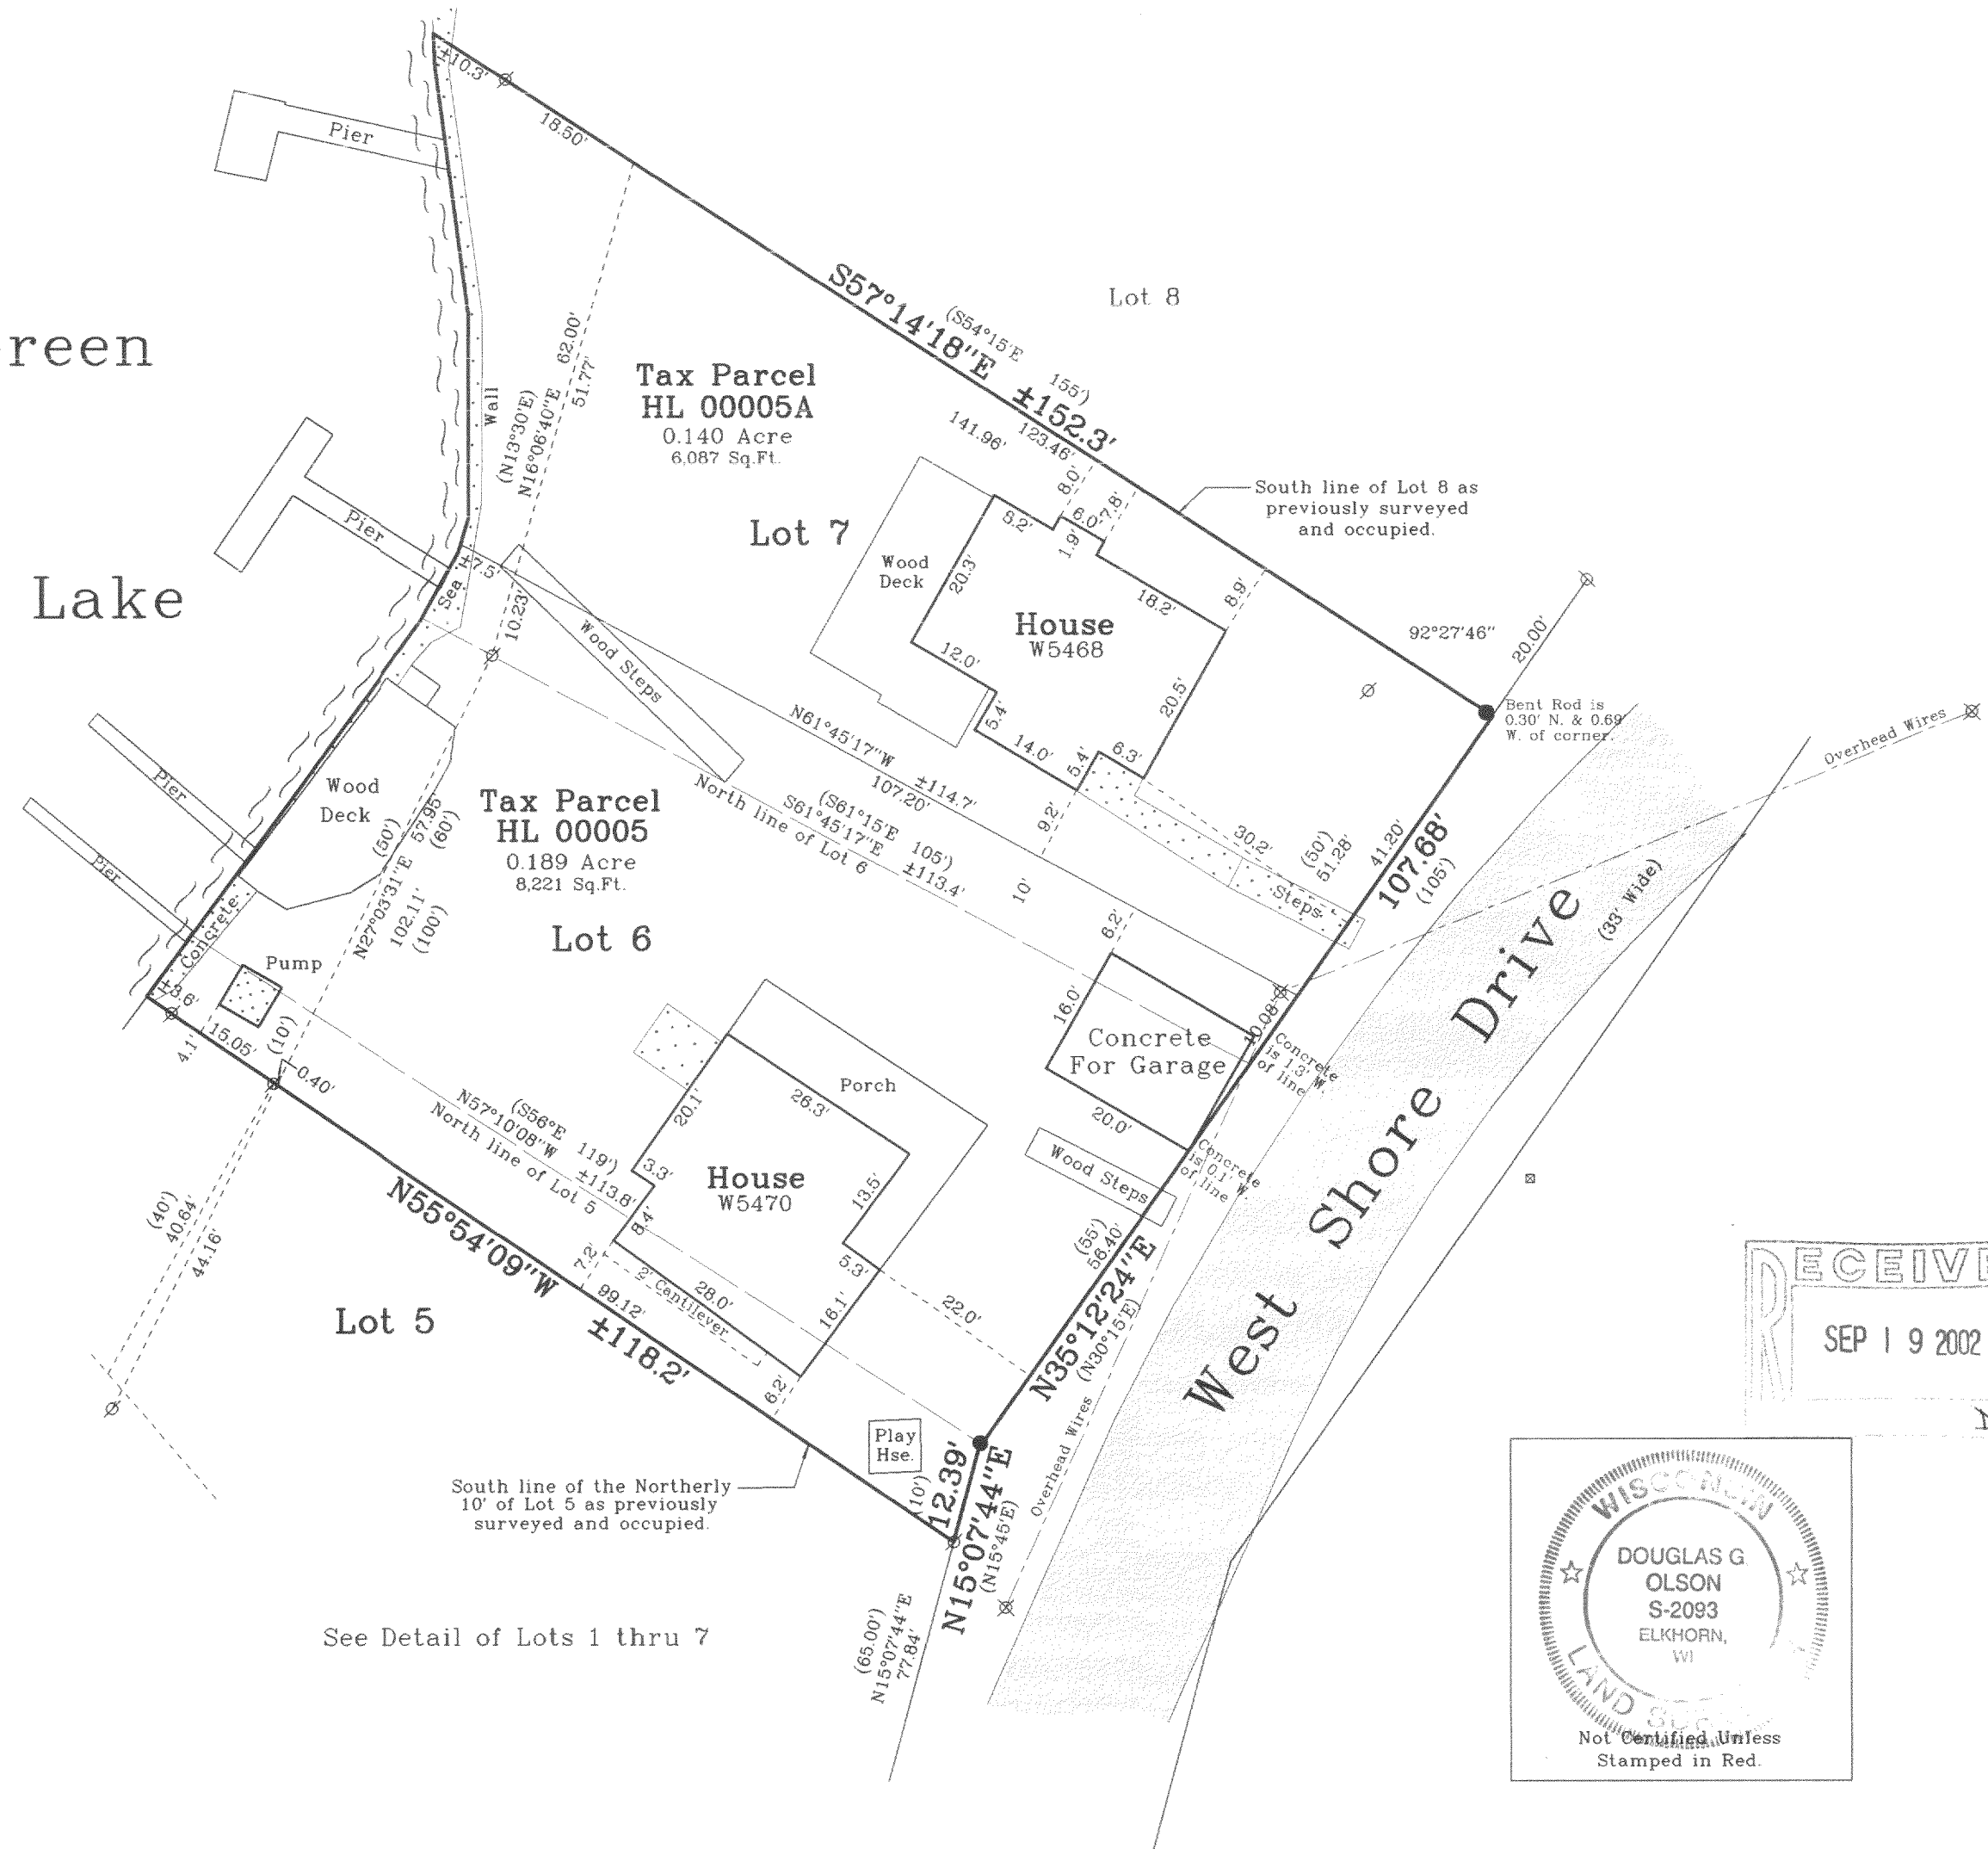

Bearings referenced to the West line of Lot 1, recorded as NORTH on the Subdivision Plat.

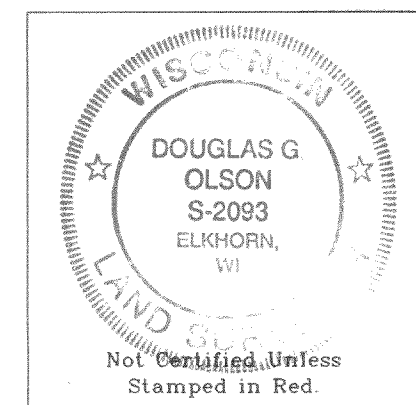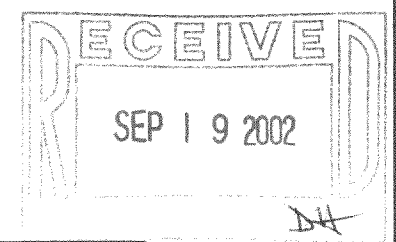

- Notes: 1) This survey plat is not certified unless signed and sealed in red ink.
- 2) This survey is subject to Wisconsin lien laws. This Plat of Survey is the notice of intent to file lien. Lien waiver required.

Copyright © 2002 by Jensen & Olson Land Surveying, LLC.

All rights reserved. No part of this survey plat may be reproduced or transmitted in any form by any means - graphic, electronic, or mechanical, including photocopying, tracing, or information storage and retrieval systems - without permission in writing from Douglas G. Olson, Jensen & Olson Land Surveying, LLC.

I, Douglas G. Olson, Wisconsin Registered Land Surveyor, do hereby certify that this survey was performed by me or under my direction in full compliance with the owner's/agent's instructions and Chapter A-E 7 of the Wisconsin Administrative Code "Minimum Standards for Property Surveys" and that this map is an accurate representation thereof to the best of my knowledge and belief.

Douglas G. Olson
Wisconsin Registered Land Surveyor - 2093

Survey Date: December 7, 2001.
Revisions:

Scale in Feet
1" = 20'
0' 10' 20' 40'

Jensen & Olson Land Surveying, LLC
45 South Wisconsin Street
Elkhorn, Wisconsin. 53121
Telephone (262) 723-3434
Facsimile (262) 723-8044

Legend
Found Concrete Monument
Found Iron Pipe
Found Iron Rod
Recorded Information
Utility Pole
Utility Pedestal
Concrete Surface
Asphalt Surface

Sheet 1 of 1 Sheets
Job Reference Number
2001.161

2001.161

HL-5
HL-5A

416-1820