


Plat of Survey

of



A parcel of land described in a Warranty Deed recorded in Vol. 630 on Page 564 as Document No. 579019 as shown below:

Beginning at the NW corner of Lot 13, Block 2, Carswells Park at the shore of Middle Lake, thence S. 17° E. 51 feet to the North line of a highway, thence N. 85°56'30" E. along the North line of said highway 50 feet more or less to the E. line of Lot 13, thence N. 16° W. 57.5 feet to the shore of Middle Lake, thence Westerly along the shore line 50 feet more or less to the place of beginning. Also beginning at the NW corner of Lot 19, Block 3, of said Subdivision, thence N. 5°00' W. on the prolongation of the W. line of said Lot 19, 19.8 feet to a point, thence N. 85°57' W. 143.2 feet, thence N. 2°37' W. 351.7 feet to a point, thence S. 88°48' E. 82.5 feet to the place of beginning; thence continue S. 88°48' E. 83.2 feet to a point, thence S. 10°58' E. 120.0 feet, thence N. 88°48' W. 50.0 feet, thence N. 10°58' W. 22.9 feet, thence S. 88°54' W. 48.3 feet to a point, thence Northerly 100 feet more or less to the place of beginning.

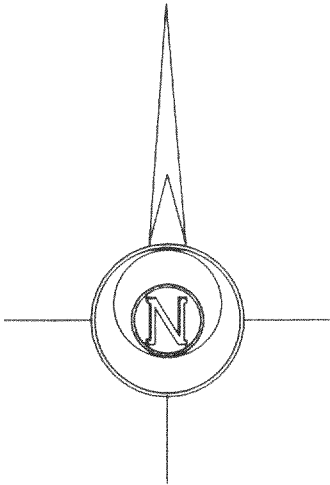

Bearings referenced to previous surveys.

Surveyed for: **John Miota**
20825 Bradford Lane
Brookfield, Wisconsin. 53045

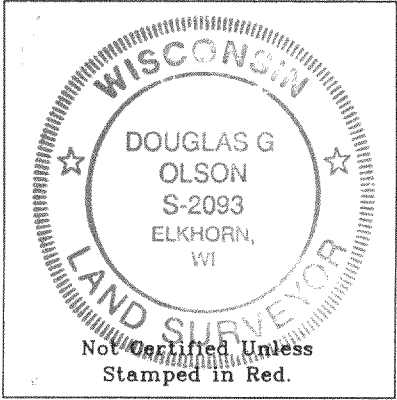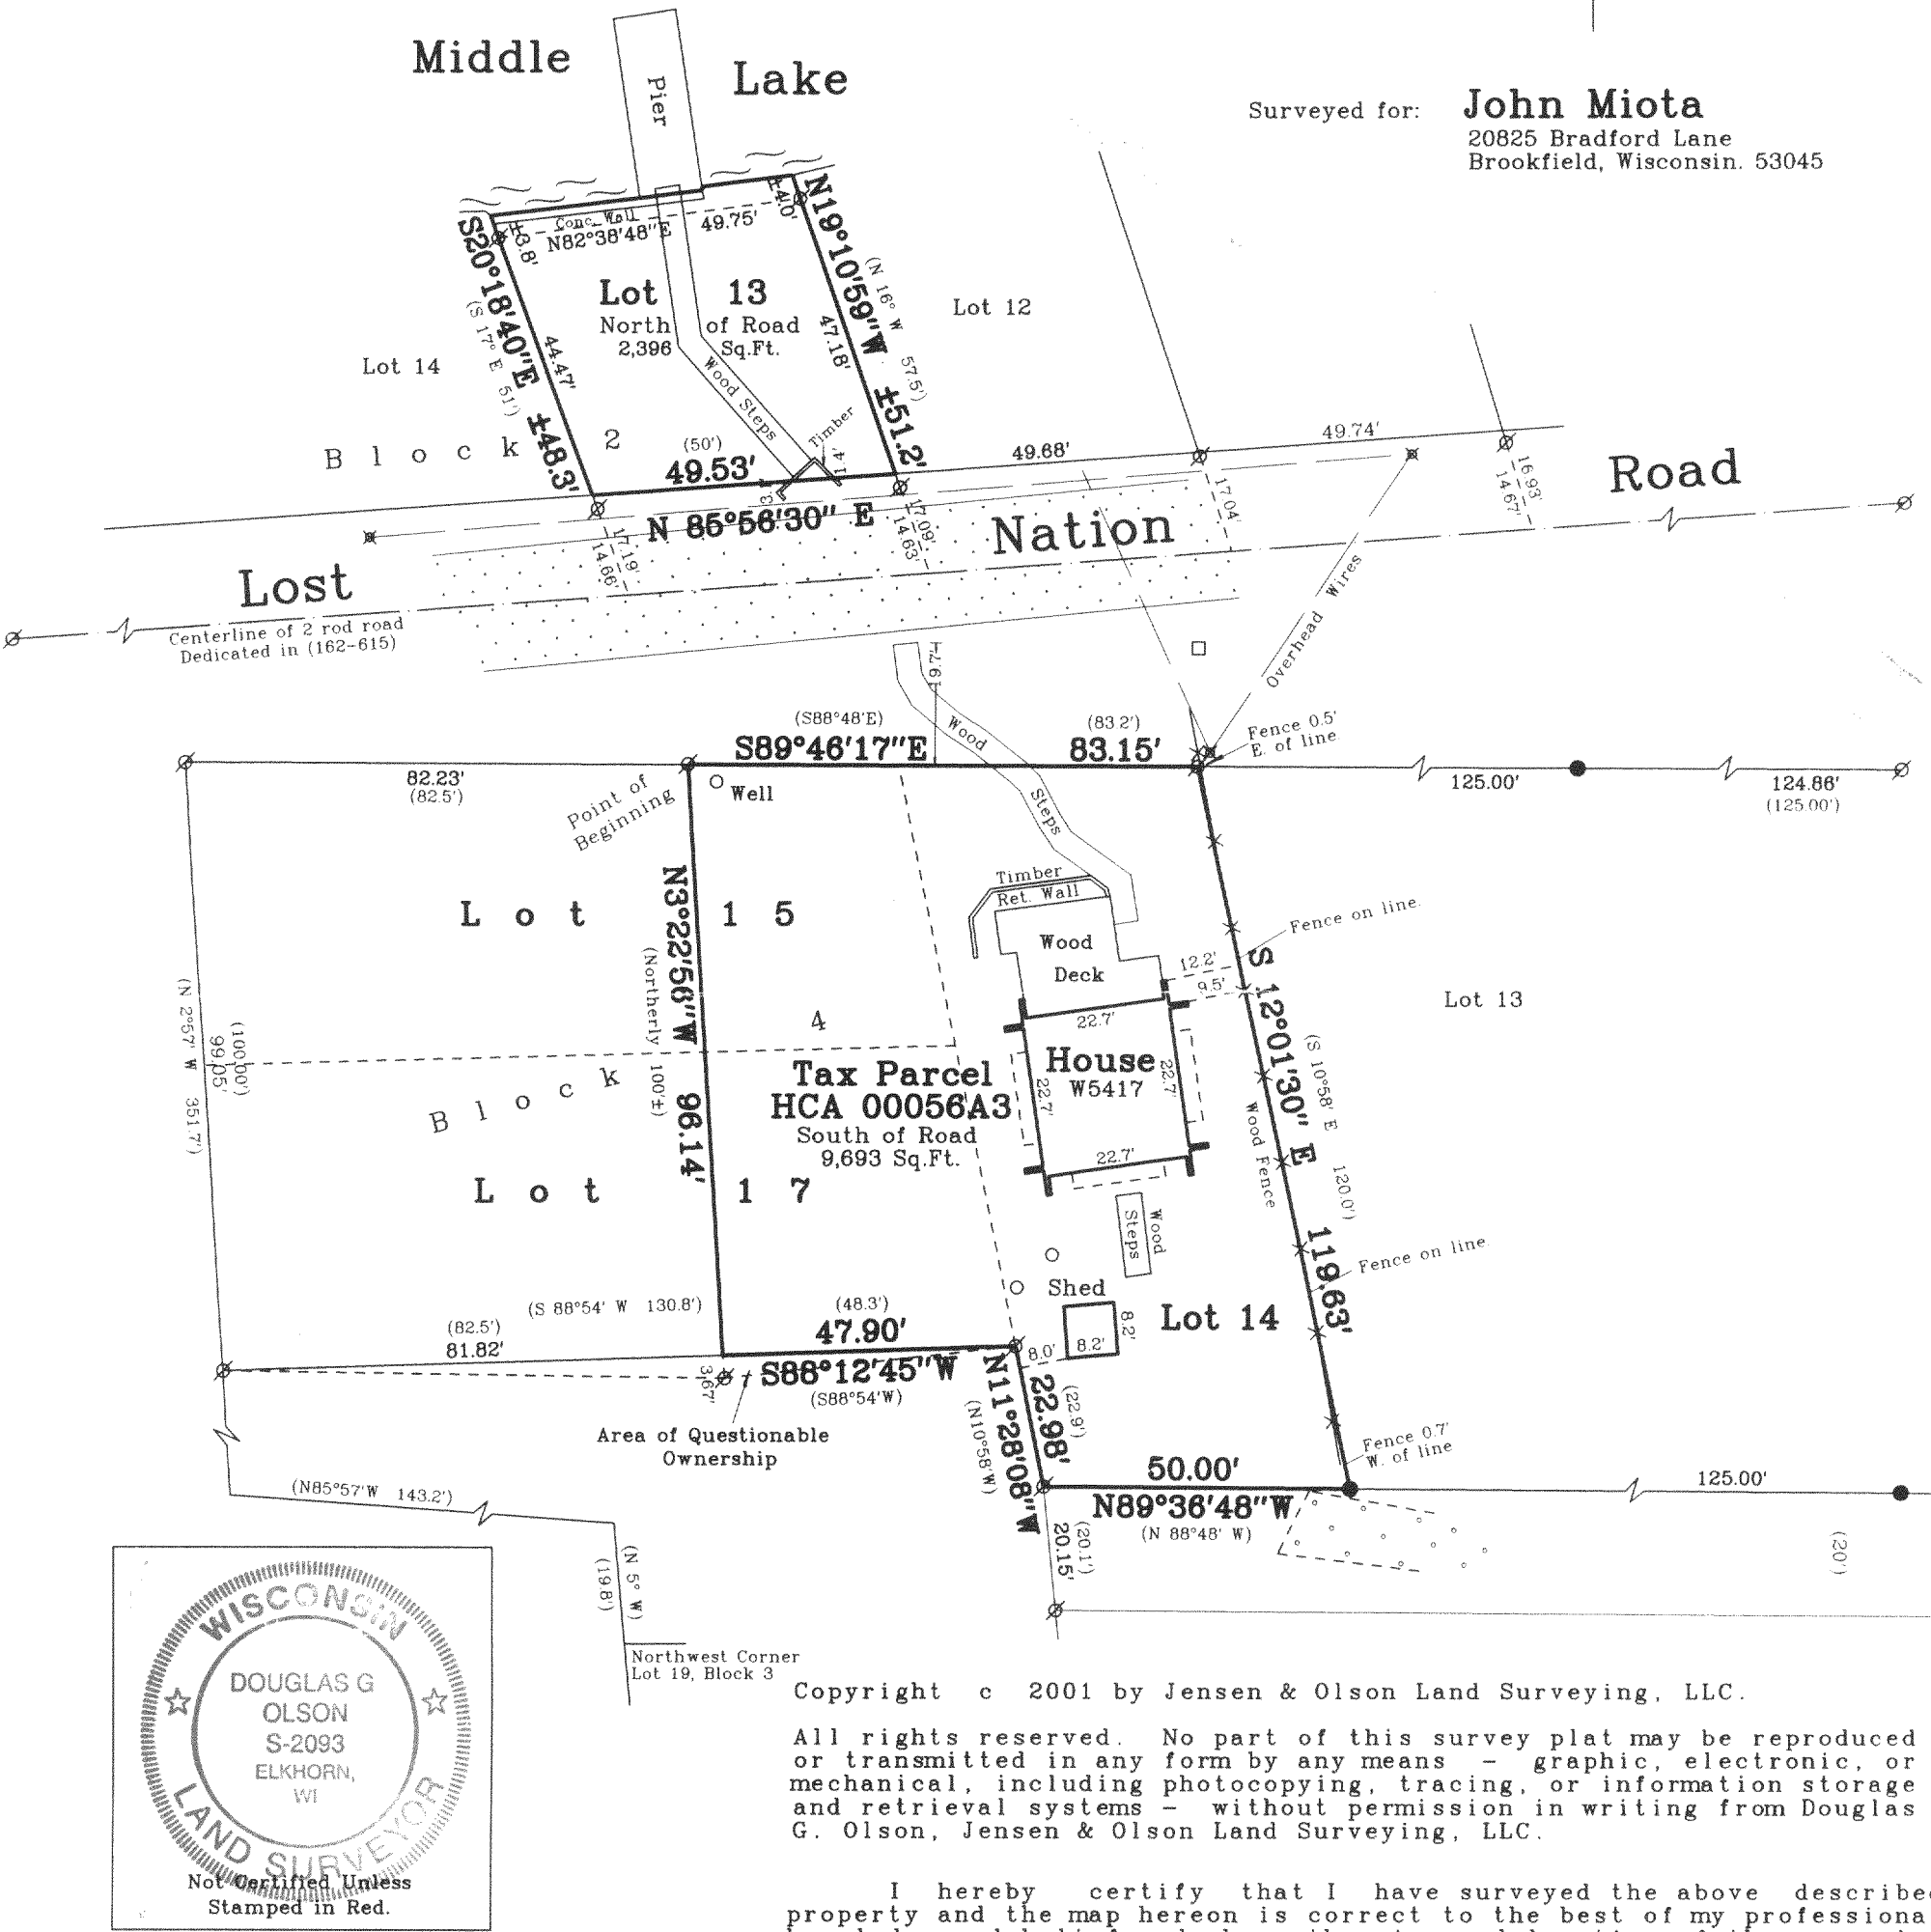

Copyright c 2001 by Jensen & Olson Land Surveying, LLC.

All rights reserved. No part of this survey plat may be reproduced or transmitted in any form by any means - graphic, electronic, or mechanical, including photocopying, tracing, or information storage and retrieval systems - without permission in writing from Douglas G. Olson, Jensen & Olson Land Surveying, LLC.

I hereby certify that I have surveyed the above described property and the map hereon is correct to the best of my professional knowledge and belief and shows the size and location of the property, its exterior boundaries, the location and dimensions of all visible structures thereon, boundary fences, apparent easements and roadways and visible encroachments, if any.

This survey is made for the exclusive use of the present owners of property, and also those who purchase, mortgage or guarantee title thereto, within one year from the date hereof.


Douglas G. Olson
Wisconsin Registered Land Surveyor - 2093

Notes:

- 1) This survey plat is not certified unless signed and sealed in red ink.
- 2) This survey is subject to Wisconsin lien laws. This Plat of Survey is the notice of intent to file lien. Lien waiver required.

Legend

- Found Iron Pipe
- Found Iron Rod
- Recorded Information
- Utility Pole
- Utility Pedestal
- Concrete Cover
- Asphalt Surface
- Gravel Surface

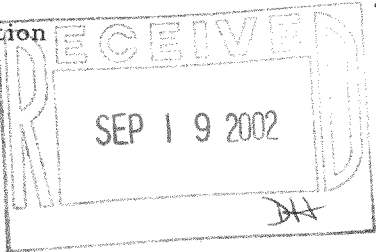

Jensen & Olson Land Surveying, LLC

45 South Wisconsin Street P.O. Box 322
Elkhorn, Wisconsin. 53121
Telephone: (262) 723-3434
Facsimile: (262) 723-8044

Scale: 1" = 30'



Survey date: June 21, 2001.
Revisions:

Sheet 1 of 1 Sheets.

Job Reference Number:

2001.078

HCA-56A3

416-1823