


PLAT OF SURVEY

LOT 4, CERTIFIED SURVEY MAP NO. 1185, being a part of the Southwest 1/4 of Section 26. Town 4 North, Range 16 East, Town of LaGrange, Walworth County, Wisconsin.
 Surveyed for: Mike Logue

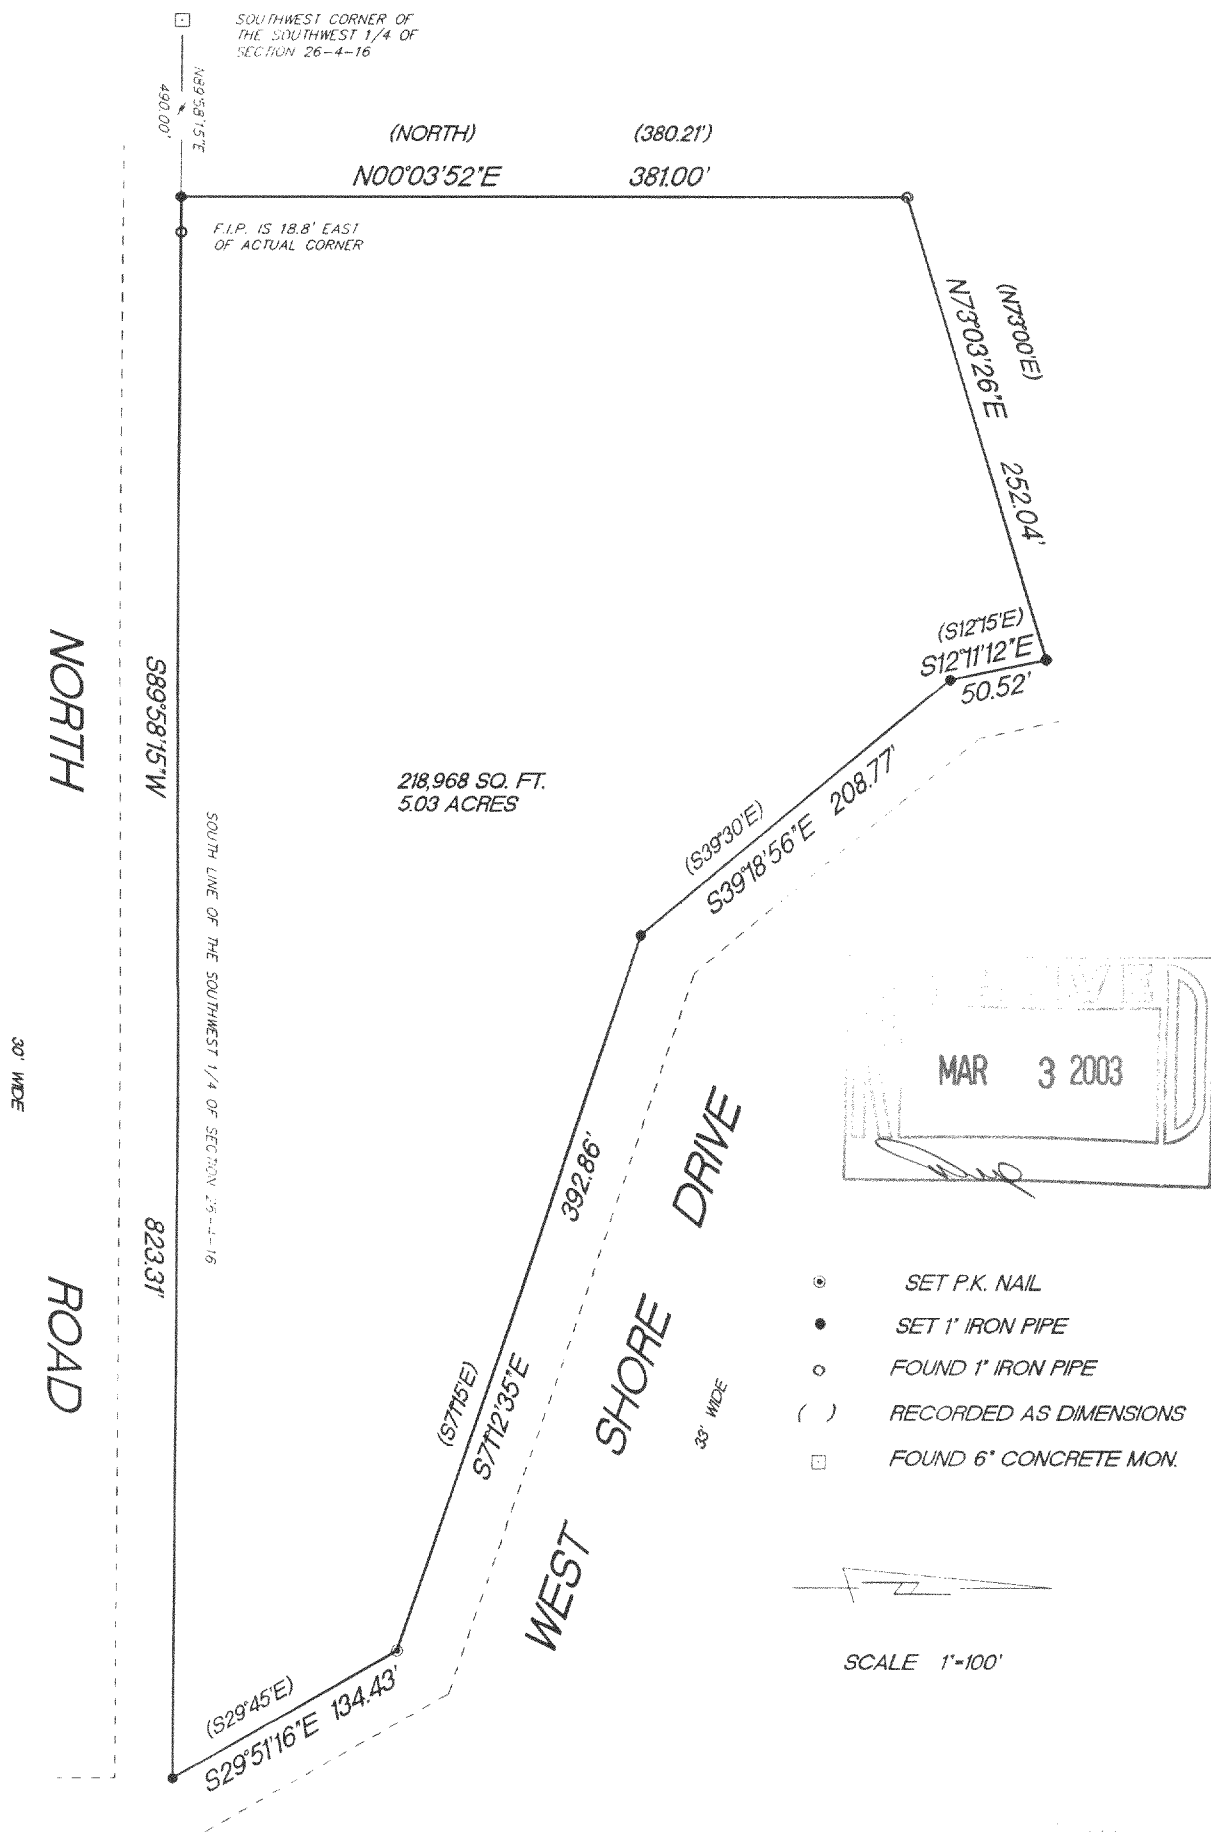


"I hereby certify that I have surveyed the above described property and that the above map is a true representation thereof and shows the size and location of the property, its exterior boundaries, the location of all visible structures and dimension of all principal buildings thereon, boundary fences, apparent easements, roadways and encroachments if any."

"This survey is made for the use of the present owners of the property, and also those who purchase, mortgage or guarantee the title thereto within one year from date hereof."

2/17/03

TEP/DW

KETTLE MORaine SURVEYING INC.
 W356 S9050 Godfrey Lane
 Eagle Wisconsin 53119
 P.O. Box 357
 (262) 594-3484
 Terrance E. Pisarek R.L.S.

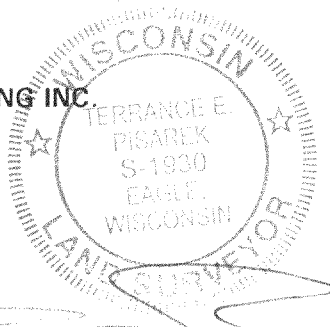

THIS IS NOT AN ORIGINAL SURVEY UNLESS THE SEAL IS RED.
 TEP 03019

DATE

FIELD WORK BY

DRAWN BY

JOB NUMBER

HA1185-4

416-1863