


Plat of Survey



of
Lot 1 of Certified Survey Map No. 627,
Recorded in Vol. 3 of Certified Survey Maps of Walworth County on
Page 95 and located in the Northeast 1/4 of Section 35, Town 4
North, Range 16 East, Town of LaGrange, Walworth County, Wisconsin.

Surveyed for: Allen, Harrison, Williams,
McDonell & Swatek LLP
452 West Main Street
P.O. Box 59
Whitewater, Wisconsin 53190

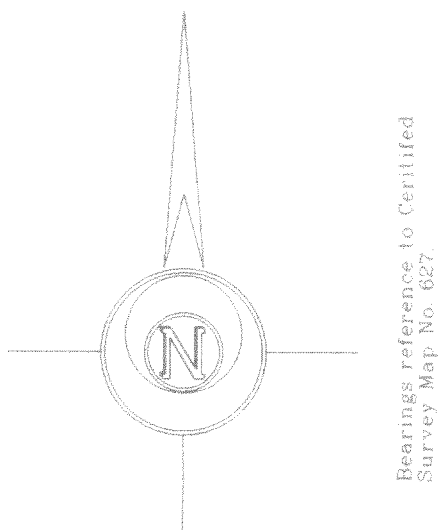

Mill
Lake

Elevations referenced to the
water level of Mill Lake as
measured on April 15, 2002.
Assumed as 92.5 to match
existing survey to the North.

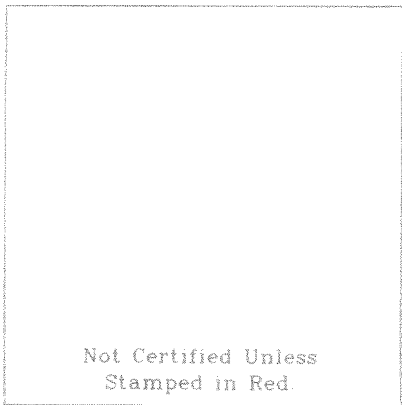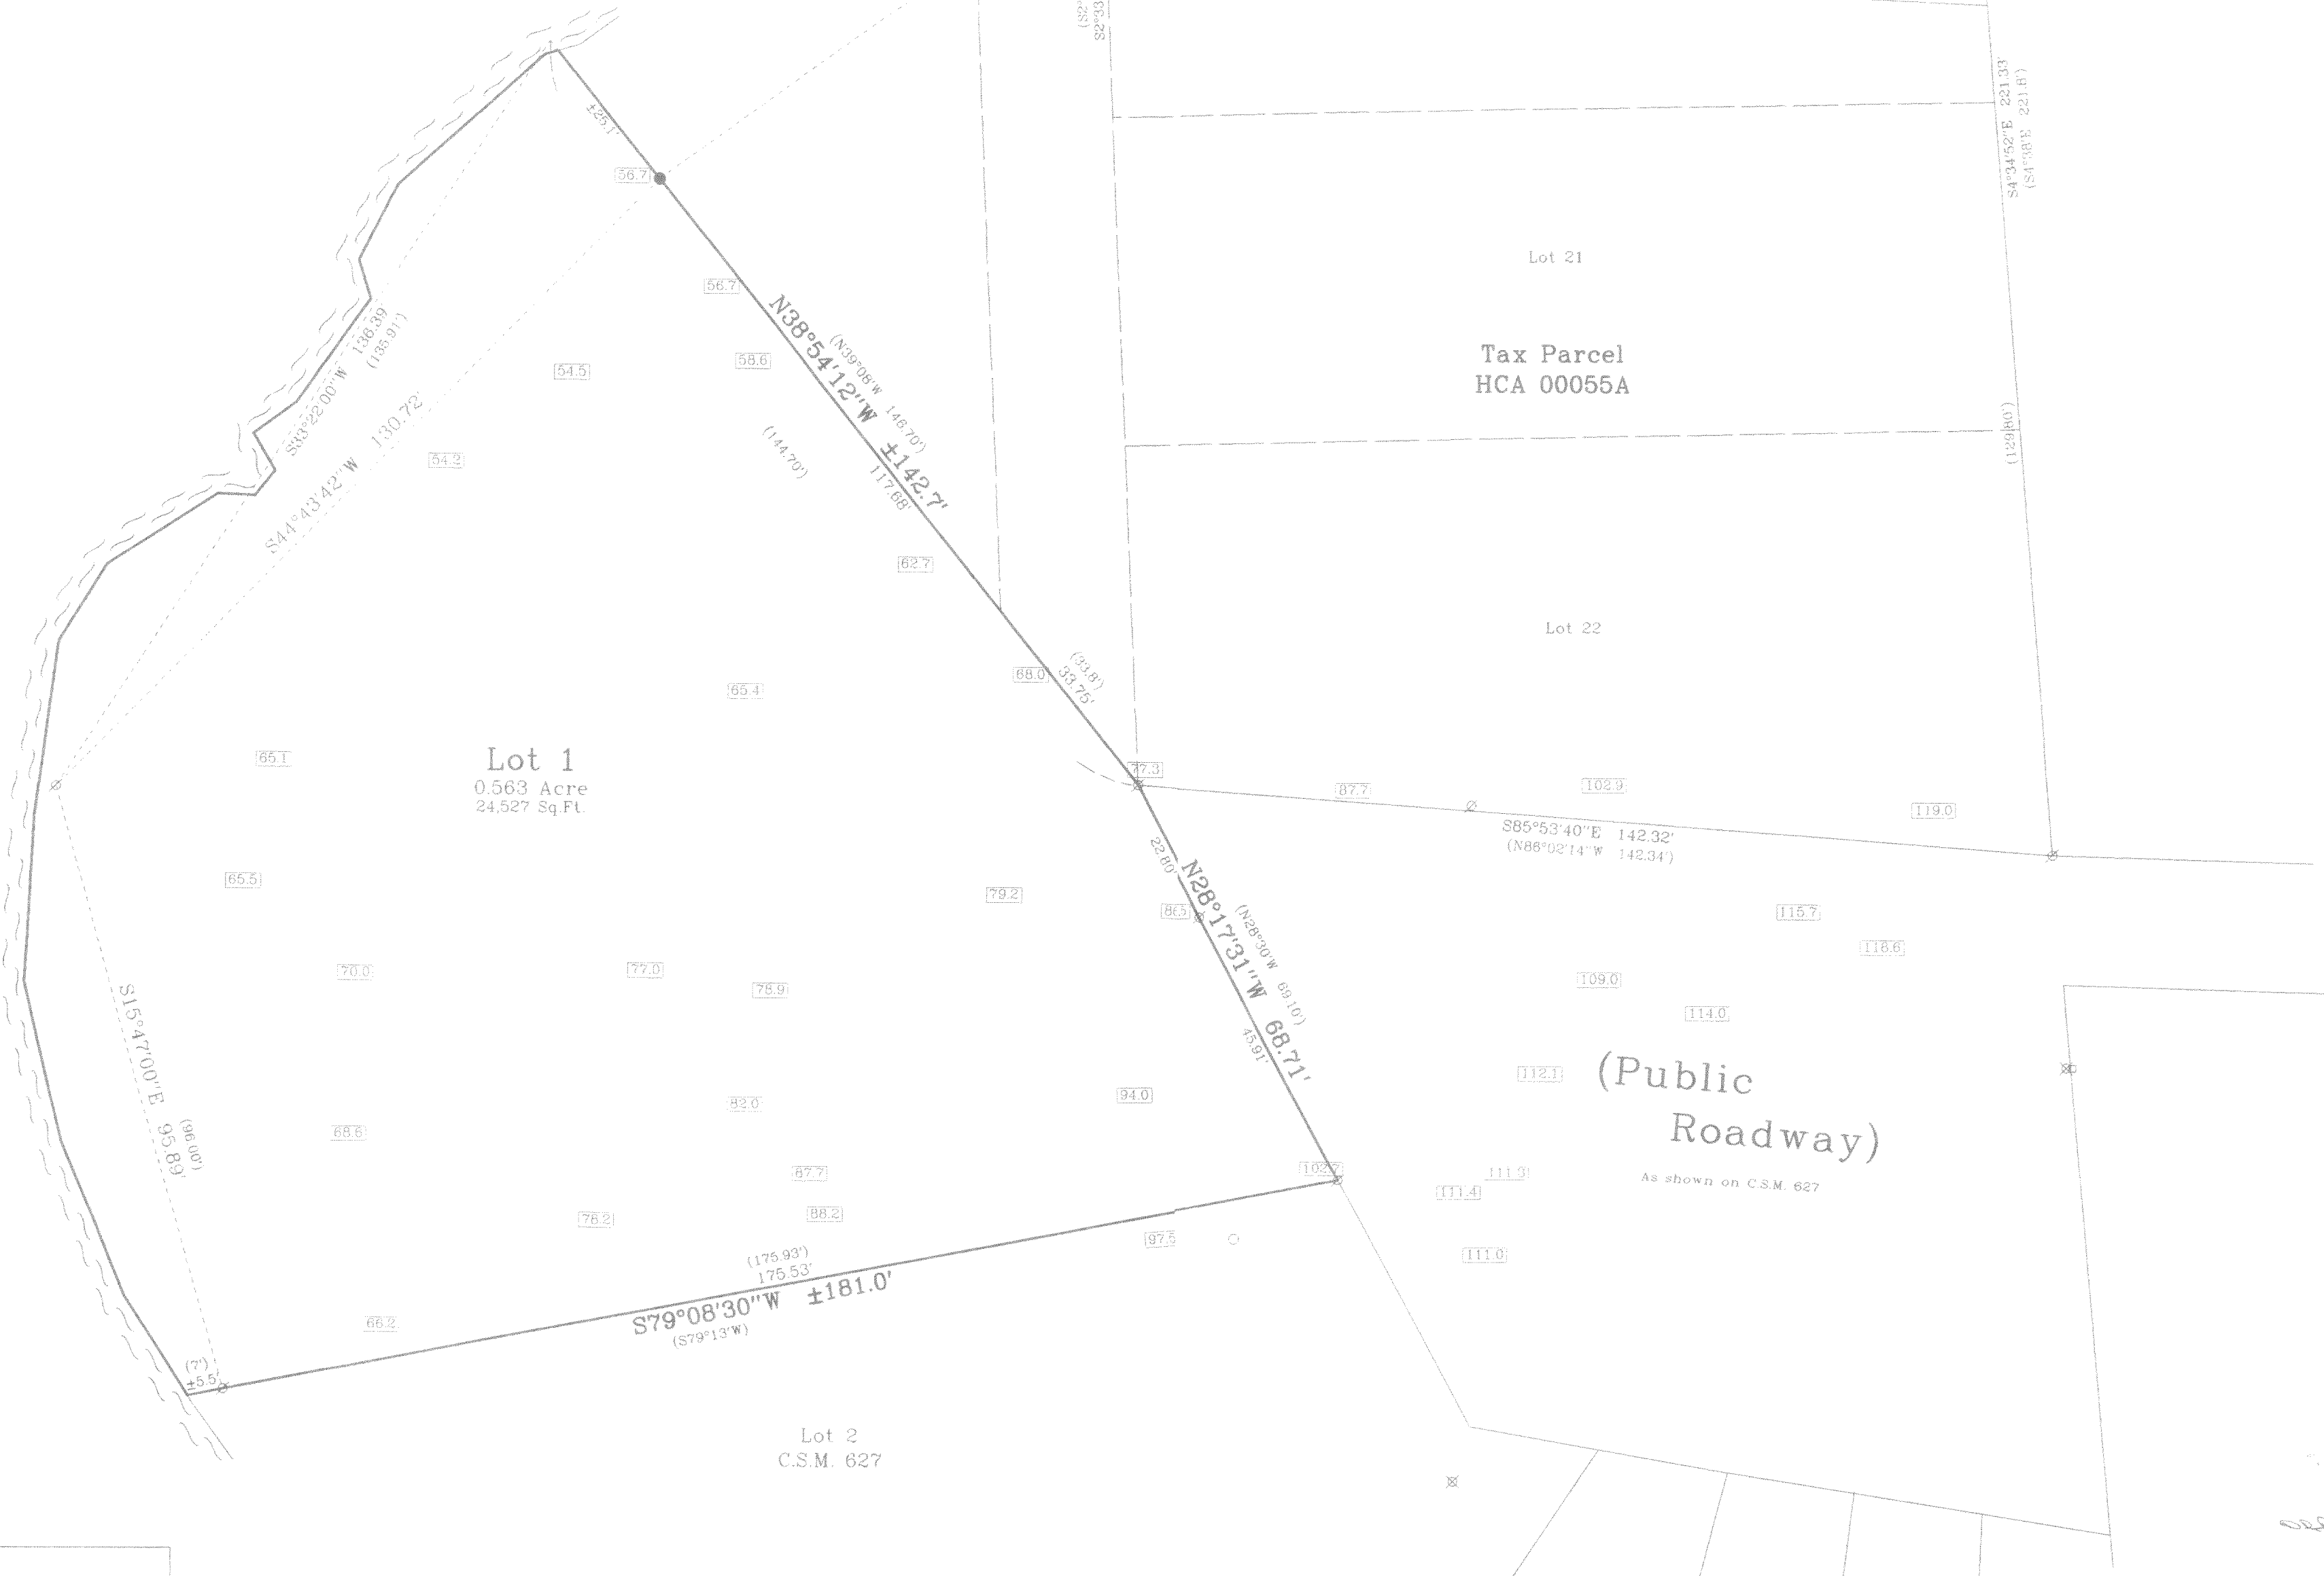

Notes: 1) This survey plat is not
certified unless signed
and sealed in red ink.
2) This survey is subject to Wisconsin lien laws
This Plat of Survey is the notice of intent
to file lien. Lien waiver required.

Copyright © 2002 by Jensen & Olson Land Surveying, LLC.
All rights reserved. No part of this survey plat may be reproduced
or transmitted in any form by any means - graphic, electronic, or
mechanical, including photocopying, tracing, or information storage
and retrieval systems - without permission in writing from Douglas
G. Olson, Jensen & Olson Land Surveying, LLC.

I, Douglas G. Olson, Wisconsin Registered Land Surveyor,
do hereby certify that this survey was performed by me or under my
direction in full compliance with the owner's/agent's instructions
and Chapter A-E 7 of the Wisconsin Administrative Code "Minimum
Standards for Property Surveys"; and that this map is an accurate
representation thereof to the best of my knowledge and belief.

Douglas G. Olson
Wisconsin Registered Land Surveyor - 2093

Sheet 1 of 1 Sheets.

Legend

- Found Iron Pipe
- Found Iron Rod
- Recorded Information
- Spot Elevation

Job Reference Number

2002.016



Jensen & Olson Land Surveying, LLC

45 South Wisconsin Street P.O. Box 322
Elkhorn, Wisconsin 53121
Telephone: (262) 723-3434
Facsimile: (262) 723-8044

Scale in Feet

1" = 20'



Survey date: April 25, 2002
Revisions: