


Plat of Survey

of
Lots 3 and 4 of La Selva,
a subdivision located in the Fractional Southeast 1/4 of
Section 26, Town 4 North, Range 16 East, Town of LaGrange,
Walworth County, Wisconsin.

also
Commencing at a point that is 33.00 feet South 22° East
of and 19.50 feet South 69°45' West of the Southeast
corner of Lot 2 of LaSelva Subdivision, LaGrange
Township, Walworth County, Wisconsin, thence Southerly
at right angles to the South side of the road 60.00 feet
to an iron stake, thence Easterly parallel to the South
side of the road 21.33 feet to a point, thence
Northeasterly parallel to the South side of the road
54.34 feet to an iron stake, thence Northerly at right
angles 60.00 feet to the South side of the road, thence
Westerly along the South side of the road to the place
of beginning.

Surveyed for: Keefe Real Estate, Inc.
751 Geneva Parkway
P.O. Box 460
Lake Geneva, Wisconsin. 53147

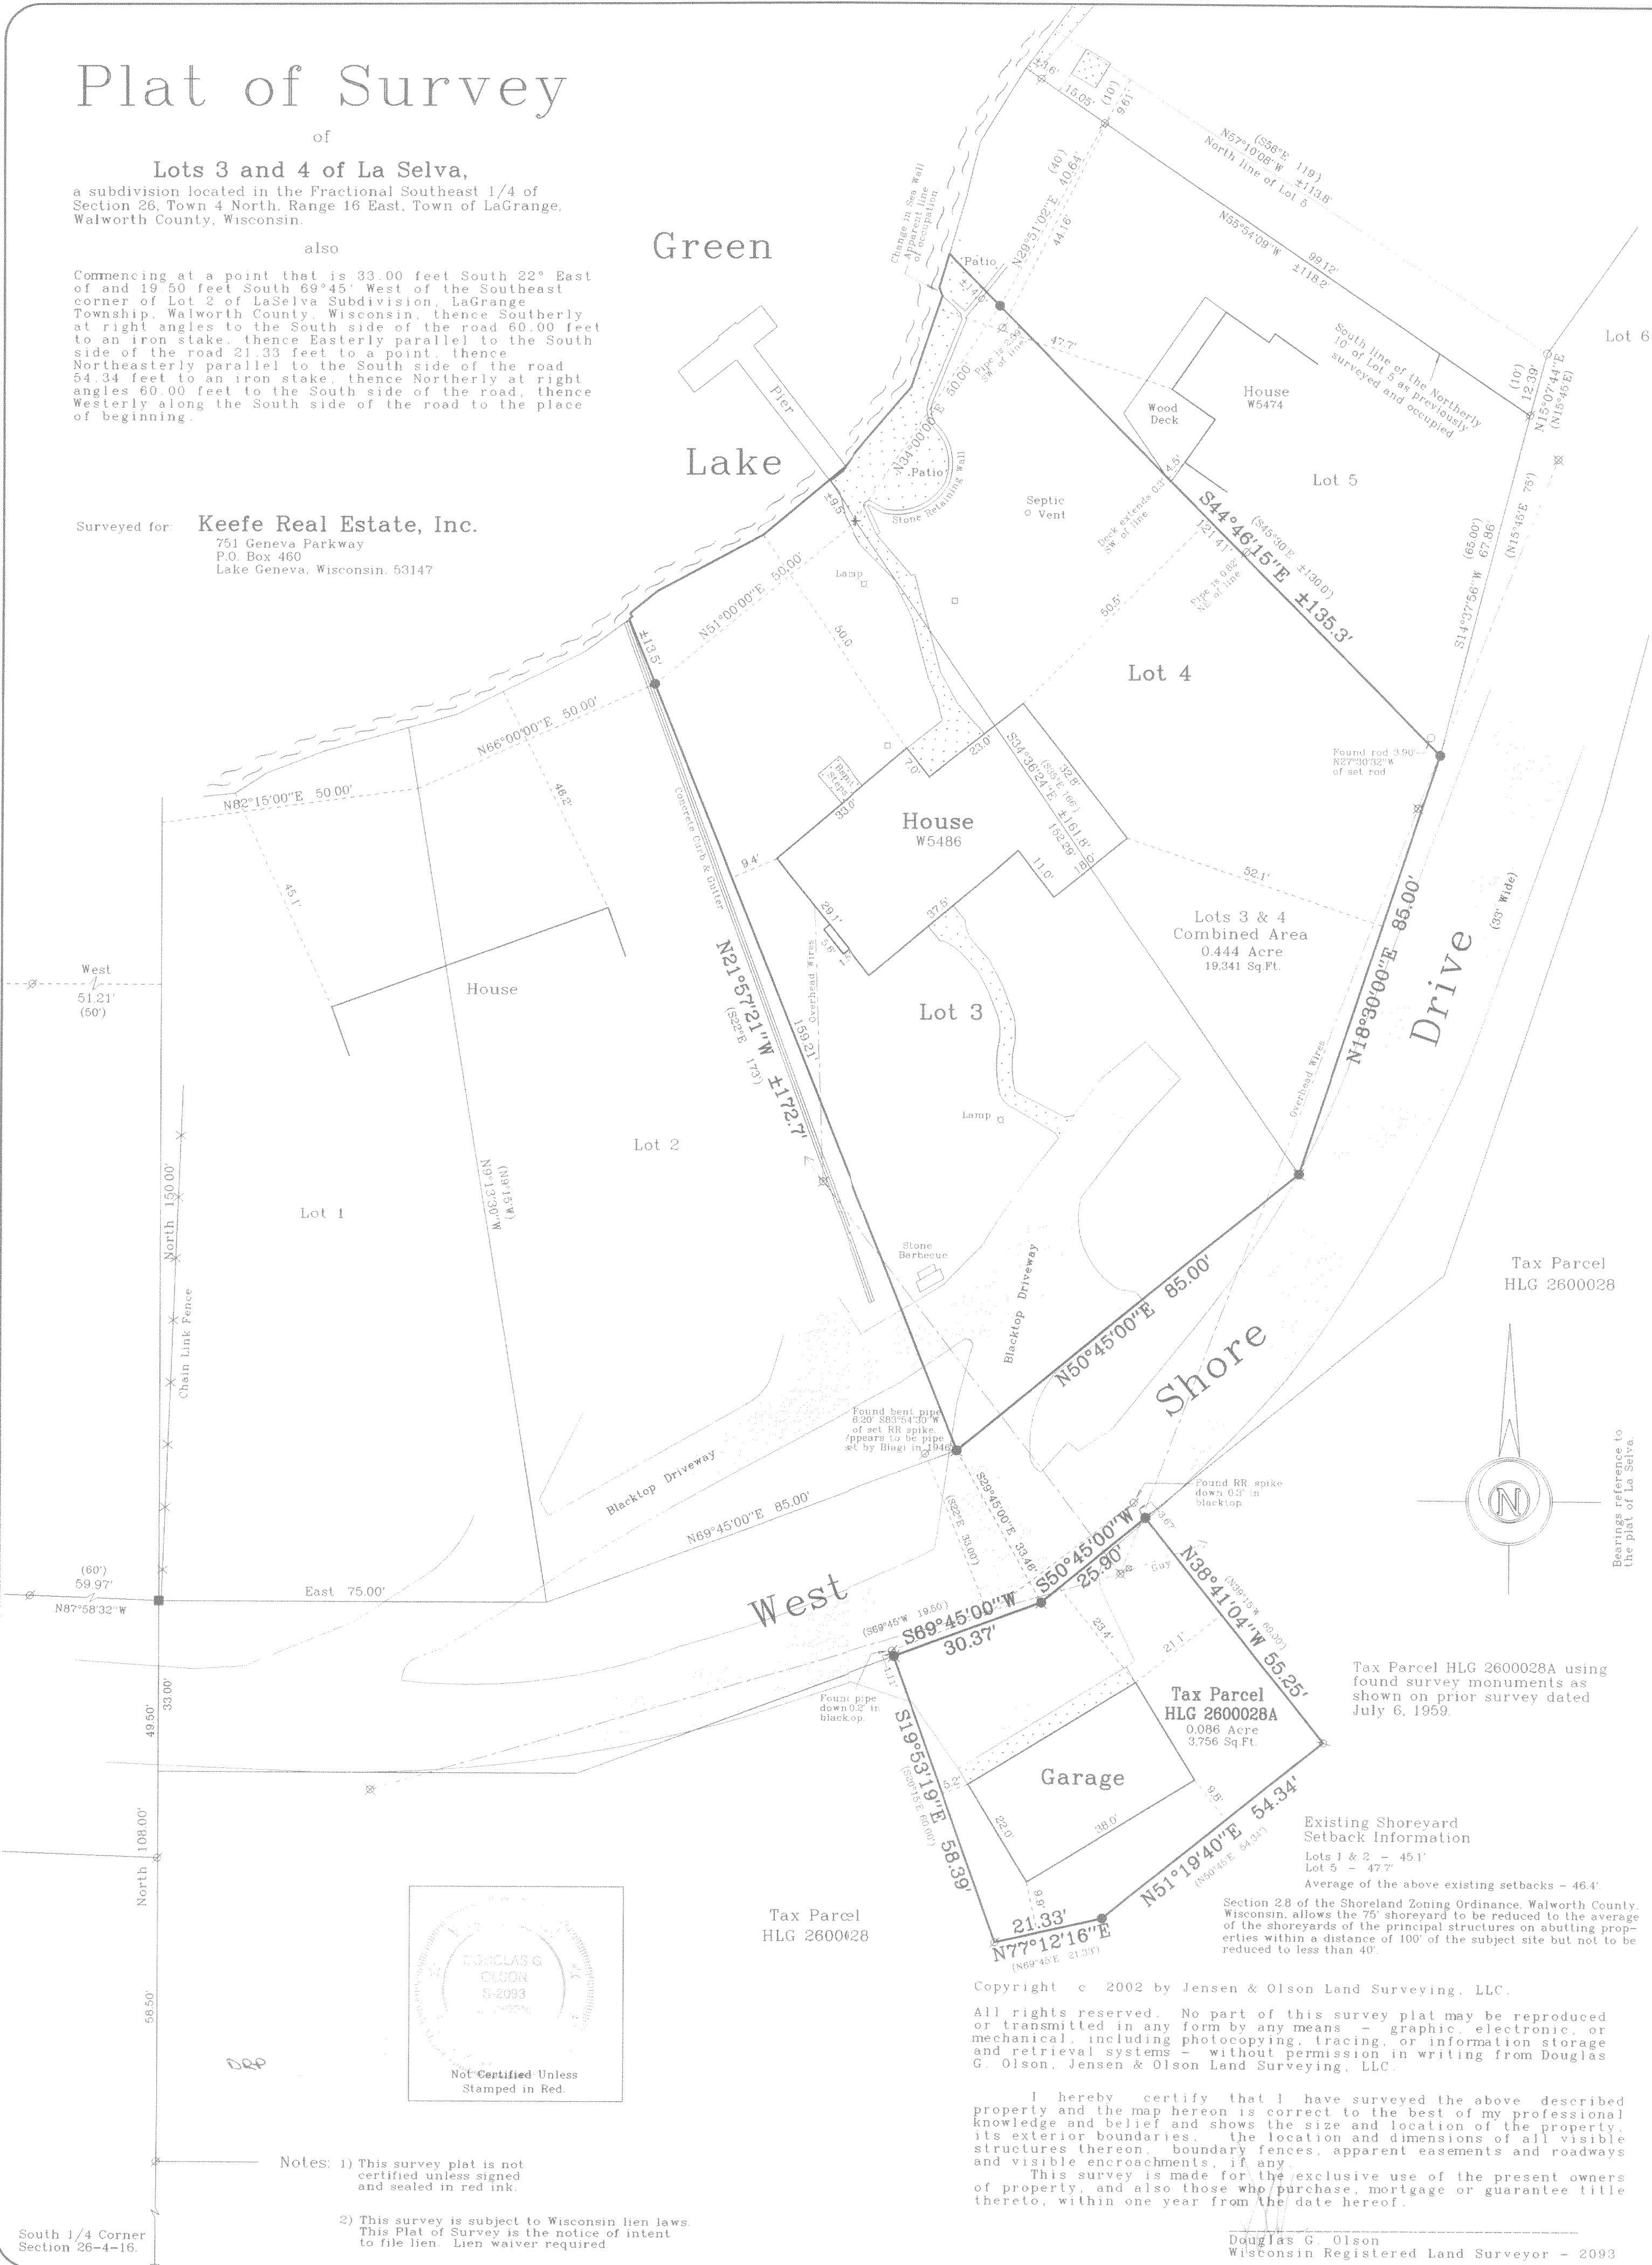

AL-2
HL-3
HLG 26-28A

416-1897