


HAROLD H. KOLB

REGISTERED PROFESSIONAL LAND SURVEYOR
LAKE GENEVA, WISCONSIN

PLANTATION ROAD · 76' WIDE

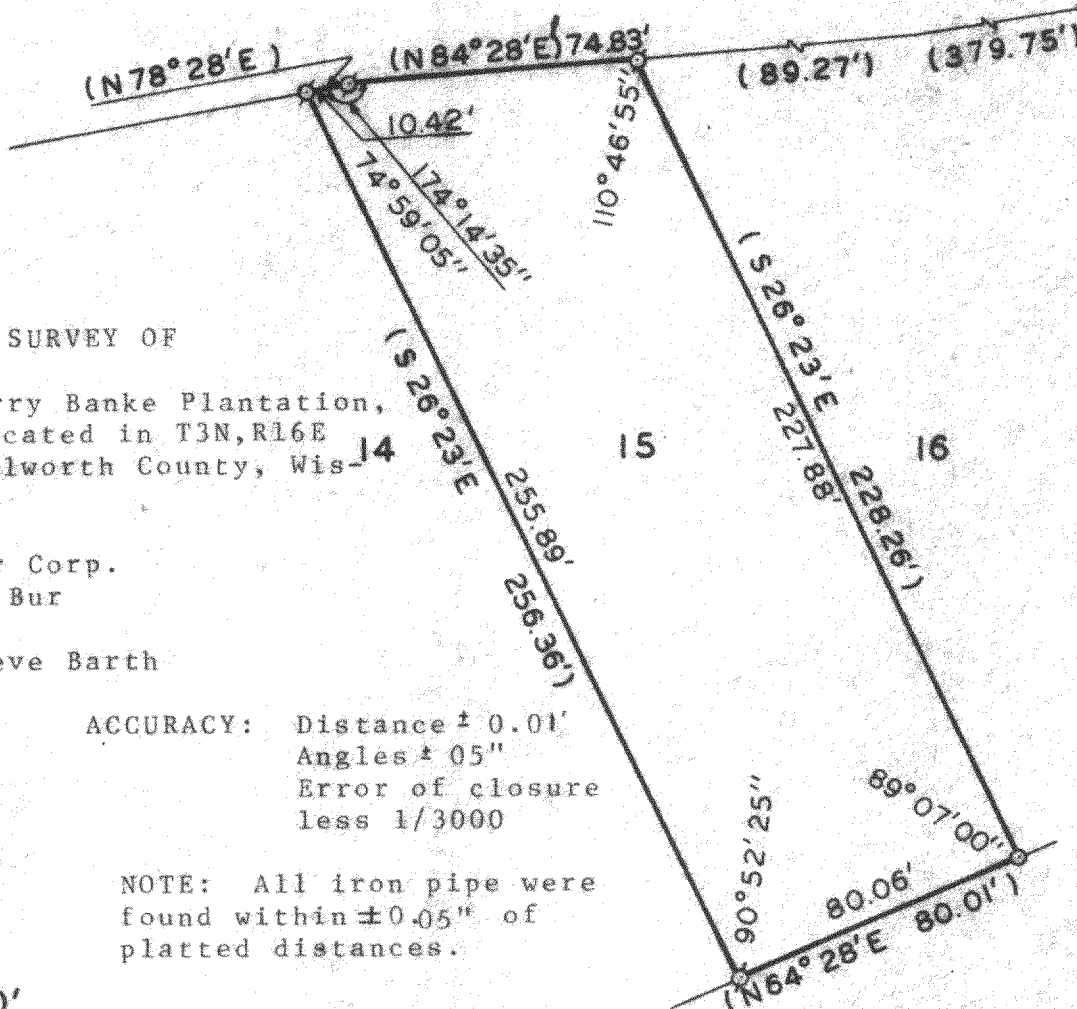

PLAT OF SURVEY OF

Lot 15, Strawberry Banke Plantation,
a subdivision located in T3N, R16E
and T4N, R16E, Walworth County, Wis-
consin.

OWNERS: O'Connor Corp.
Cynthia Bur

ORDERED BY: Steve Barth

ACCURACY: Distance $\pm 0.01'$
Angles $\pm 05''$
Error of closure
less 1/3000


NOTE: All iron pipe were
found within $\pm 0.05''$ of
platted distances.



SCALE · 1" = 50'

LEGEND

- φ — IRON PIPE FOUND
- — IRON PIPE PLACED
- — CONCRETE MONUMENT
- x — SPIKE
- () — Platted As

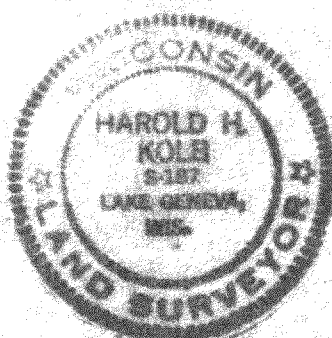

I, HAROLD H. KOLB, DO HEREBY CERTIFY THAT I HAVE
SURVEYED THE PROPERTY HEREON DESCRIBED ACCORDING
TO THE OFFICIAL RECORDS, AND THAT THE PLAT HEREON
IS A CORRECT REPRESENTATION OF THE LOT LINES.

Harold H. Kolb

HAROLD H. KOLB
WISCONSIN REGISTERED LAND SURVEYOR, S-187
DATE Sept 20, 1979

HSP-15 & S.C.