

ABERNATHY and ASSOCIATES

Kenneth B. Abernathy Jr.


Wisconsin Registered Land Surveyor

S-1594

W4056 BRAY RD.
ELKHORN, WI 53121
PHONE: (262) 723-4260 (OFFICE)
(262) 723-7209 (FAX)
Email: abernathy@elknet.net

PLAT OF SURVEY

LOT 68 OF THE FIRST ADDITION TO BUBBLING SPRINGS SUBDIVISION, LOCATED IN SECTIONS 34 AND 35, TOWN 4 NORTH, RANGE 16 EAST, TOWN OF LAGRANGE, WALWORTH COUNTY, WISCONSIN.

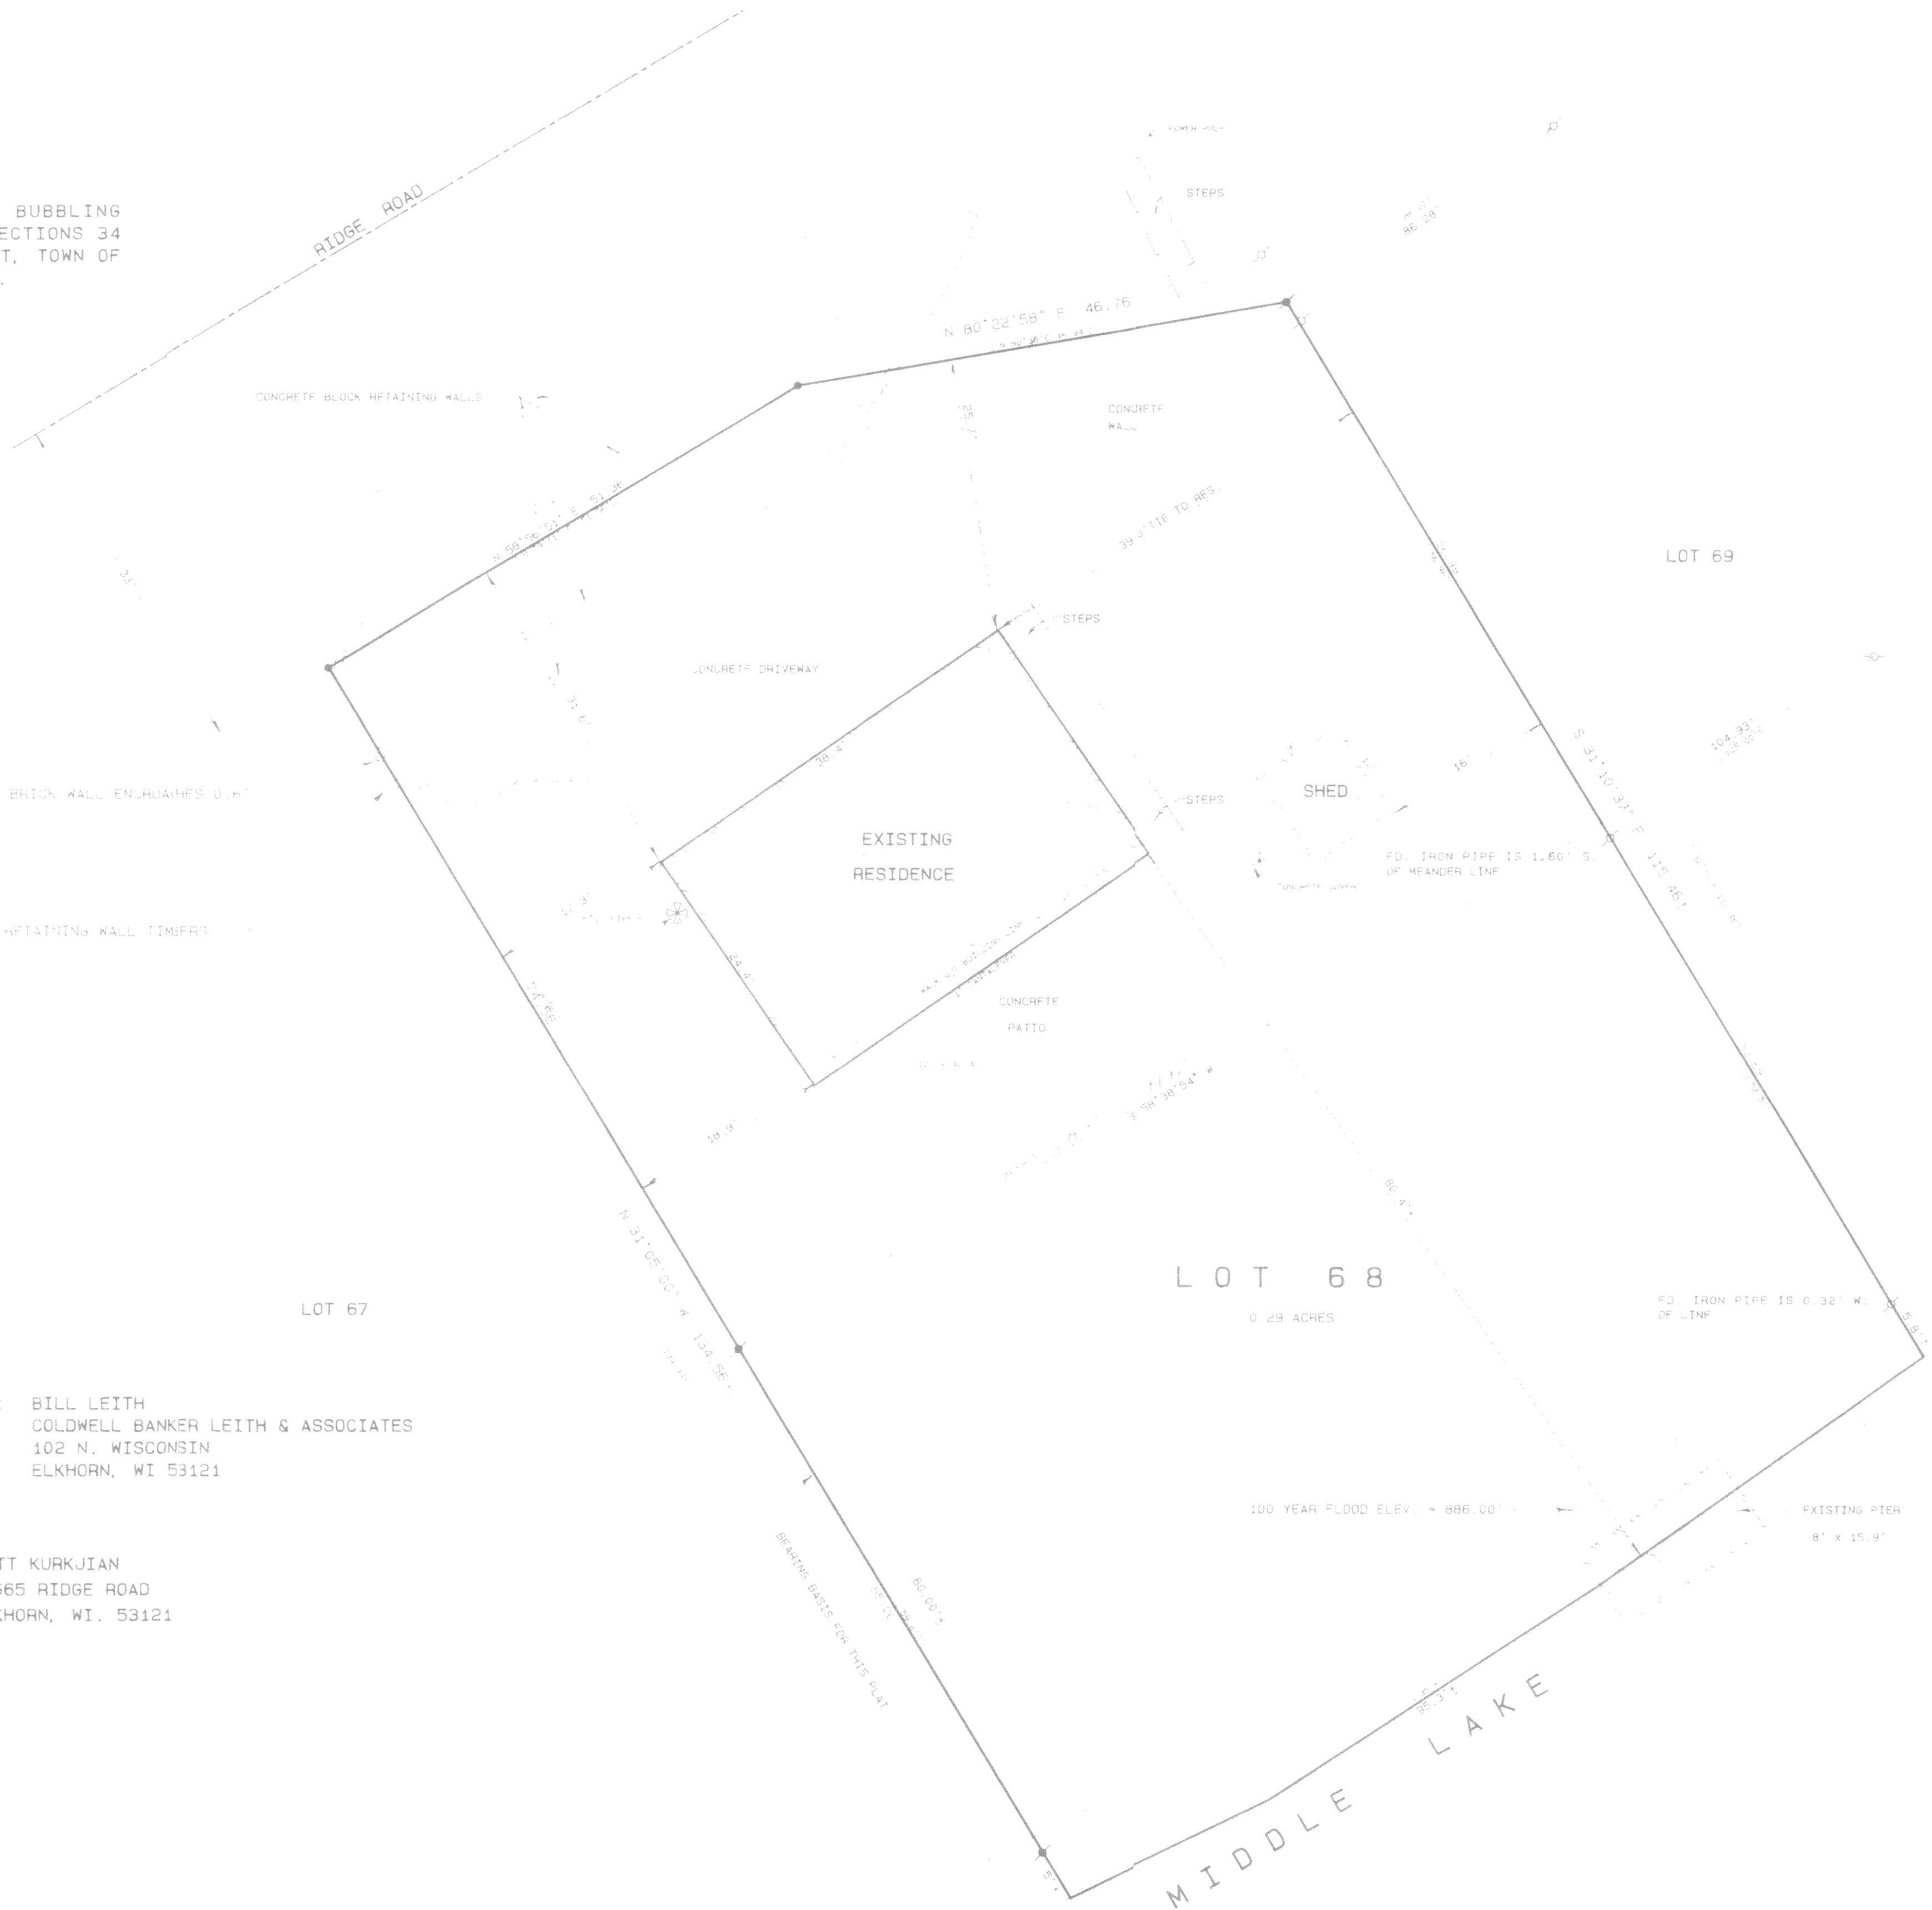

ORDERED BY: BILL LEITH
COLDWELL BANKER LEITH & ASSOCIATES
102 N. WISCONSIN
ELKHORN, WI 53121

OWNER: SCOTT KURKJIAN
W5665 RIDGE ROAD
ELKHORN, WI. 53121

Legend

- FOUND IRON PIPE
- FOUND IRON ROD
- FOUND BRASS LABELED MONUMENT
- FOUND CONCRETE MONUMENT
- CHISEL L.I.T. IN CONCRETE
- SET IRON ROD 24" LONG, WEIGHING 15 LBS. LINEAL FT. 3/4" DIA.
- SET IRON ROD 16" LONG, WEIGHING 4.5 LBS. LINEAL FT. 1/2" DIA.
- RECORDED AS DIMENSION
- EXISTING FENCE

SCALE: 1" = 10 FEET

I hereby certify that the above described property has been surveyed by me, or under my direction, and that the above map is a true representation thereof and shows the size and location of the property, its exterior boundaries, the location of all existing structures and improvements, easements, covenants, and other matters as shown on the map. This survey is made for the use of the present owners of the property, and any future who acquire an interest in the same, and is not to be used for any other purpose.



Kenneth B. Abernathy Jr.
KENNETH B. ABERNATHY, JR.
WISCONSIN REGISTERED LAND SURVEYOR,
S-1594

Date: JULY 21, 2003 Job No. 98.1203

