


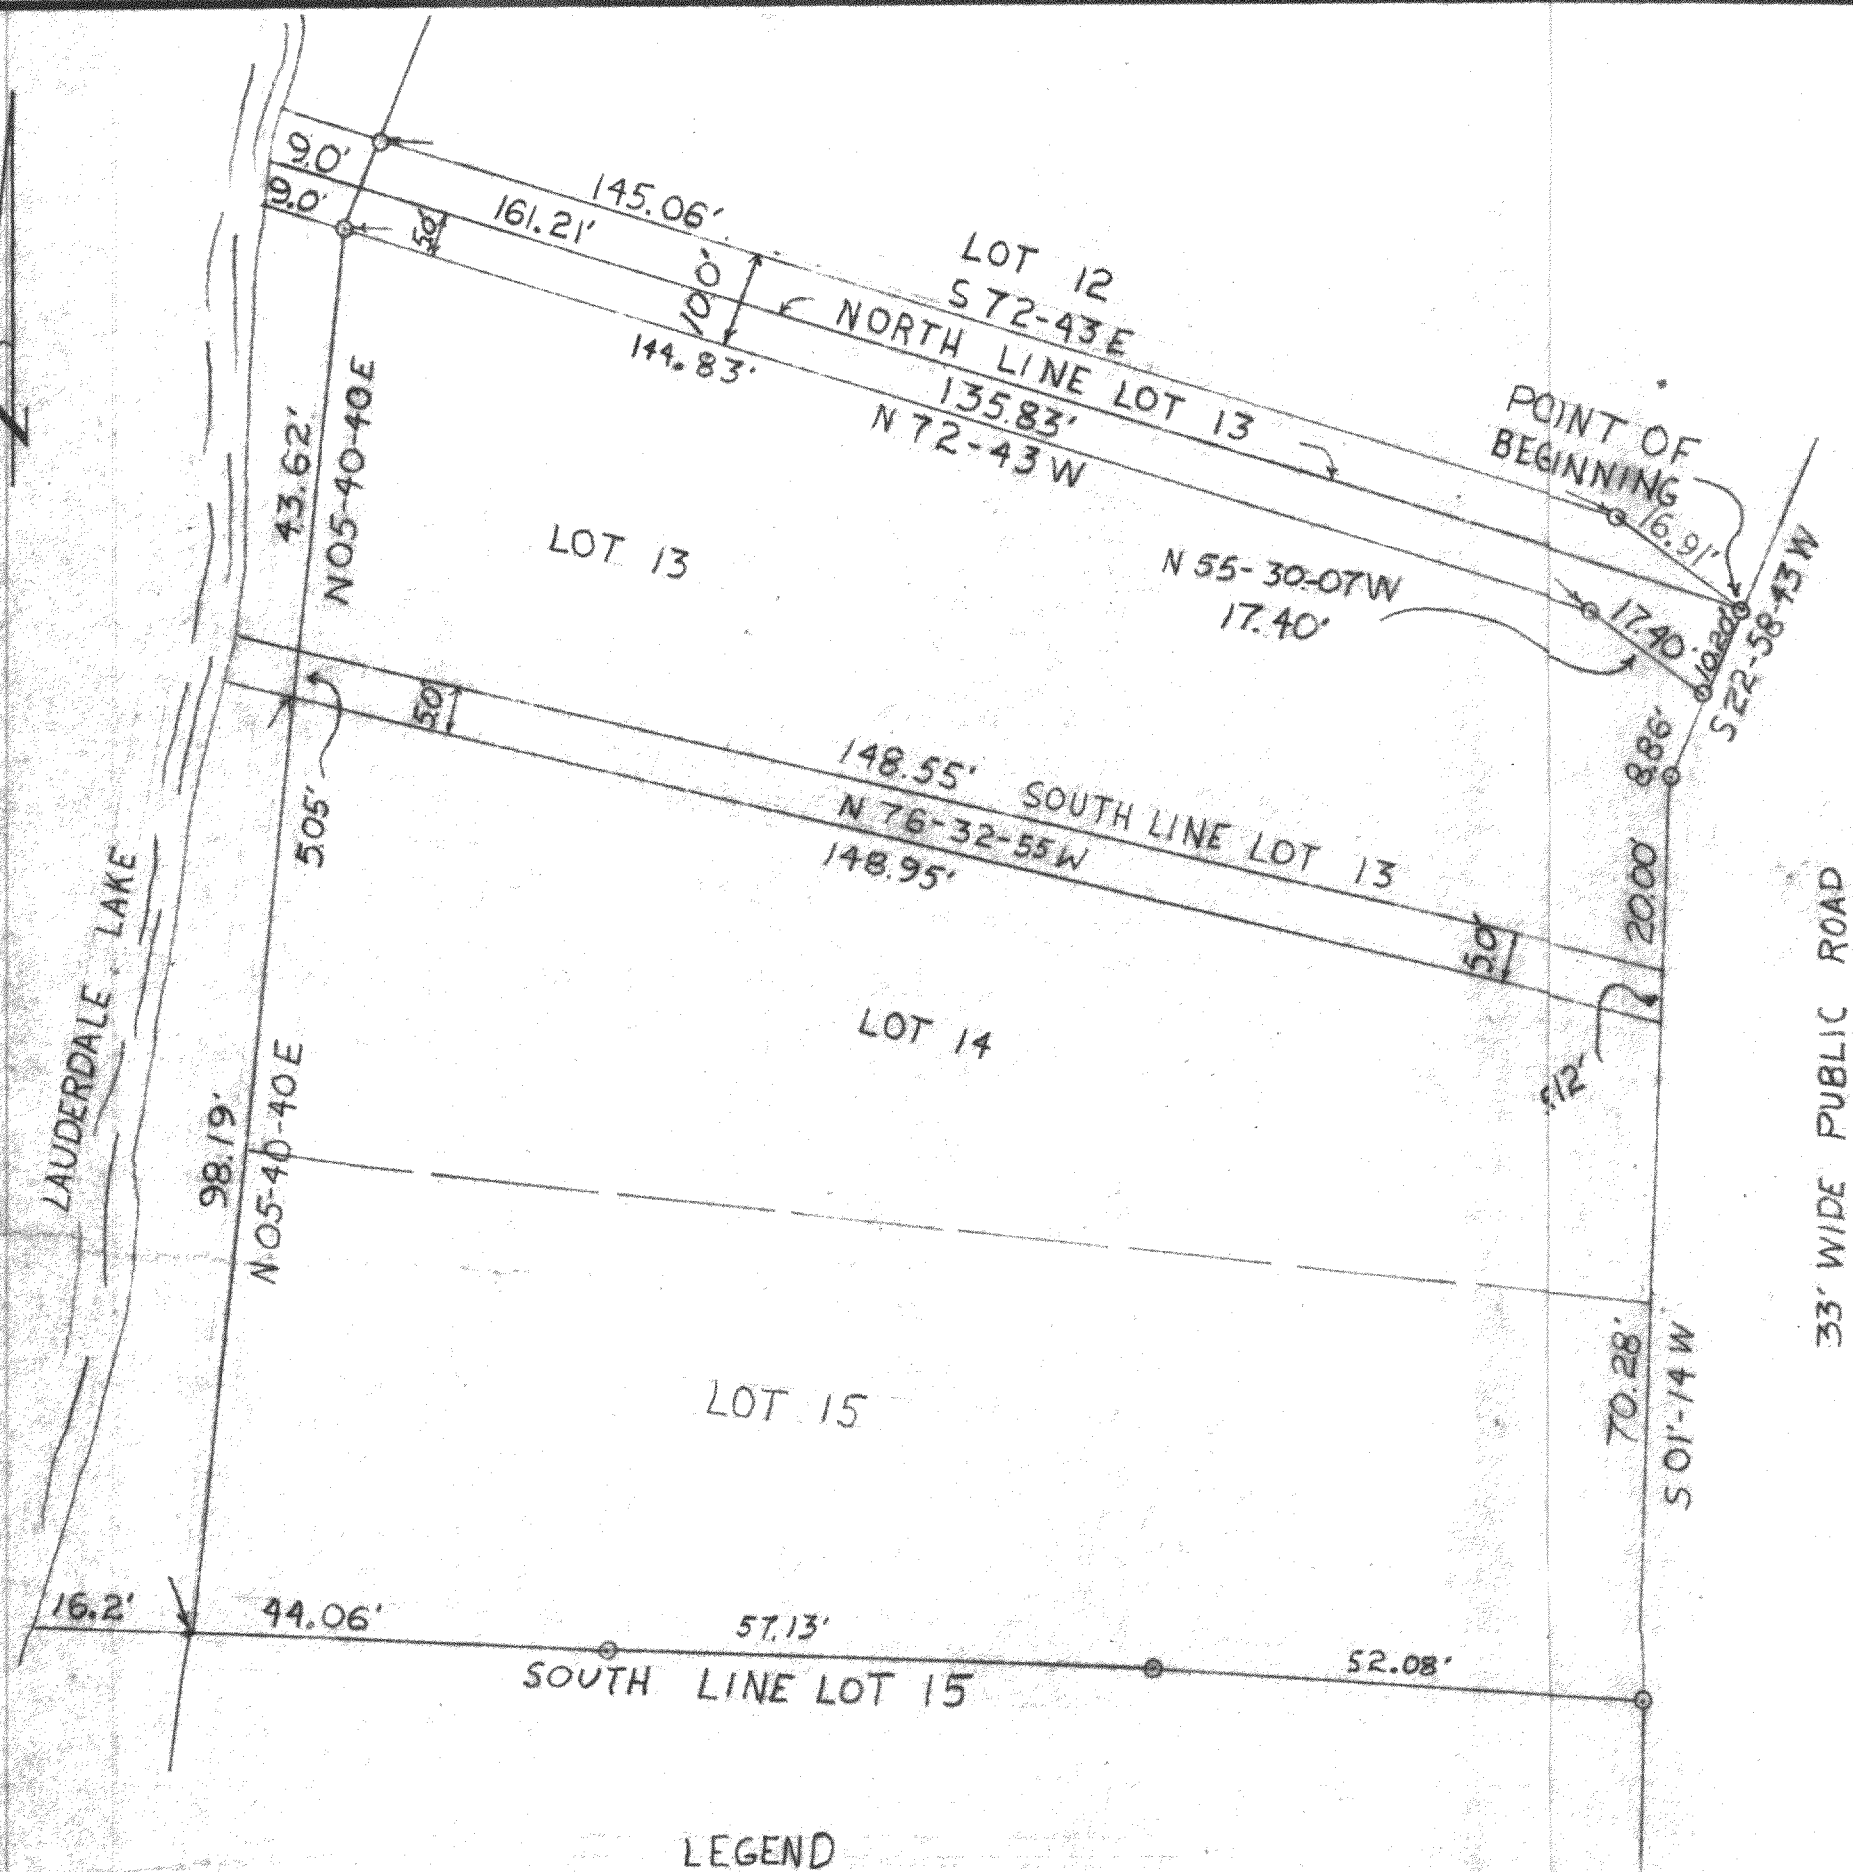


DESCRIPTION:

JOHN E. CORY AND BELLE CORY TO LAUREL AND EDNA E. GILLOGY LOT 13 AND THE NORTH 5.0' FEET OF LOT 14 DROUGHTVILLE PARK, LOCATED IN THE S.W. 1/4 OF SEC. 25, T4N, R16E, WALWORTH COUNTY WISC; EXCEPTING THEREFROM THAT PART OF LOT 13 CONVEYED TO WILLIAM D. SALLY AND PATRICIA A. SALLY AND DESCRIBED AS FOLLOWS TO-WIT: COMMENCING AT THE NE CORNER OF LOT 13, THENCE S22-58'-43" W 10.20' FEET, THENCE N55-30'-07" W 17.40' FEET, THENCE N72-43' W 144.83' FEET, MORE LESS TO THE SHORE OF LAUDERDALE LAKE, THENCE NE'LY ALONG SAID SHORE 5.0' FEET, MORE OR LESS TO THE NORTH LINE OF LOT 13, THENCE S72-43'E 16.21' FEET, MORE OR LESS ALONG SAID NORTH LOT LINE OF LOT 13, TO THE PLACE OF BEGINNING.

CERTIFICATE:

I, JOSEPH M. BIAGI, SURVEYOR, DO HEREBY CERTIFY
I HAVE SURVEYED THE LANDS HEREON DESCRIBED.

SIGNED DEC 9, 1974

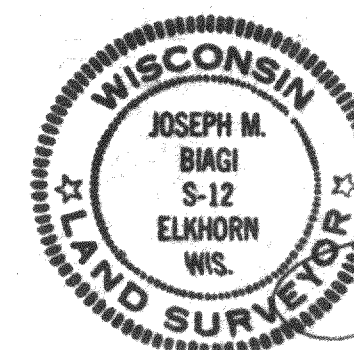

Joseph M. Biagi
JOSEPH M. BIAGI
RES # 12

REVISIONS			LAUREL + EDNA GILLOGY		
NO.	DATE	BY	LOT 13 + N. 5.0' LOT 14 DROUGHTVILLE PARK		
1			DRAWN BY HWG	SCALE 1"=20'	MATERIAL DRAWING NO.
2				DATE 12-6-74	
3				APP'D	
4					
5					