



PLAT OF SURVEY

- OF -

ALL THAT PIECE OR PARCEL OF LAND LYING AND BEING IN THE PLAT OF OAK PARK, WHICH PLAT IS ON RECORD IN THE REGISTER OF DEEDS OFFICE IN AND FOR WALWORTH COUNTY, WISCONSIN IN VOLUME 6 OF PLATS ON PAGE 18, AND BEING ALSO A PORTION OF LOTS 14 AND 15 OF SAID RECORD PLAT, DESCRIBED AS FOLLOWS, TO WIT: BEGINNING AT THE NORTHEASTERLY CORNER OF LOT 15 OF SAID PLAT; THENCE SOUTHEASTERLY THROUGH SAID LOT 15 TO A STAKE ON THE BASE LINE OF SAID PLAT, CROSSING THROUGH SAID LOT 15, 24.8 FEET NORTHEASTERLY FROM THE INTERSECTION OF SAID BASELINE WITH THE WESTERLY LINE OF LOT 15 AND CONTINUING ON SAID LINE TO THE SHORE OF MIDDLE LAKE AT LOW WATER LINE; THENCE NORTHEASTERLY ALONG SAID SHORELINE TO A POINT; THENCE NORTHWESTERLY ON A LINE TO A STAKE ON THE ABOVE MENTIONED BASE LINE, PASSING THROUGH SAID LOT 14, 9.80 FEET NORTHEASTERLY OF THE INTERSECTION OF SAID BASE LINE WITH THE WESTERLY LINE OF LOT 14 AND CONTINUING ON SAID COUSE TO A STAKE ON THE NORTHWESTERLY LINE OF SAID LOT 14; THENCE SOUTHWESTERLY ALONG SAID LINE 50.00 FEET TO THE PLACE OF BEGINNING.

J.K. SURVEYING INC.
N3705 WILLOWBEND LANE
LAKE GENEVA, WI. 53147
262-248-3697

PREPARED FOR: TOM MARTIN
KEEFE REAL ESTATE INC.
980-A N. WISCONSIN ST.
ELKHORN WI. 53121
AND
JOHN M. CRUGER
W3577 ORIOLE DR.
ELKHORN, WI. 53121

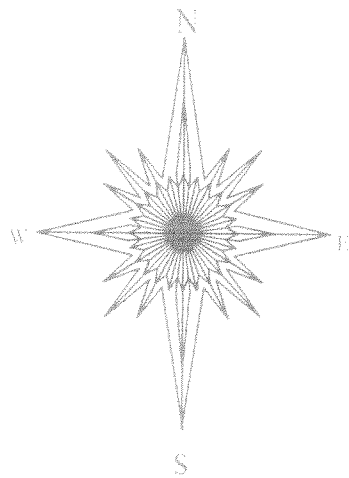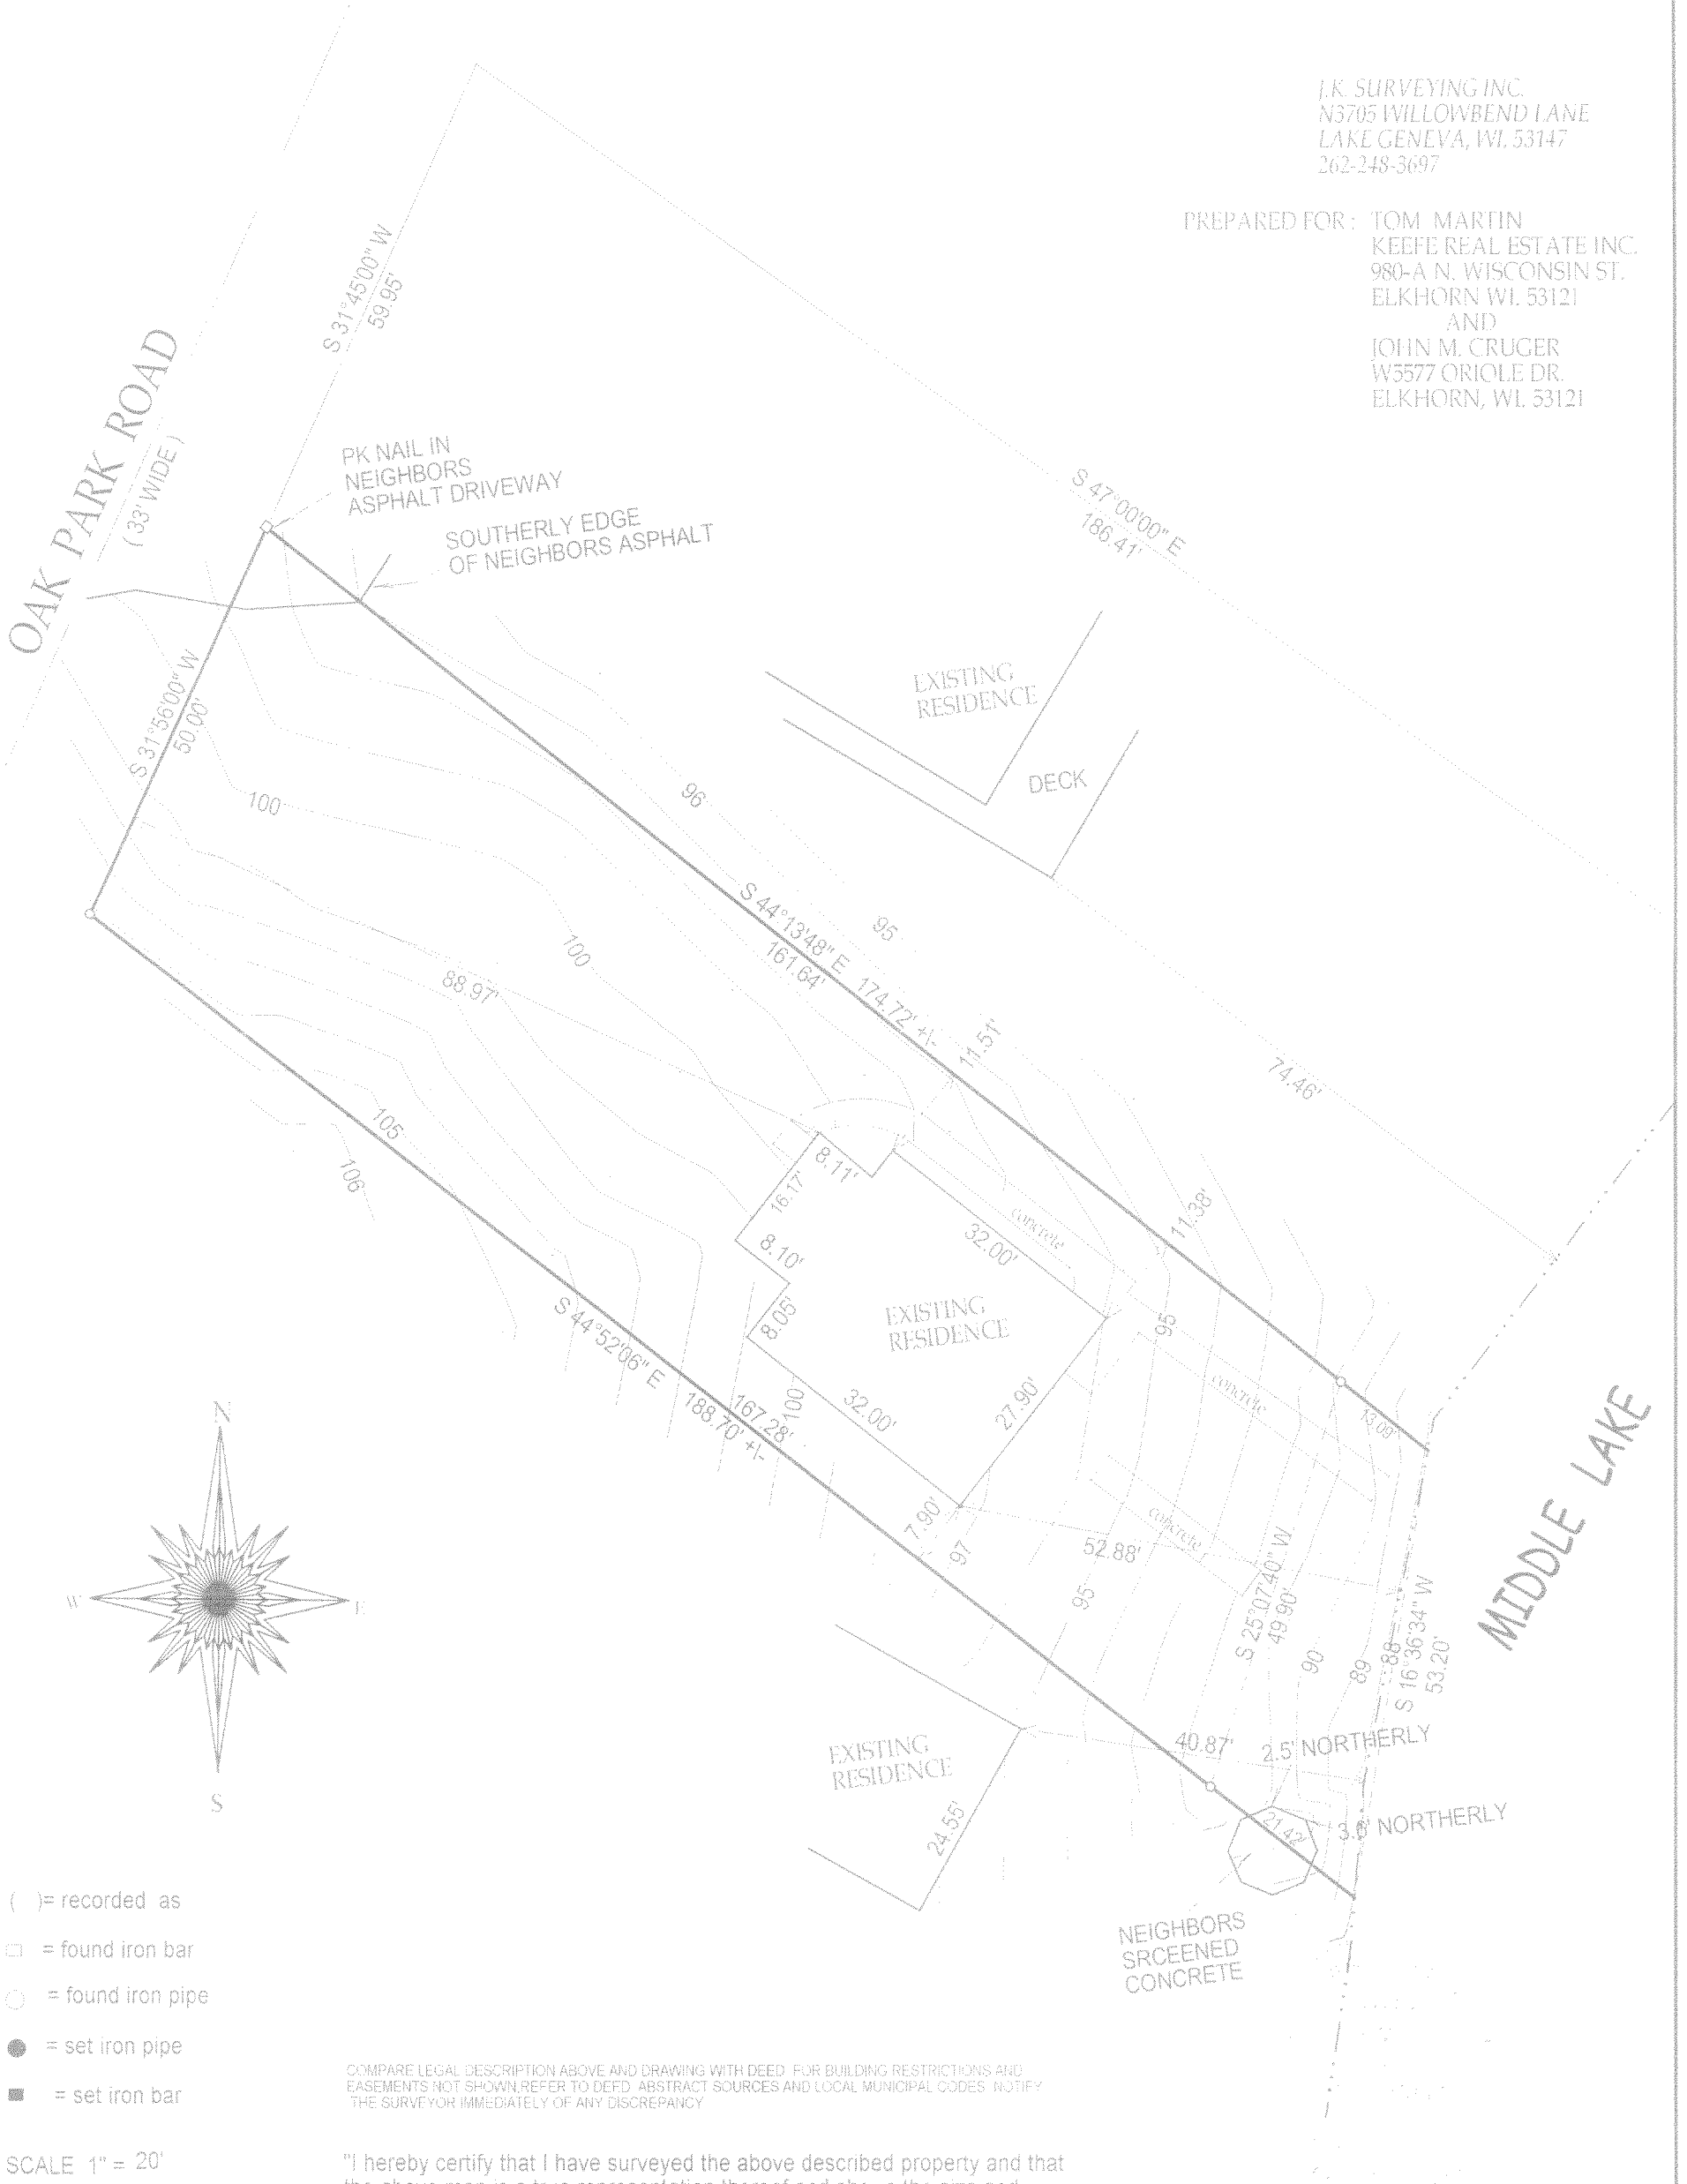

- () = recorded as
- = found iron bar
- = found iron pipe
- = set iron pipe
- = set iron bar

SCALE 1" = 20'

JOB # 03-377

TAX ID #

hop 00013

COMPARE LEGAL DESCRIPTION ABOVE AND DRAWING WITH DEED. FOR BUILDING RESTRICTIONS AND EASEMENTS NOT SHOWN, REFER TO DEED. ABSTRACT SOURCES AND LOCAL MUNICIPAL CODES. NOTIFY THE SURVEYOR IMMEDIATELY OF ANY DISCREPANCY.

"I hereby certify that I have surveyed the above described property and that the above map is a true representation thereof and shows the size and location of all visible structures, apparent easements and encroachments if any."

This survey is made for the present owners of the property, and those who purchase, mortgage, or guarantee the title thereto, within one year from the date hereof.

DATED THIS 1 ST. DAY OF JULY 20 03

JEFFREY L KIMPS S - 2436
Wisconsin Registered Land Surveyor
(original if signed in red)

416-1929