

PREPARED FOR:
JIM RADECKI
P.O. BOX 24
MARENGO IL
60152

PLAT OF SURVEY


- OF -

LOT 1 OF DON JEAN ESTATES A SUBDIVISION LOCATED IN THE SOUTHWEST
1/4 OF THE SOUTHEAST 1/4 OF SECTION 36, TOWN 4 NORTH, RANGE 16 EAST,
TOWN OF LAGRANGE, WALWORTH COUNTY, WISCONSIN.

J.K. SURVEYING INC.
N3705 WILLOWBEND LANE
LAKE GENEVA, WI, 53147
262-248-3697

AFFIDAVIT OF CORRECTION FOR SURVEY FILED AT THE WALWORTH
COUNTY SURVEYORS OFFICE ON 2/20/2003 AS SURVEY NO. 416-1868

NOTE: THIS LINE DOES NOT APPEAR TO
BE THE ORIGINAL WEST LINE OF
DON JEAN ESTATES.
WI. D.O.T. MONUMENT

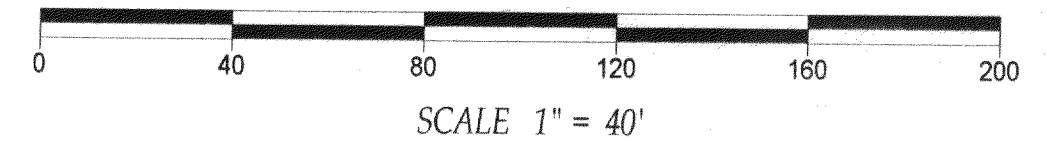


COMPARE LEGAL DESCRIPTION ABOVE AND DRAWING WITH DEED, FOR BUILDING RESTRICTIONS AND
EASEMENTS NOT SHOWN, REFER TO DEED, ABSTRACT SOURCES AND LOCAL MUNICIPAL CODES. NOTIFY
THE SURVEYOR IMMEDIATELY OF ANY DISCREPANCY.

"I hereby certify that I have surveyed the above described property and that
the above map is a true representation thereof and shows the size and
location of all visible structures, apparent easements and encroachments
if any."

This survey is made for the present owners of the property, and those who
purchase, mortgage, or guarantee the title thereto, within one year from
the date hereof.

DATED THIS 9TH, DAY OF MAY, 2003

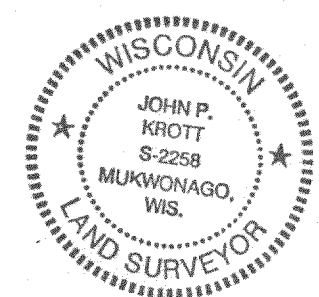

John P. Krott
JOHN KROTT S - 2258
Wisconsin Registered Land Surveyor
(original if signed in red)

SOUTHEAST CORNER OF
DON JEAN ESTATES


SOUTHEAST CORNER OF
C.S.M. 1996

- () = recorded as
- = found iron bar
- = found iron pipe
- = set iron pipe
- = set iron bar

SCALE 1" = 40'

JOB # 03-071z

TAX ID # HDJ00001

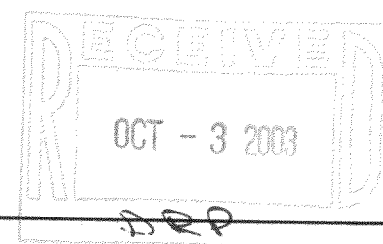

416-1934