

FARRIS, HANSEN & COOPER, INC.

ENGINEERING, SURVEYING & LAND PLANNING


715 W. WALWORTH ST. - BOX 487 - ELKHORN, WI.

PHONE: 414-723-2098

COUNTRY CLUB DRIVE . 33' WIDE

(FORMERLY WILKINSON RD.)

BENCH MARK: ASSUMED
ELEVATION OF 100.00
TOP OF IRON PIPE

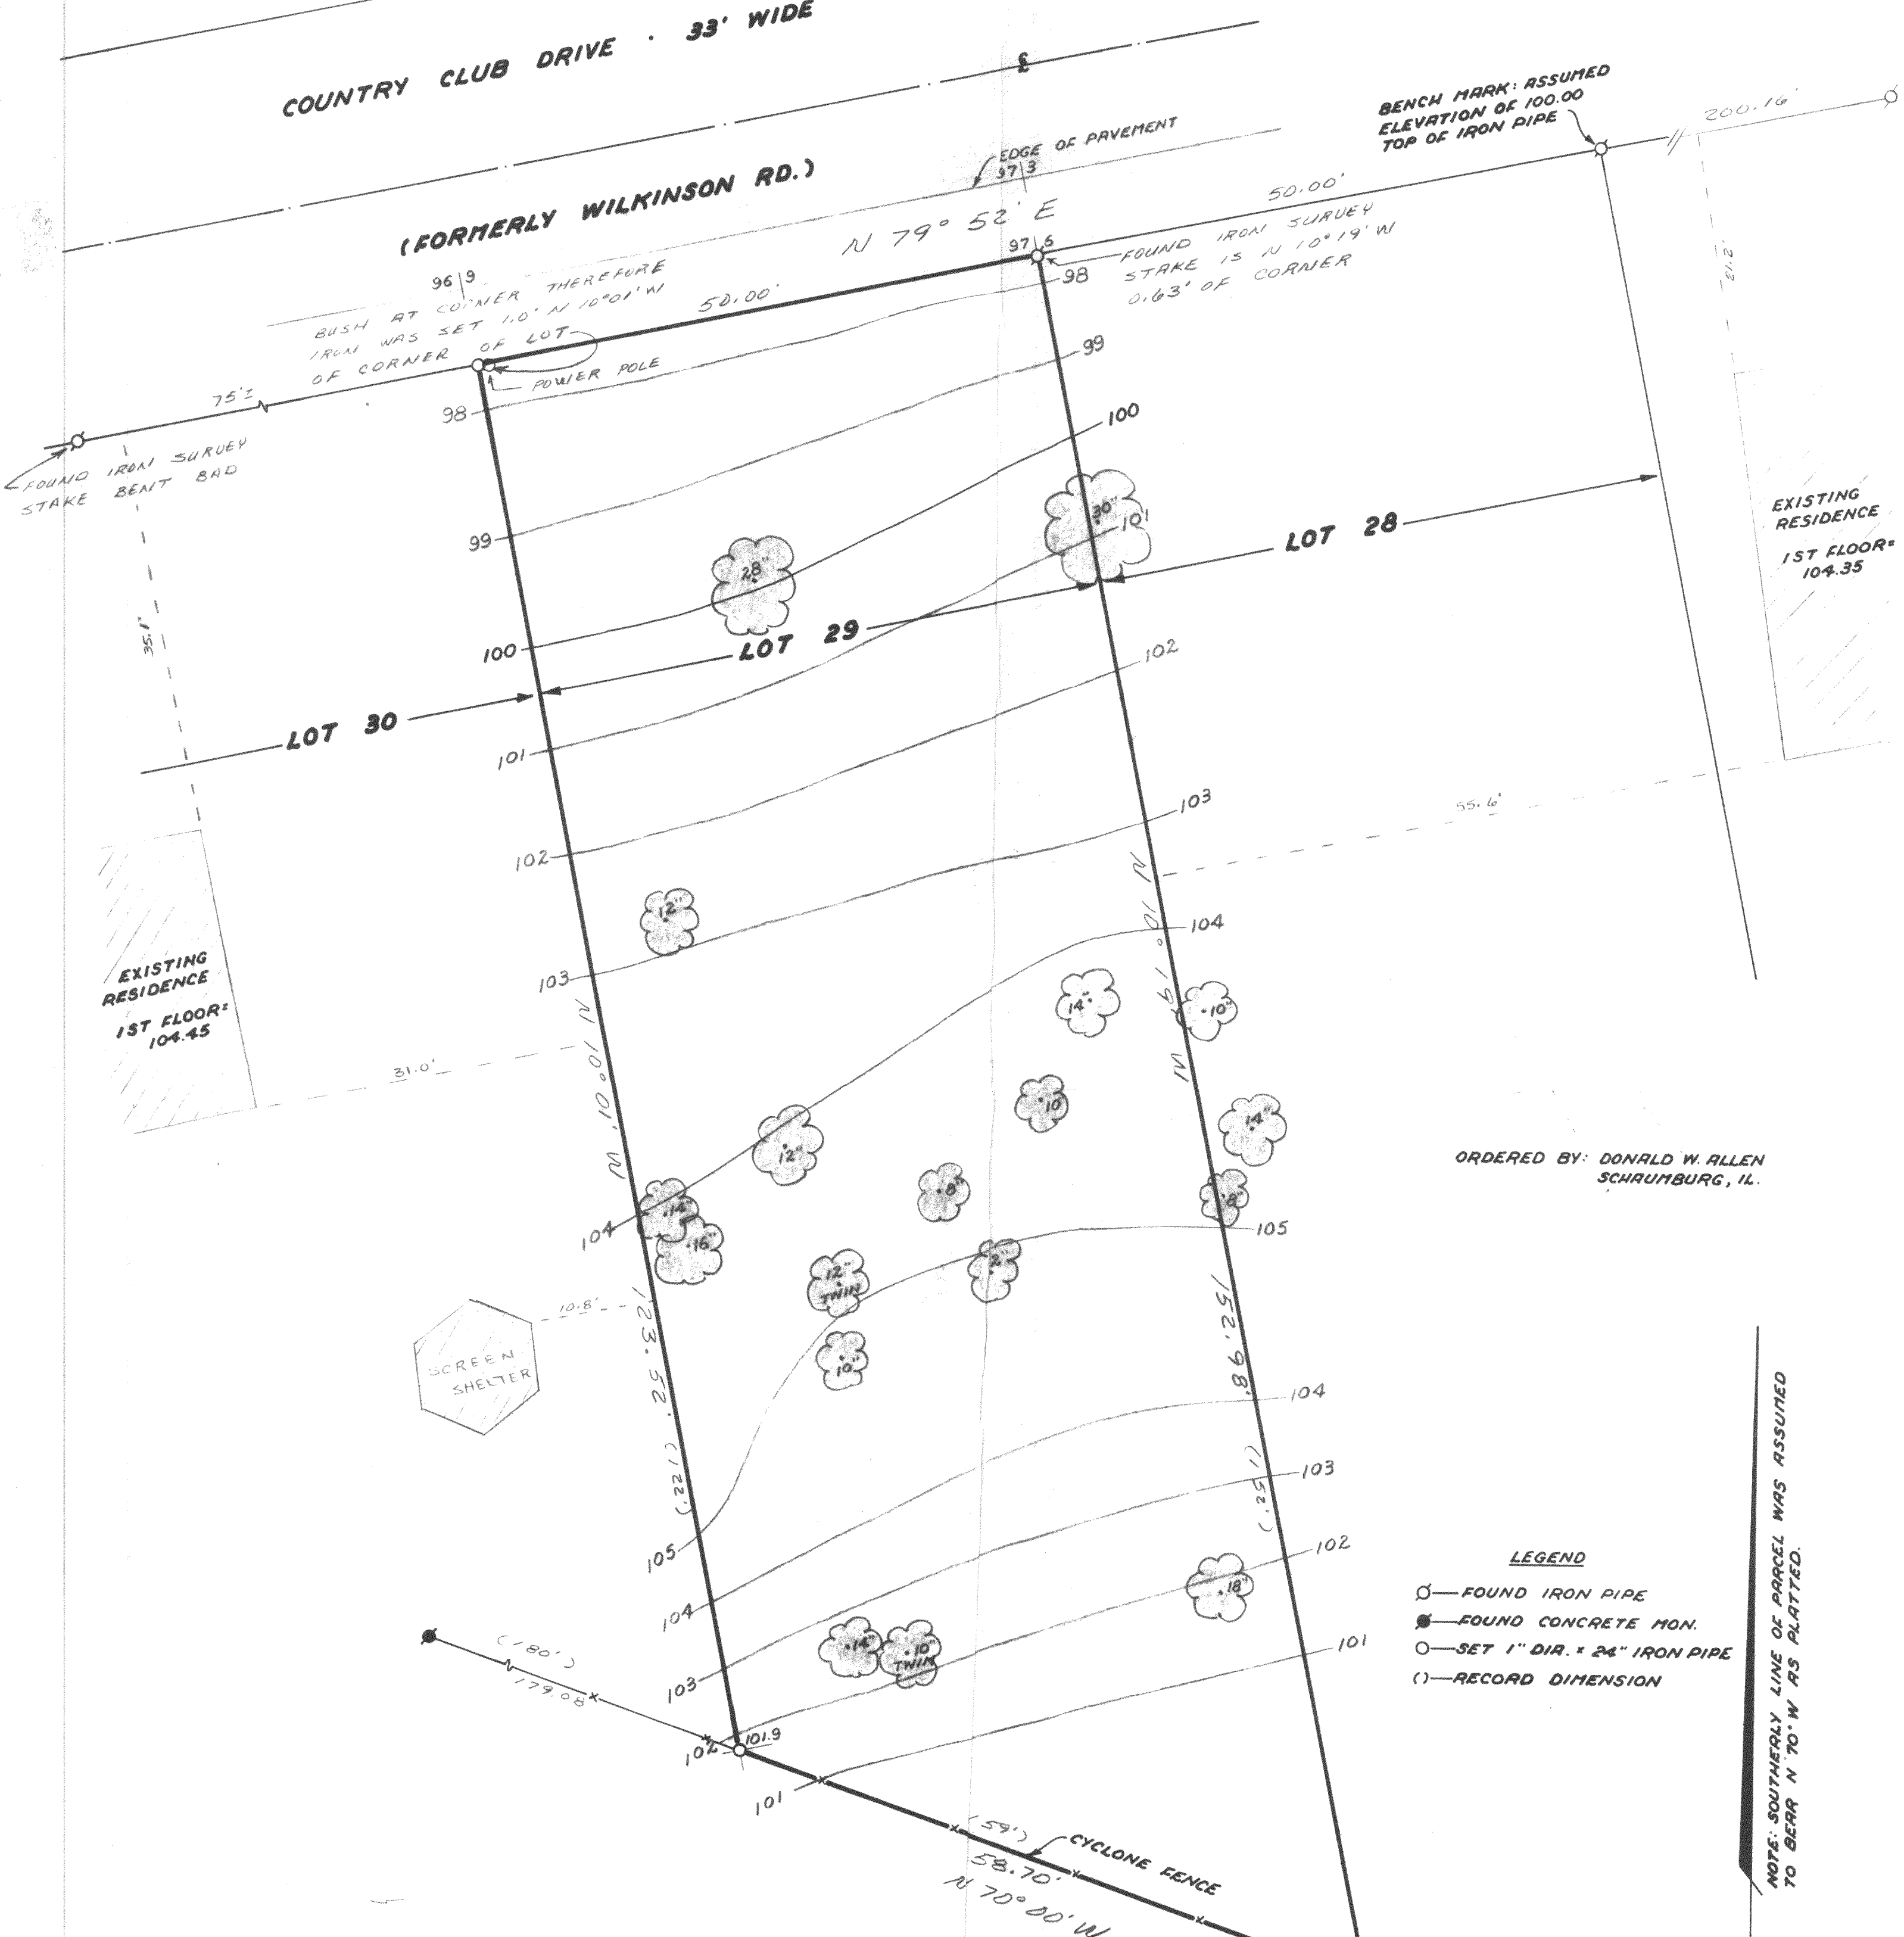


PLAT OF SURVEY & TOPO OF
LOT 29, LAUDERDALE HEIGHTS, TOWN
OF LA GRANGE, WALWORTH COUNTY, WIS.

I HEREBY CERTIFY that I have surveyed the property described hereon and that this Plat of Survey is a true and accurate representation of the lot lines, and the topography located thereon, to the best of my professional knowledge and belief.

Daniel D. Cooper
Daniel D. Cooper, RLS No. 1464

Dated this 10th day of June, 1980.

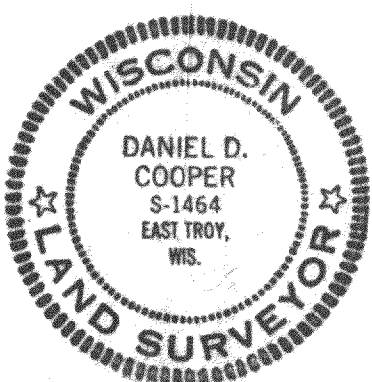

BLOCK CORNER AS
RECREATED FROM IRONS
SHOWN ON SURVEY OF
GOLF COURSE

SCALE IN FEET (1"=10')

PROJECT NO. 446-194-F