

Plat of Survey

of

Lot 3 of Certified Survey Map No. 1430,

recorded in Vol. 6 of Certified Survey Maps of Walworth County on Page 318 and located in the Northeast 1/4 of Section 25, Town 4 North, Range 16 East, Town of LaGrange, Walworth County, Wisconsin

Surveyed for: **Bob & Jan Baker**
W5039 Robinson Lane
Elkhorn, Wisconsin 53121

Robinson Lane (50' Wide)

(N71°40'17"E 54.81')
N71°45'33"E 54.63'


(N74°20'48"E 91.05')
N74°20'48"E 91.05'

101.32'

Gravel Driveway

Lot 3
0.915 Acre
39,878 Sq. Ft.

overhead wires

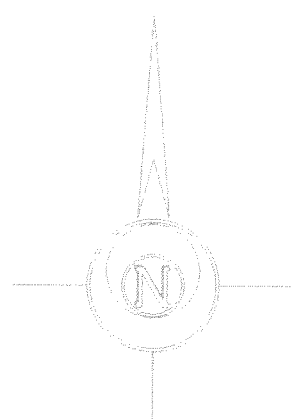

Bearings reference to Certified Survey Map No. 1430

Lot 4

(N0°15'52"W 266.25')
N0°15'52"W 266.25'

54.0'

House
W5039
Under Construction

Sloop

22.7'

(S0°17'58"E 302.46')
S0°17'58"E 302.46'

Lot 2

S87°46'13"W 140.00'

Tax Parcel
HLG 2500024A

Copyright © 2003 by Jensen & Olson Land Surveying, LLC

All rights reserved. No part of this survey plat may be reproduced or transmitted in any form by any means - graphic, electronic, or mechanical - including photocopying, tracing, or information storage and retrieval systems - without permission in writing from Douglas G. Olson - Jensen & Olson Land Surveying, LLC.

I, Douglas G. Olson, Wisconsin Registered Land Surveyor, do hereby certify that this survey was performed by me or under my direction in full compliance with the owner's/agent's instructions and Chapter A-E 7 of the Wisconsin Administrative Code "Minimum Standards for Property Surveys" and that this map is an accurate representation thereof to the best of my knowledge and belief.

Douglas G. Olson
Wisconsin Registered Land Surveyor - 2093

Notes: 1) This survey plat is not certified unless signed and sealed in red ink. 2) This survey is subject to Wisconsin lien laws. This Plat of Survey is the notice of intent to file lien. Lien waiver required.

Not Certified Unless
Stamped in Red

2003.171

Sheet 1 of 1 Sheets

Job Reference Number

2003.171

Legend

- Found Iron Pipe
- Recorded Information
- Utility Pole
- Concrete Cover
- Septic Vent
- Asphalt Surface
- Gravel Surface



Jensen & Olson Land Surveying, LLC

45 South Wisconsin Street P.O. Box 322
Elkhorn, Wisconsin 53121
Telephone (262) 723-3434
Facsimile (262) 723-8044

Scale in Feet

1" = 20'



Survey Date: October 29, 2003
Revisions:

HA1430-3

416-1956