


Plat of Survey

of
Lot 24 of Block 2 of Pebble Beach,
a subdivision located in the Northeast 1/4 of Section 26, Town 4
North, Range 16 East, Town of LaGrange, Walworth County, Wisconsin.

Surveyed for: **Thelen Total Construction, Inc.**
N5896 Highways 12 & 67
Post Office Box 17
Elkhorn, Wisconsin, 53121

Survey Date: November 25, 2003
Revisions:

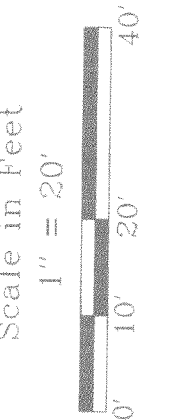



Jensen & Olson Land Surveying, LLC
45 South Wisconsin Street P.O. Box 322
Elkhorn, Wisconsin, 53121
Telephone (262) 723-3434
Facsimile (262) 723-8044




Legend
Found Iron Pipe
() Recorded Information
Manhole
Electric
Quantity of Pipe
Quantity of Pedestal or box
Quantity of Surface
Quantity of Tree
Quantity of Tree

Sheet 1 of 1 Sheets
Job Reference Number
2003.189

2003.189

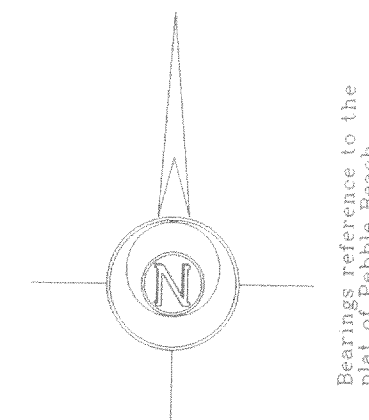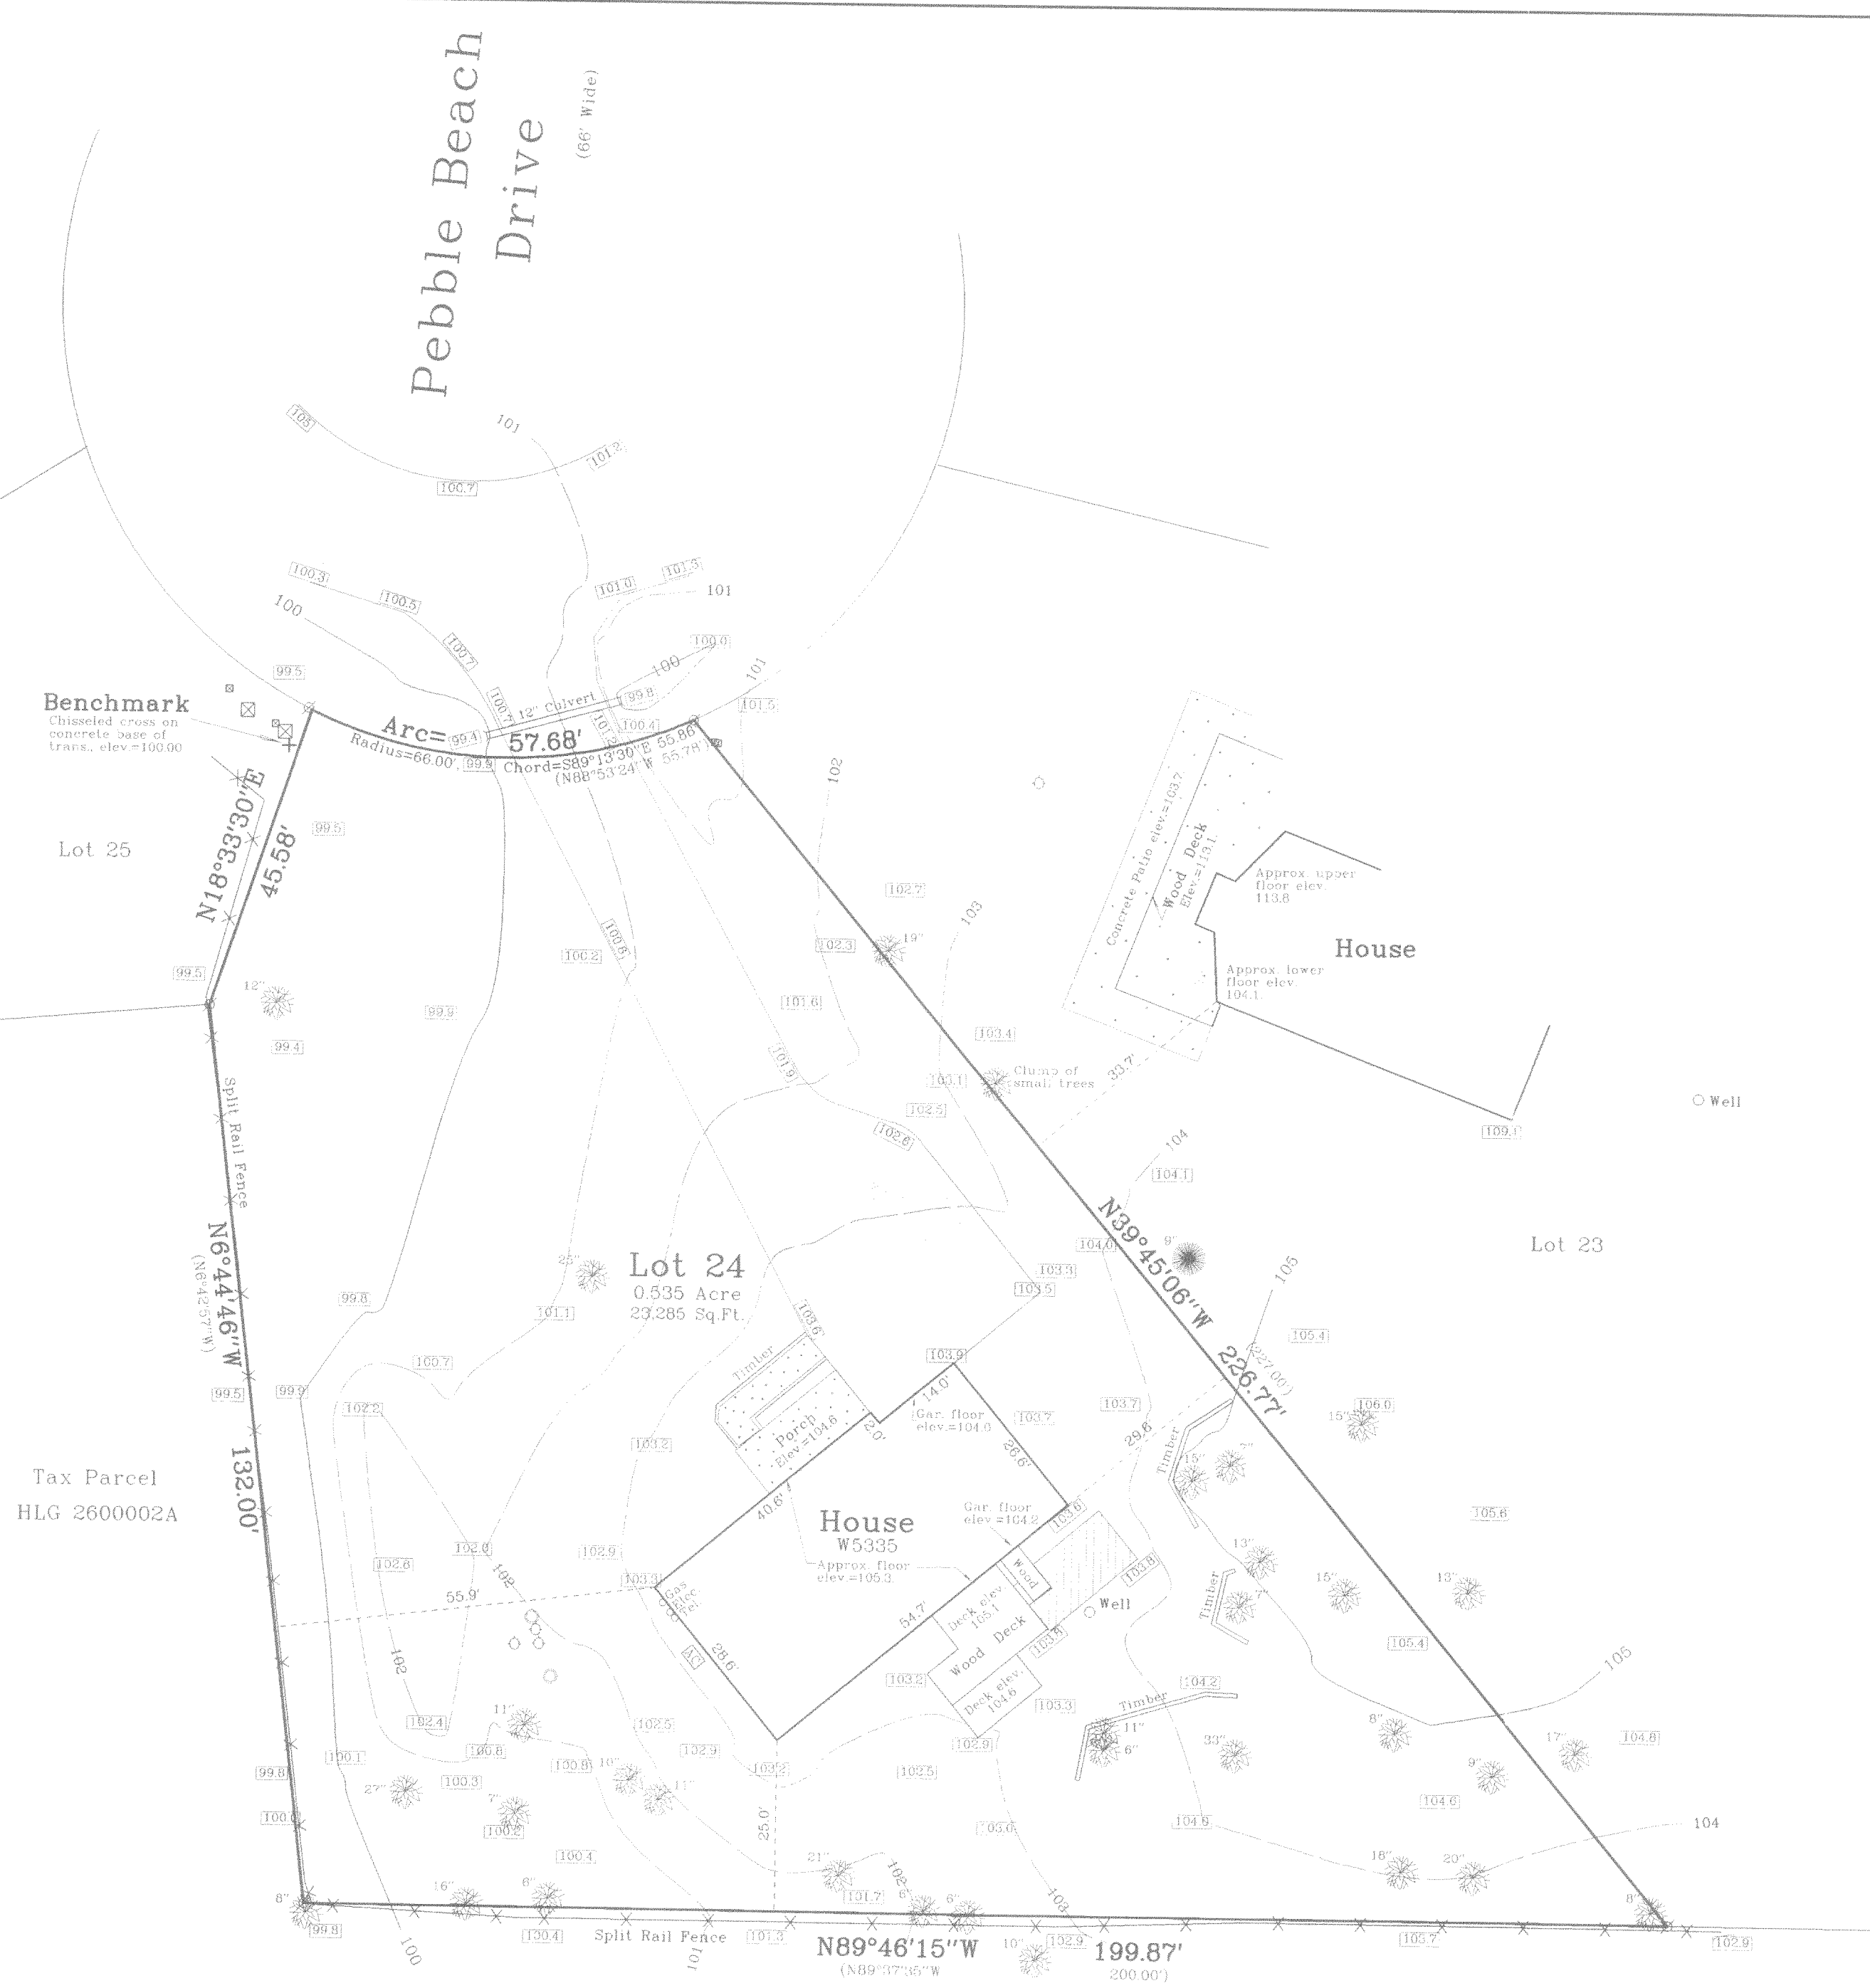

Bearings reference to the
plat of Pebble Beach.

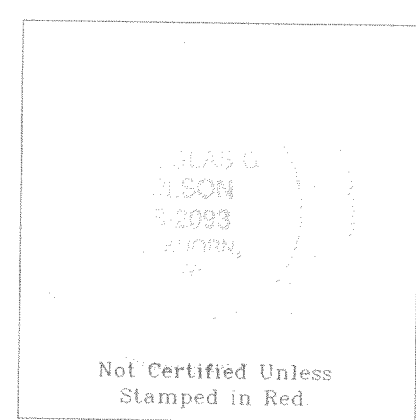

Notes: 1) This survey plat is not
certified unless signed
and sealed in red ink.
2) This survey is subject to Wisconsin lien laws.
This Plat of Survey is the notice of intent
to file lien. Lien waiver required.

Copyright © 2003 by Jensen & Olson Land Surveying, LLC.
All rights reserved. No part of this survey plat may be reproduced
or transmitted in any form by any means - graphic, electronic, or
mechanical, including photocopying, tracing, or information storage
and retrieval systems - without permission in writing from Douglas
G. Olson, Jensen & Olson Land Surveying, LLC.

I, Douglas G. Olson, Wisconsin Registered Land Surveyor,
do hereby certify that this survey was performed by me or under my
direction in full compliance with the owner's/agent's instructions
and Chapter A-E 7 of the Wisconsin Administrative Code "Minimum
Standards for Property Surveys", and that this map is an accurate
representation thereof to the best of my knowledge and belief.

Douglas G. Olson
Wisconsin Registered Land Surveyor - 2093

HPE-47
kw
416-1960