


Plat of Survey

of
Lot 16 of Strawberry Banke Plantation,
a subdivision located in the Southwest 1/4 of Section 36,
Town 4 North, Range 16 East, Town of LaGrange, Walworth
County, Wisconsin.

Surveyed for: **John Parent**
13025 Golf Parkway
Brookfield, Wisconsin. 53005

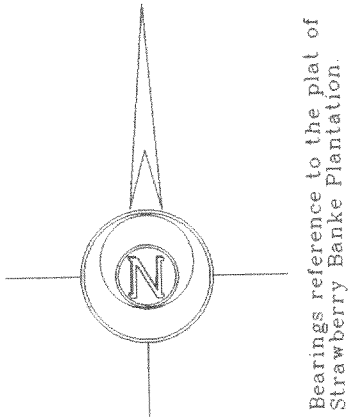

Note: The proposed garage was staked as instructed by the owner.
All setbacks must be approved by the building inspector PRIOR
to construction.


Plantation Road (76' Wide)

Lot 16
0.405 Acre
17,625 Sq.Ft.

Poured Concrete Foundation
W5139

Proposed Garage

House

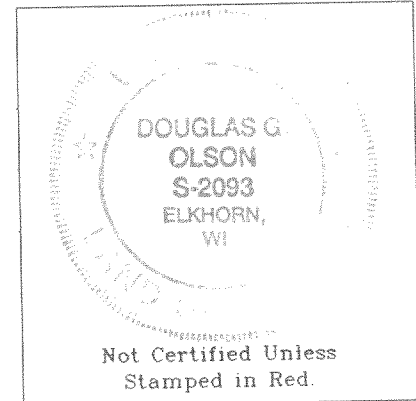

- Notes: 1) This survey plat is not certified unless signed and sealed in red ink.
- 2) This survey is subject to Wisconsin lien laws. This Plat of Survey is the notice of intent to file lien. Lien waiver required.


Copyright © 2004 by Jensen & Olson Land Surveying, LLC.

All rights reserved. No part of this survey plat may be reproduced or transmitted in any form by any means - graphic, electronic, or mechanical, including photocopying, tracing, or information storage and retrieval systems - without permission in writing from Douglas G. Olson, Jensen & Olson Land Surveying, LLC.

I, Douglas G. Olson, Wisconsin Registered Land Surveyor, do hereby certify that this survey was performed by me or under my direction in full compliance with the owner's/agent's instructions and Chapter A-E 7 of the Wisconsin Administrative Code "Minimum Standards for Property Surveys"; and that this map is an accurate representation thereof to the best of my knowledge and belief.

Douglas G. Olson
Wisconsin Registered Land Surveyor - 2093

Survey Date: August 28, 2003.
Revisions: No. 1 - Proposed House location
No. 2 - Foundation

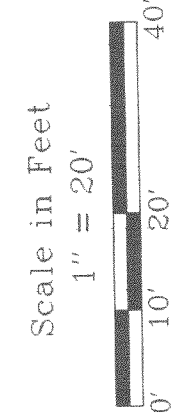

Jensen & Olson Land Surveying, LLC



45 South Wisconsin Street
Elkhorn, Wisconsin. 53121
P.O. Box 322
Telephone (262) 723-3434
Facsimile (262) 723-8044


Legend

- Found Iron Pipe
- Set Iron Rod, 3/4" dia.
- Set Wood Stake, Aug. 28, 2003
- Recorded Information
- Utility Pole
- Utility Pedestal

Sheet 1 of 1 Sheets

Job Reference Number
2003.043

2003.043

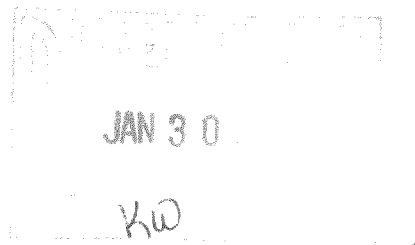

HSP-16

416-1962