


ABELL
SURVEYING & MAPPING

DELAVAN, WISCONSIN 53115

414-728-6737

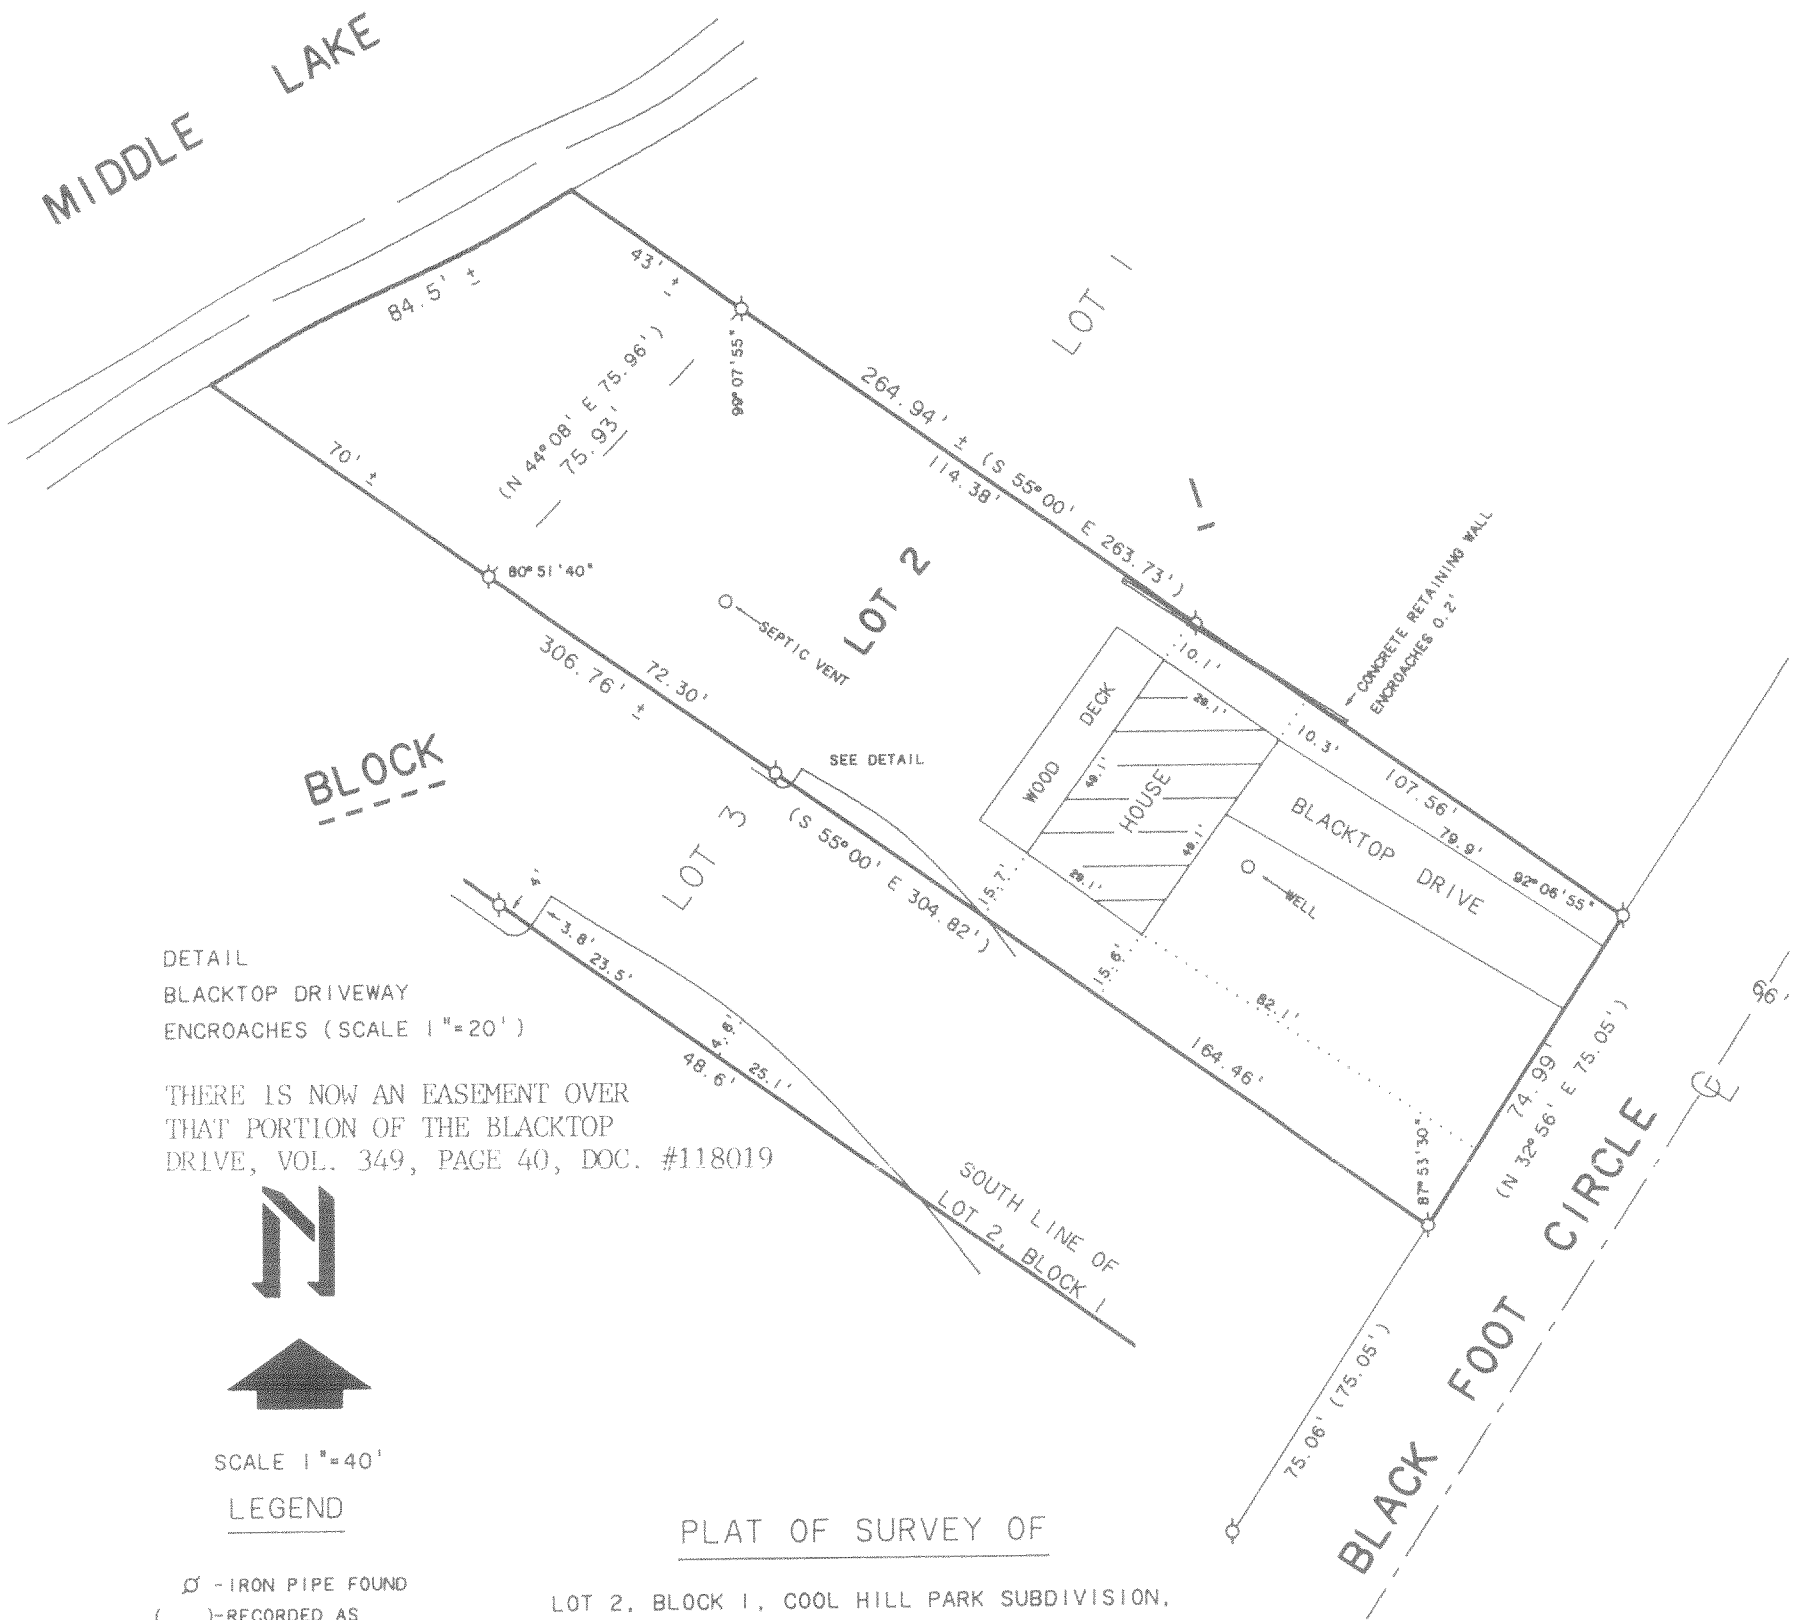

NOTE: LOCATION OF BLACKTOP DRIVE IS
APPROXIMATE DUE TO SNOW COVER.

NOTE: EXISTING LANDSCAPING TIES ARE
PARTIALLY INTO ROAD RIGHT-OF-WAY.

ORDERED BY: COLONY REALTY
16 E. WALWORTH ST.
ELKHORN, WI. 53121

REMARKED CORNERS ONLY
ON SEPTEMBER 30, 2003

ORDERED BY: ALICE WYLIE
16 W. GRANT PLACE
CHICAGO, IL 60614

I HEREBY CERTIFY THAT I HAVE SURVEYED THE ABOVE DESCRIBED PROPERTY AND THAT THE ABOVE MAP IS A TRUE REPRESENTATION THEREOF AND SHOWS THE SIZE AND LOCATION OF THE PROPERTY, ITS EXTERIOR BOUNDARIES, THE LOCATION OF ALL VISIBLE STRUCTURES AND DIMENSIONS OF ALL PRINCIPAL BUILDINGS THEREON, BOUNDARY FENCES, APPARENT EASEMENTS, ROADWAYS AND VISIBLE ENCROACHMENTS, IF ANY, TO THE BEST OF MY KNOWLEDGE AND BELIEF.

THIS SURVEY IS MADE FOR THE USE OF THE PRESENT OWNERS OF THE PROPERTY, AND ALSO THOSE WHO PURCHASE, MORTGAGE, OR GUARANTEE THE TITLE THERETO WITHIN ONE (1) YEAR FROM DATE HEREOF.

David F. Abell

DAVID F. ABELL
WISCONSIN REGISTERED LAND SURVEYOR, S-1596

January 16, 1991

REVISED: FEB. 12, 1991

DATE JOB NUMBER - 91013

NOTE: THIS IS NOT A CERTIFIED COPY UNLESS SEALED.

HCH-2

416-1963