




NOTE: 100-YEAR FLOOD ELEVATION OF 886' (FROM PANEL 550 462 0020 B) FALLS ON AND ALONG SHORE AS SHOWN.

GREEN LAKE
WATER ELEV.=884.6'
231' +/- ALONG THE SHORE

PLAT OF SURVEY & AS-BUILT LOCATION ALL OF LOT 8 AND PART OF LOT 8 OF SQUID COMFORT SUBDIVISION AND A PARCEL OF LAND LOCATED IN THE SOUTHEAST 1/4 OF THE FRACTIONAL SECTION 26, TOWN 4 NORTH, RANGE 16 EAST, WALWORTH COUNTY, WISCONSIN

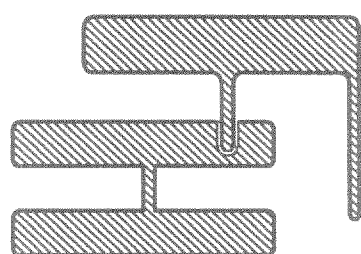

FARRIS, HANSEN & ASSOCIATES, INC.
ENGINEERING — ARCHITECTURE — SURVEYING
7 RIDGWAY COURT P.O. BOX 437
ELKHORN, WISCONSIN 53121
OFFICE: (262) 723-2098 FAX: (262) 723-5886

07/24/2003
TO SHOW SIZE & LOCATION
OF PROPOSED RESIDENCE
ADD PRO GARAGE
01-20-2004
01-28-2004
TO SHOW SIZE & LOCATION
OF AS-BUILT RESIDENCE
& BOAT HOUSE

FEB 24
Ku

ALL OF LOT 46 AND PART OF LOT 8 OF SOLLIC CONCRETE SUBDIVISION, LOCATED IN SECTION 26, TOWN 4 NORTH, RANGE 16 EAST, TOWN OF LUDINGTON, SECTOR 100, COUNTY OF LUDINGTON, that part of said lots that are the parcel of land described as follows: Commence at the Southeast corner of said Lot 46 thence following along the West line of Lot 6 and the East line of Lot 46, thence following along the West line of Lot 8, thence following along the West line of said Lot 46, 50 feet or less; thence S 42° 37' 48" E, 16.14 feet to the Point of Beginning.

Field Lot 5 and part of Lot 5 of Sollic Concrete Subdivision subject to an easement for ingress and egress of property owners to the East, said easement described as follows: Begin at the Southeast corner of said Lot 5, thence S 42° 37' 48" E, 37.80 feet; thence N 11° 02' 17" E, 10.00 feet; thence S 42° 37' 48" E, 17.80 feet; thence N 11° 02' 17" E, 10.00 feet to the Southwesterly line of Lot 6; S 9, 10, 40 feet to the Point of Beginning.

A PART OF LAND LOCATED IN THE SOUTHEAST 1/4 OF FRACATIONAL SECTION 26, T. 4 N., R. 16 E., W. 100' WORTH COUNTY, WISCONSIN, DESCRIBED AS FOLLOWS: COMMENCING AT A POINT N82°52', 130.00 FEET FROM THE SOUTHWEST CORNER OF SAID SECTION 26, T. 4 N., R. 16 E., W. 100' WORTH SURVEY, WHICH PLAT IS ON RECORD IN THE OFFICE OF THE REGISTER OF DEEDS IN AND FOR WALWORTH COUNTY, IN VOLUME 5 OF PLATS ON PAGE 278; THENCE N45°16'W 78.51 FEET; THENCE N83°3'W 50.41 FEET; THENCE S88°30'W 22.75 FEET; THENCE N83°5'W 10.51 FEET; THENCE S88°30'W 22.75 FEET; THENCE S82°52'W 123.00 FEET; THENCE N81°32'W 64.00 FEET; THENCE N82°52'W 188.08 FEET MORE OR LESS TO THE LOW WATER LINE OF GREEN LAKE; THENCE SOUTHERLY ALONG THE LOW WATER LINE OF GREEN LAKE, 105 FEET MORE OR LESS TO A POINT LOCATED N86°54' OF THE PLAT LINE 105 FEET MORE OR LESS TO THE POINT LOCATED N86°54' OF THE PLAT LINE 105 FEET MORE OR LESS TO THE POINT LOCATED N86°54' OF THE PLAT LINE 105 FEET MORE OR LESS TO THE PLACE OF BEGINNING.

LEGEND

○ = FOUND IRON PIPE STAKE
● = FOUND IRON REBAR STAKE
☐ = FOUND CONCRETE MONUMENT
(xxx) = RECORDED AS

PETER S. GORDON R.L.S. 210

DATED: APRIL 2, 2003

To show this I will

PROJECT NO.	6247
DATE	04/02/2003