

WATERMAN, FUGE & ASSOCIATES, INC.
ARCHITECTS - ENGINEERS - SURVEYORS

Client- Mrs. Edwin A. Droegemueller

FORT ATKINSON, WISCONSIN


Walworth County

Address- Box 188 Route 1
Elkhorn, Wisconsin

La Grange, Town of
Sec. 35 T. 4 R. 16 E.

Description- Parcel "A": A 0.23 acre parcel in the NW fractional 1/4 of Section 35, T. 4 N., R. 16 E., Walworth County, Wisconsin described as follows: Beginning at an iron pipe set at the N. 1/16 section corner on the N. line of said NW 1/4; thence S 0° - 26' E. along the 1/16 section line 393.97 feet to an iron pipe stake found; thence N 89° - 14' E. 25.00 feet parallel to the N. line of said section to a concrete monument found; thence N 0° - 26' W. 393.97 feet to a concrete monument found on the N. line of said section; thence S 89° - 14' W. 25.00 feet to the point of beginning.

Parcel "B": A 0.1 acre parcel in the SW 1/4 of Section 26, T. 4 N., R. 16 E. being that part of the following which lies South of the public road: Beginning at an iron pipe set at the N. 1/16 section corner on the S. line of the SW 1/4 of said section (being the N.W. corner of parcel "A" above); thence N 0° - 26' W. to a point in the lake located 250 feet North of the point of beginning; thence N 89° - 14' E. 275 feet to a point; thence S 0° - 26' E. 250 feet to the section line; thence S 89° - 14' W. 275 feet to the point of beginning.

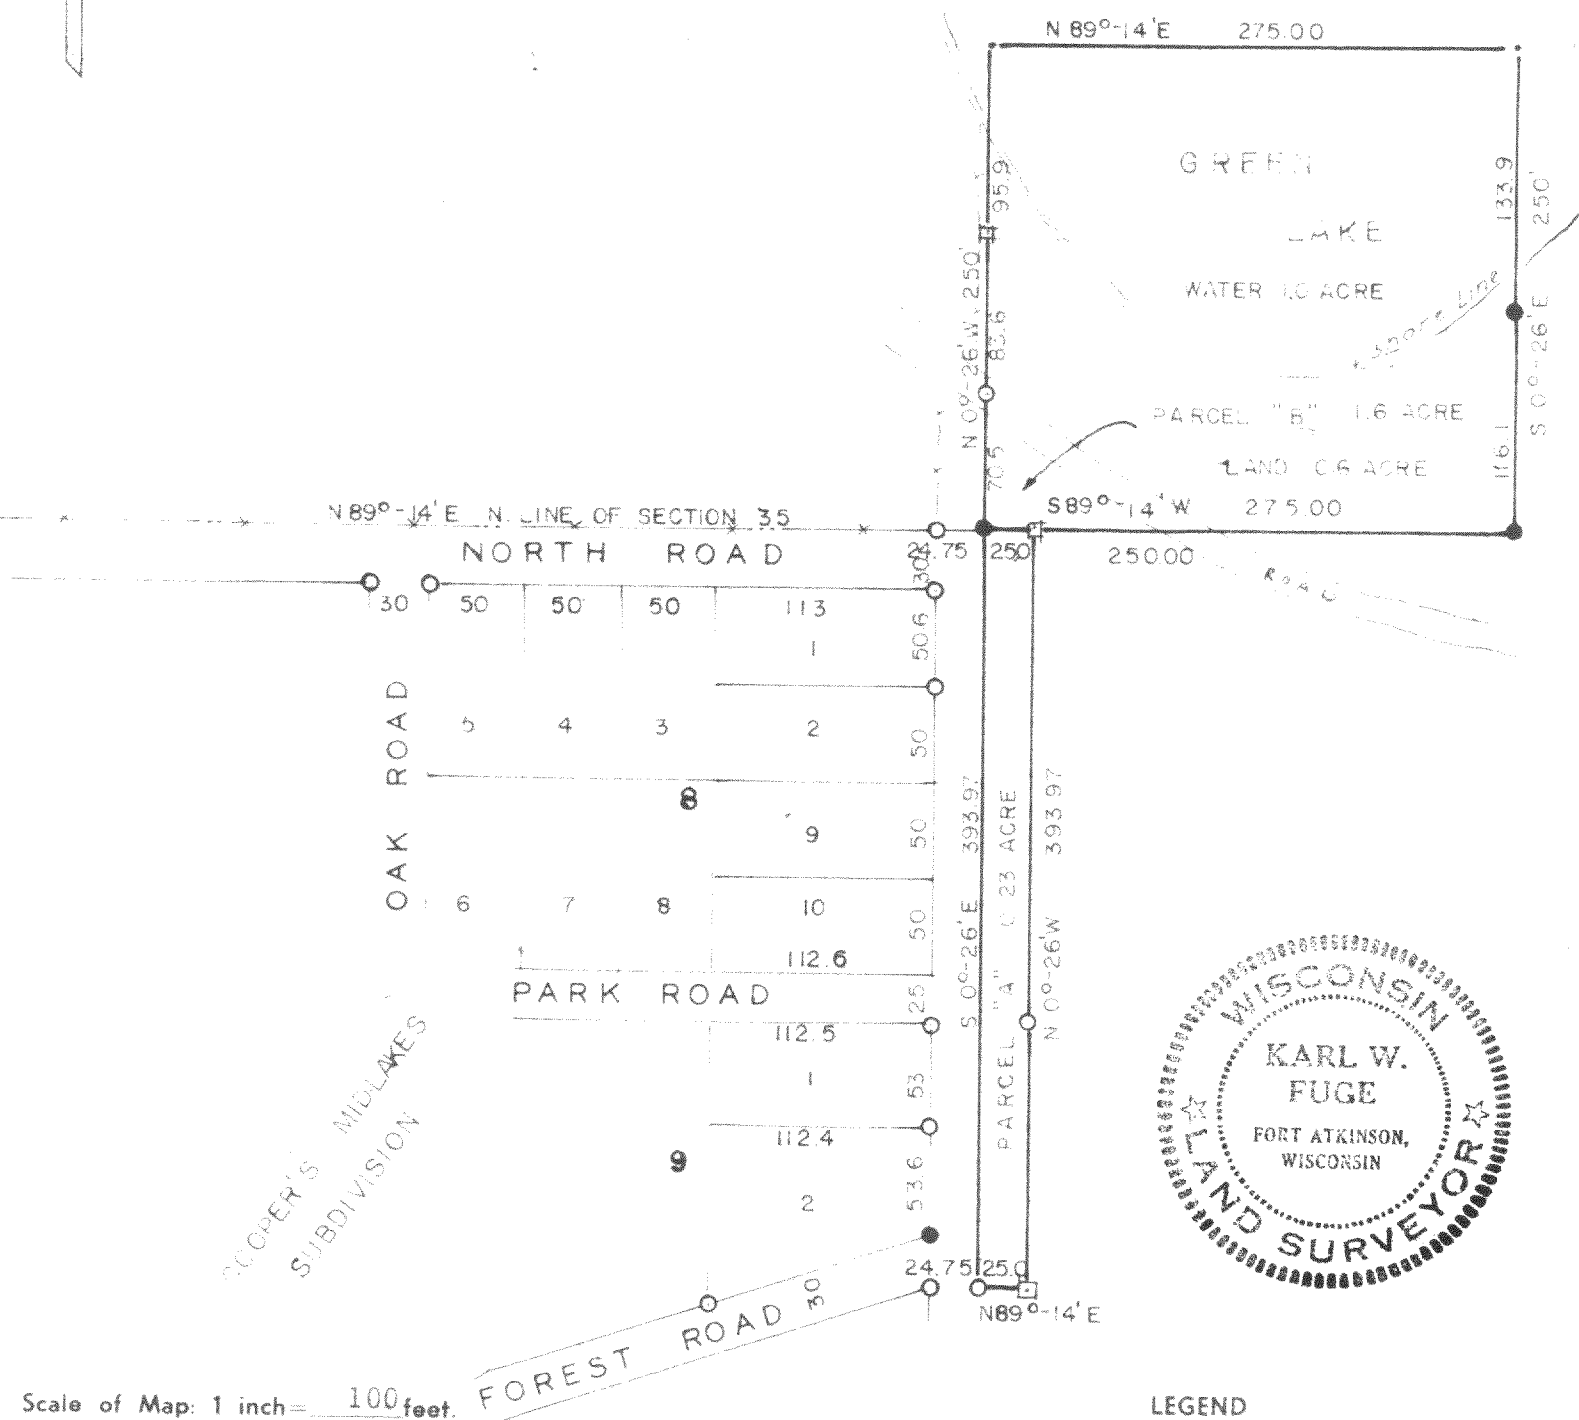

Scale of Map: 1 inch = 100 feet.

STATE OF WISCONSIN }
COUNTY OF JEFFERSON } SS.

LEGEND

- Iron Pipes Found
- Iron Pipes Set
- Reference Points
- X-X-X-X- Fences
- ⊕ T-Bar Stake Set
- ⊕ CONC. MONUMENT

I, Karl W. Fuge, a registered surveyor of the State of Wisconsin, do hereby certify that on 7-8-59 I surveyed the above described property according to official records and that the accompanying map is a correctly dimensioned representation to the scale of the boundaries, that all buildings and improvements lie wholly within the boundary lines, and that no encroachments by adjacent property owners appear from said survey.

Cooper's Midlakes Subdivision
LAG-35-1B

MEMBER
WISCONSIN SOCIETY OF LAND SURVEYORS

Karl W. Fuge
SIGNATURE

Field Book XXII Page 5295

AMERICAN CONGRESS OF SURVEYING AND MAPPING

Map No. 843