

PREPARED FOR:



MR. GAMBINO
417 DOUGLAS AV
MT. PROSPECT, IL. 60056

PLAT OF SURVEY

-OF-

J.K. SURVEYING INC.
N3705 WILLOWBEND LANE
LAKE GENEVA, WI, 53147
262-248-3697

LOT 20 GLADHURST, A SUBDIVISION LOCATED IN THE SE 1/4 OF SECTION 23,
SW 1/4 OF SECTION 24, NW 1/4 OF SECTION 25, AND THE NE 1/4 OF SECTION 26,
TOWN 4 NORTH, RANGE 16 EAST, WALWORTH COUNTY, WISCONSIN.

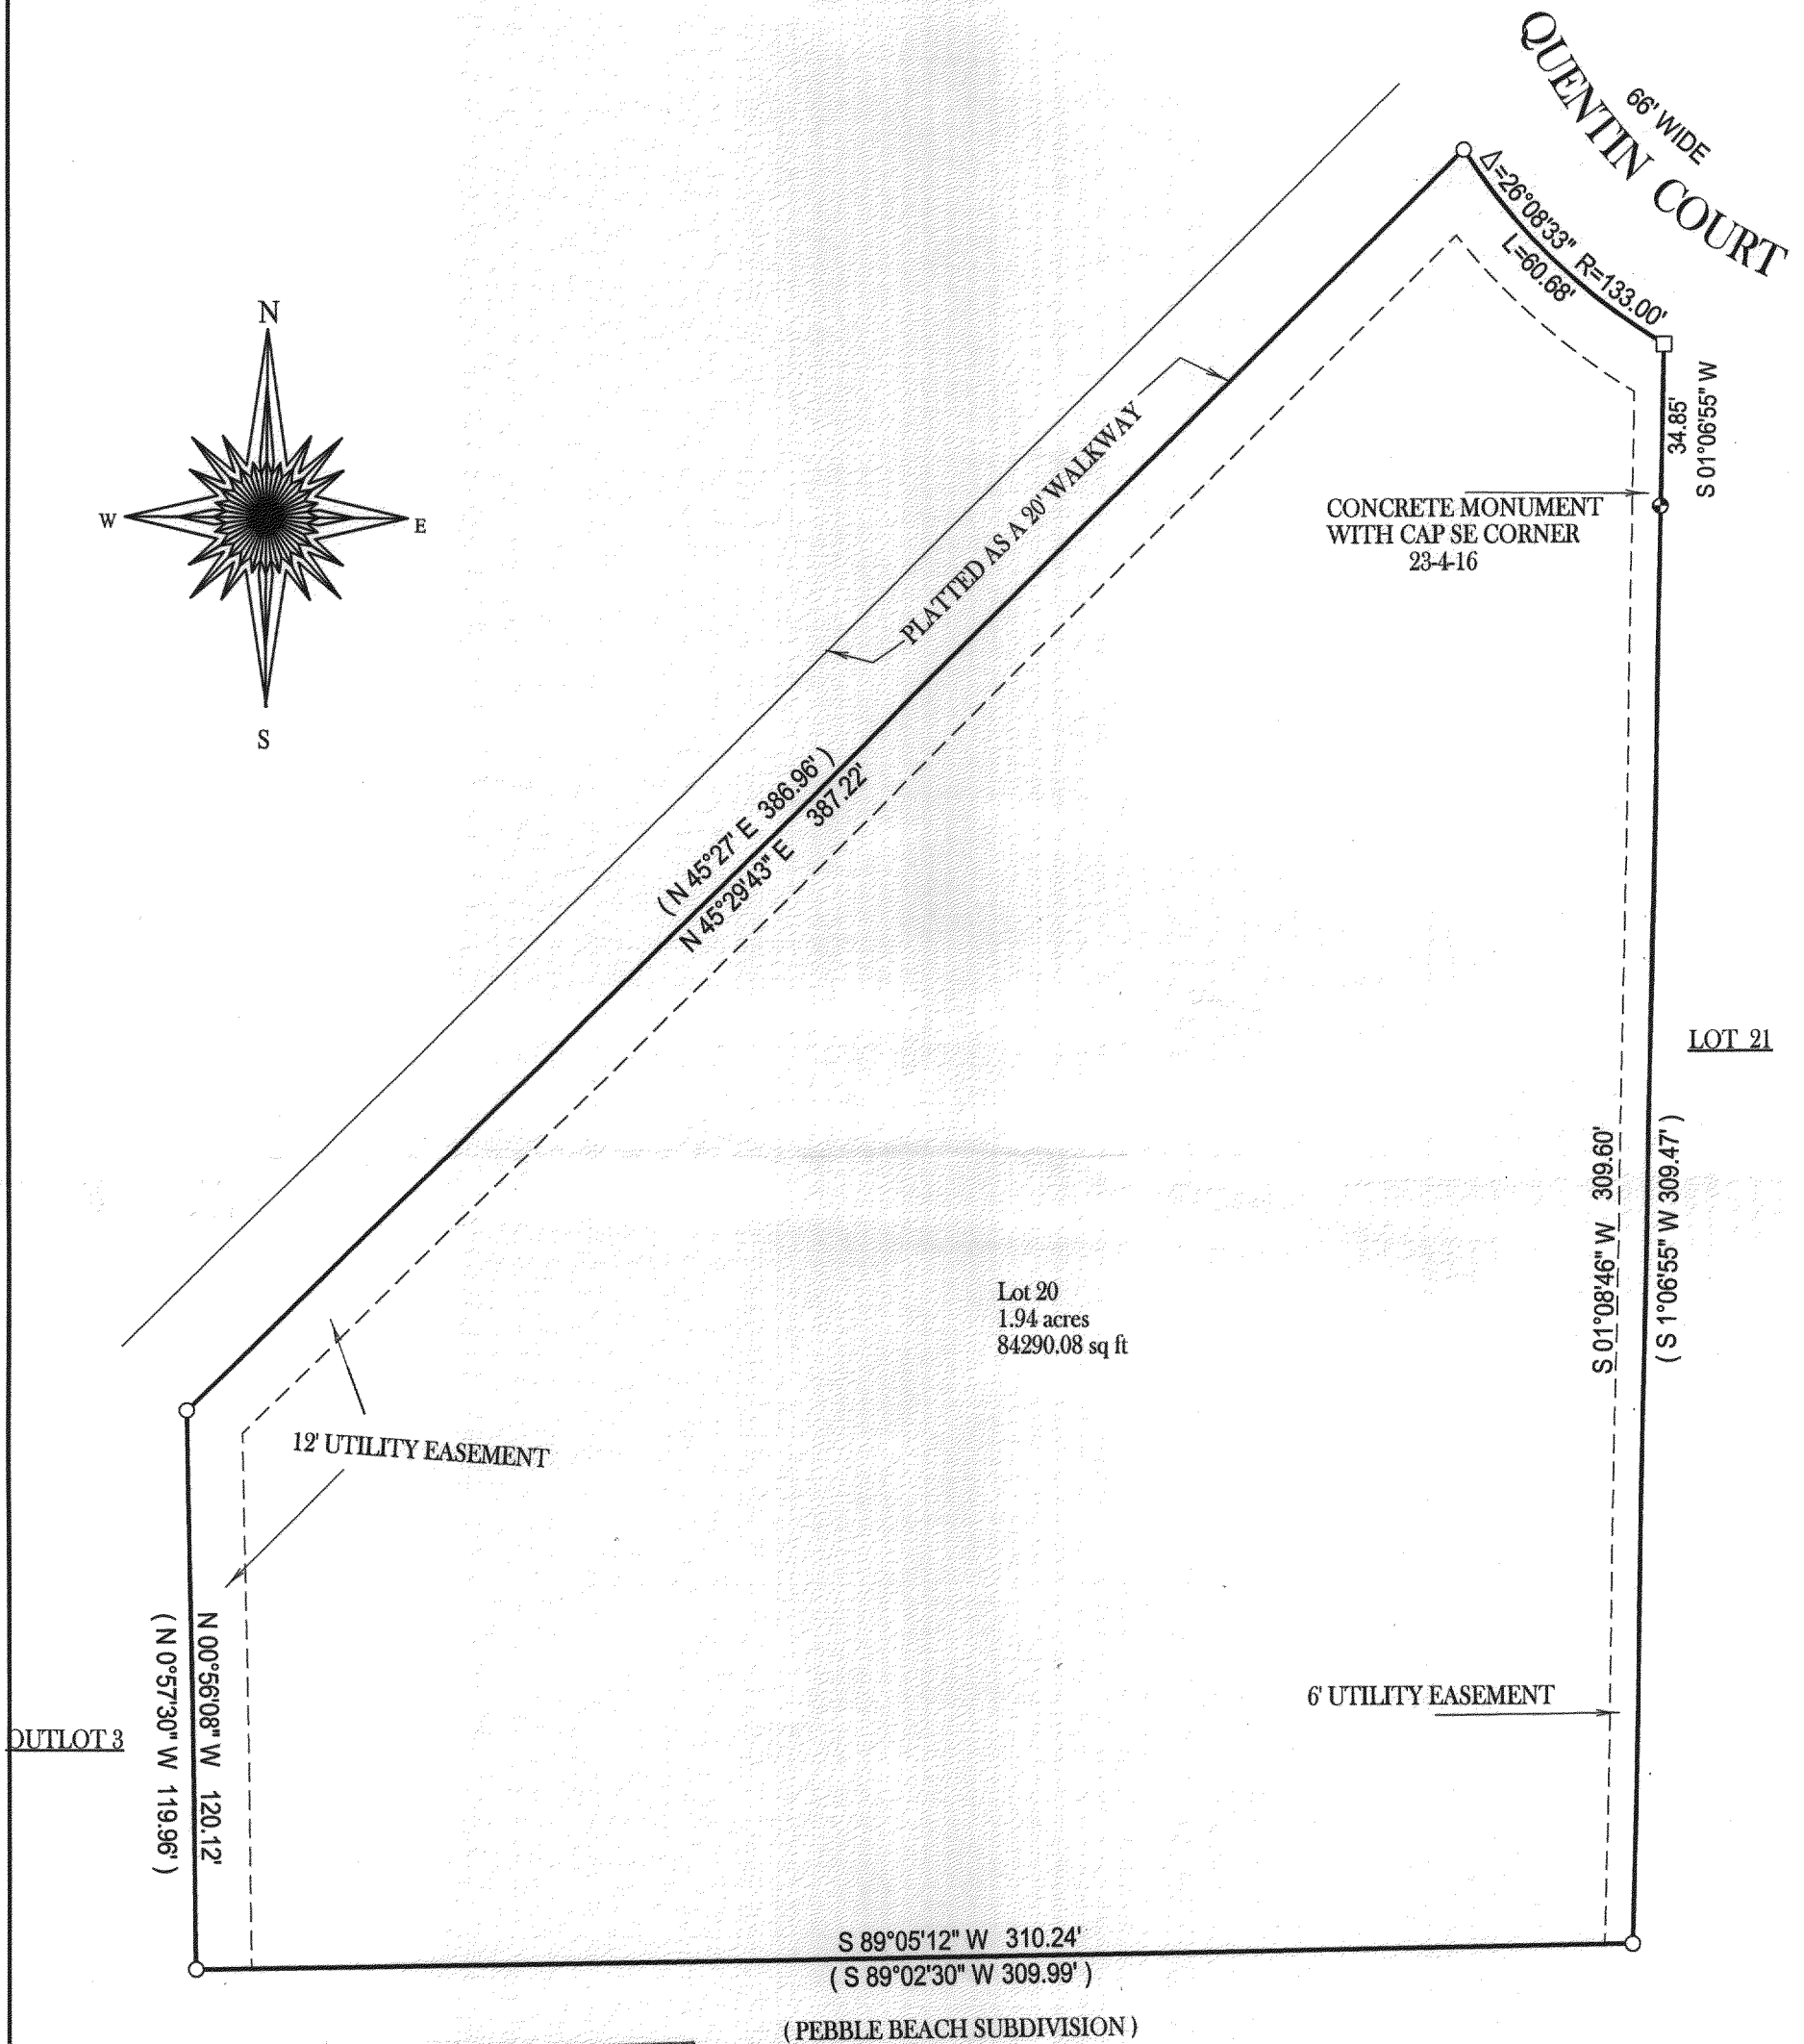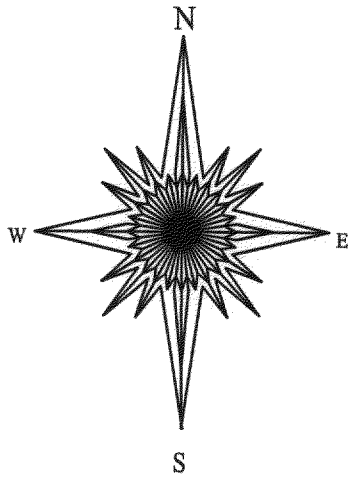


Lot 20
1.94 acres
84290.08 sq ft

12' UTILITY EASEMENT

6' UTILITY EASEMENT

(PEBBLE BEACH SUBDIVISION)

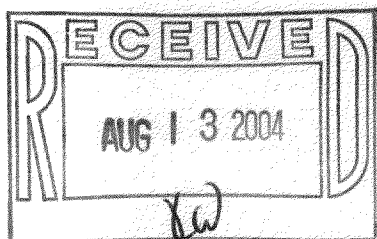

() = RECORDED AS

□ = FOUND IRON BAR

○ = FOUND IRON PIPE

● = SET IRON PIPE

■ = SET IRON BAR

SCALE: 1" =

JOB #:

TAX ID #: HG 00020

COMPARE LEGAL DESCRIPTION ABOVE AND DRAWING WITH DEED. FOR BUILDING RESTRICTIONS AND EASEMENTS NOT SHOWN, REFER TO DEED, ABSTRACT SOURCES AND LOCAL MUNICIPAL CODES. NOTIFY THE SURVEYOR IMMEDIATELY OF ANY DISCREPANCY.

"I hereby certify that the above described property was surveyed under my supervision and that the above map, to the best of my knowledge and belief, is a true representation thereof and shows the size and location of all visible structures, apparent easements and encroachments if any."
This survey is made for the present owners of the property, and those who purchase, mortgage, or guarantee the title thereto, within one year from the date hereof.



Jeffery L. Kimps
JEFFERY L. KIMPS S-2436
Wisconsin Registered Land Surveyor
(original if signed in red)

DATED THE 15TH, DAY OF April 2004.

416-2021