

Tax Parcel  
HLG 3100003B

F a r m  
F i e l d

Tax Parcel  
HLG 3100003B

F a r m  
F i e l d


Tax Parcel  
HLG 3100003B

Tax Parcel  
HLG 3100002

East 405.00'  
372.00'

North 537.78'

Lot 1  
5.000 Acres  
217,801 Sq. Ft.  
4.593 Acres  
200,054 Sq. Ft.  
Exclusive of R.O.W.

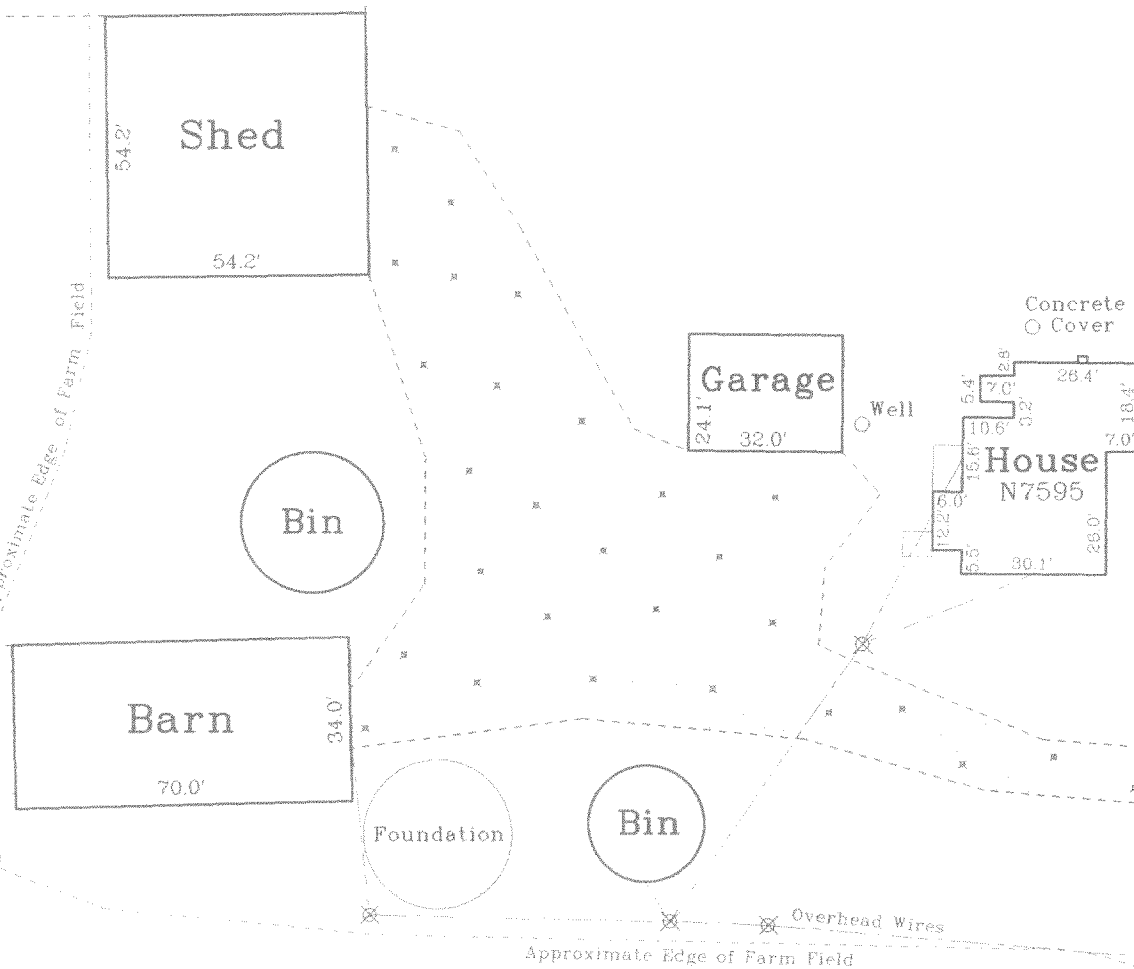

Northeast Corner  
Section 31-4-16.



(61 Posts or 10065)

East 1/4 Corner  
Section 31-4-16.

# Plat of Survey

of  
Lot 1 of Certified Survey Map No. 2406,  
recorded in Vol. 12 of Certified Survey Maps of Walworth County  
on Page 33 and located in the Northeast 1/4 of Section 31, Town  
4 North, Range 16 East, Town of LaGrange, Walworth County, Wisconsin.

Surveyed for: **Elk Realty**  
N5488 Newman Drive  
Elkhorn, Wisconsin 53121

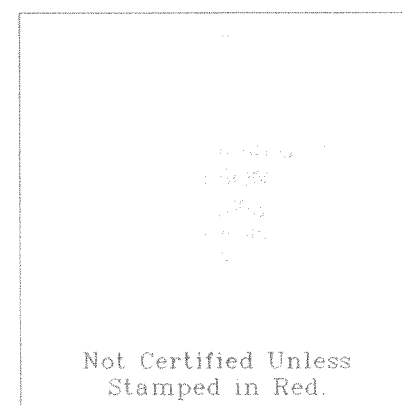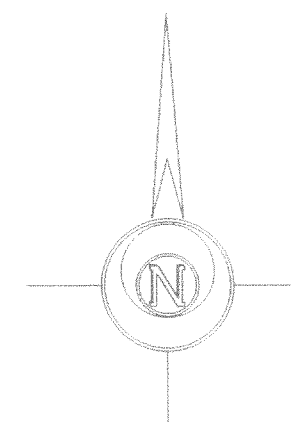

- Notes: 1) This survey plat is not certified unless signed and sealed in red ink.  
2) This survey is subject to Wisconsin lien laws. This Plat of Survey is the notice of intent to file lien. Lien waiver required.

Copyright © 2004 by Jensen & Olson Land Surveying, LLC.

All rights reserved. No part of this survey plat may be reproduced or transmitted in any form by any means - graphic, electronic, or mechanical, including photocopying, tracing, or information storage and retrieval systems - without permission in writing from Douglas G. Olson, Jensen & Olson Land Surveying, LLC.

I hereby certify that I have surveyed the above described property and the map hereon is correct to the best of my professional knowledge and belief and shows the size and location of the property, its exterior boundaries, the location and dimensions of all visible structures thereon, boundary fences, apparent easements and roadways and visible encroachments, if any.  
This survey is made for the exclusive use of the present owners of property, and also those who purchase, mortgage or guarantee title thereto, within one year from the date hereof.

Douglas G. Olson  
Wisconsin Registered Land Surveyor - 2093

Survey Date: Sept. 23, 2004  
Revisions:



**Jensen & Olson Land Surveying, LLC**  
45 South Wisconsin Street P.O. Box 322  
Elkhorn, Wisconsin 53121  
Telephone (262) 723-3434  
Facsimile (262) 723-8044

**Legend**  
Found County Section Corner  
Found Iron Rod 3/4" dia.  
Set and Iron Rod 3/4" dia.  
Recorded Information  
Utility Pole  
Pedestal  
Asphalt Surface  
Concrete Surface  
Gravel

Sheet 1 of 1 Sheets  
Job Reference Number  
**2004.156**

2004.156

HA240600001

416-2035