


GEORGE T. DUNHAM
SURVEYING & SUBDIVIDING
DELAVER, WISCONSIN

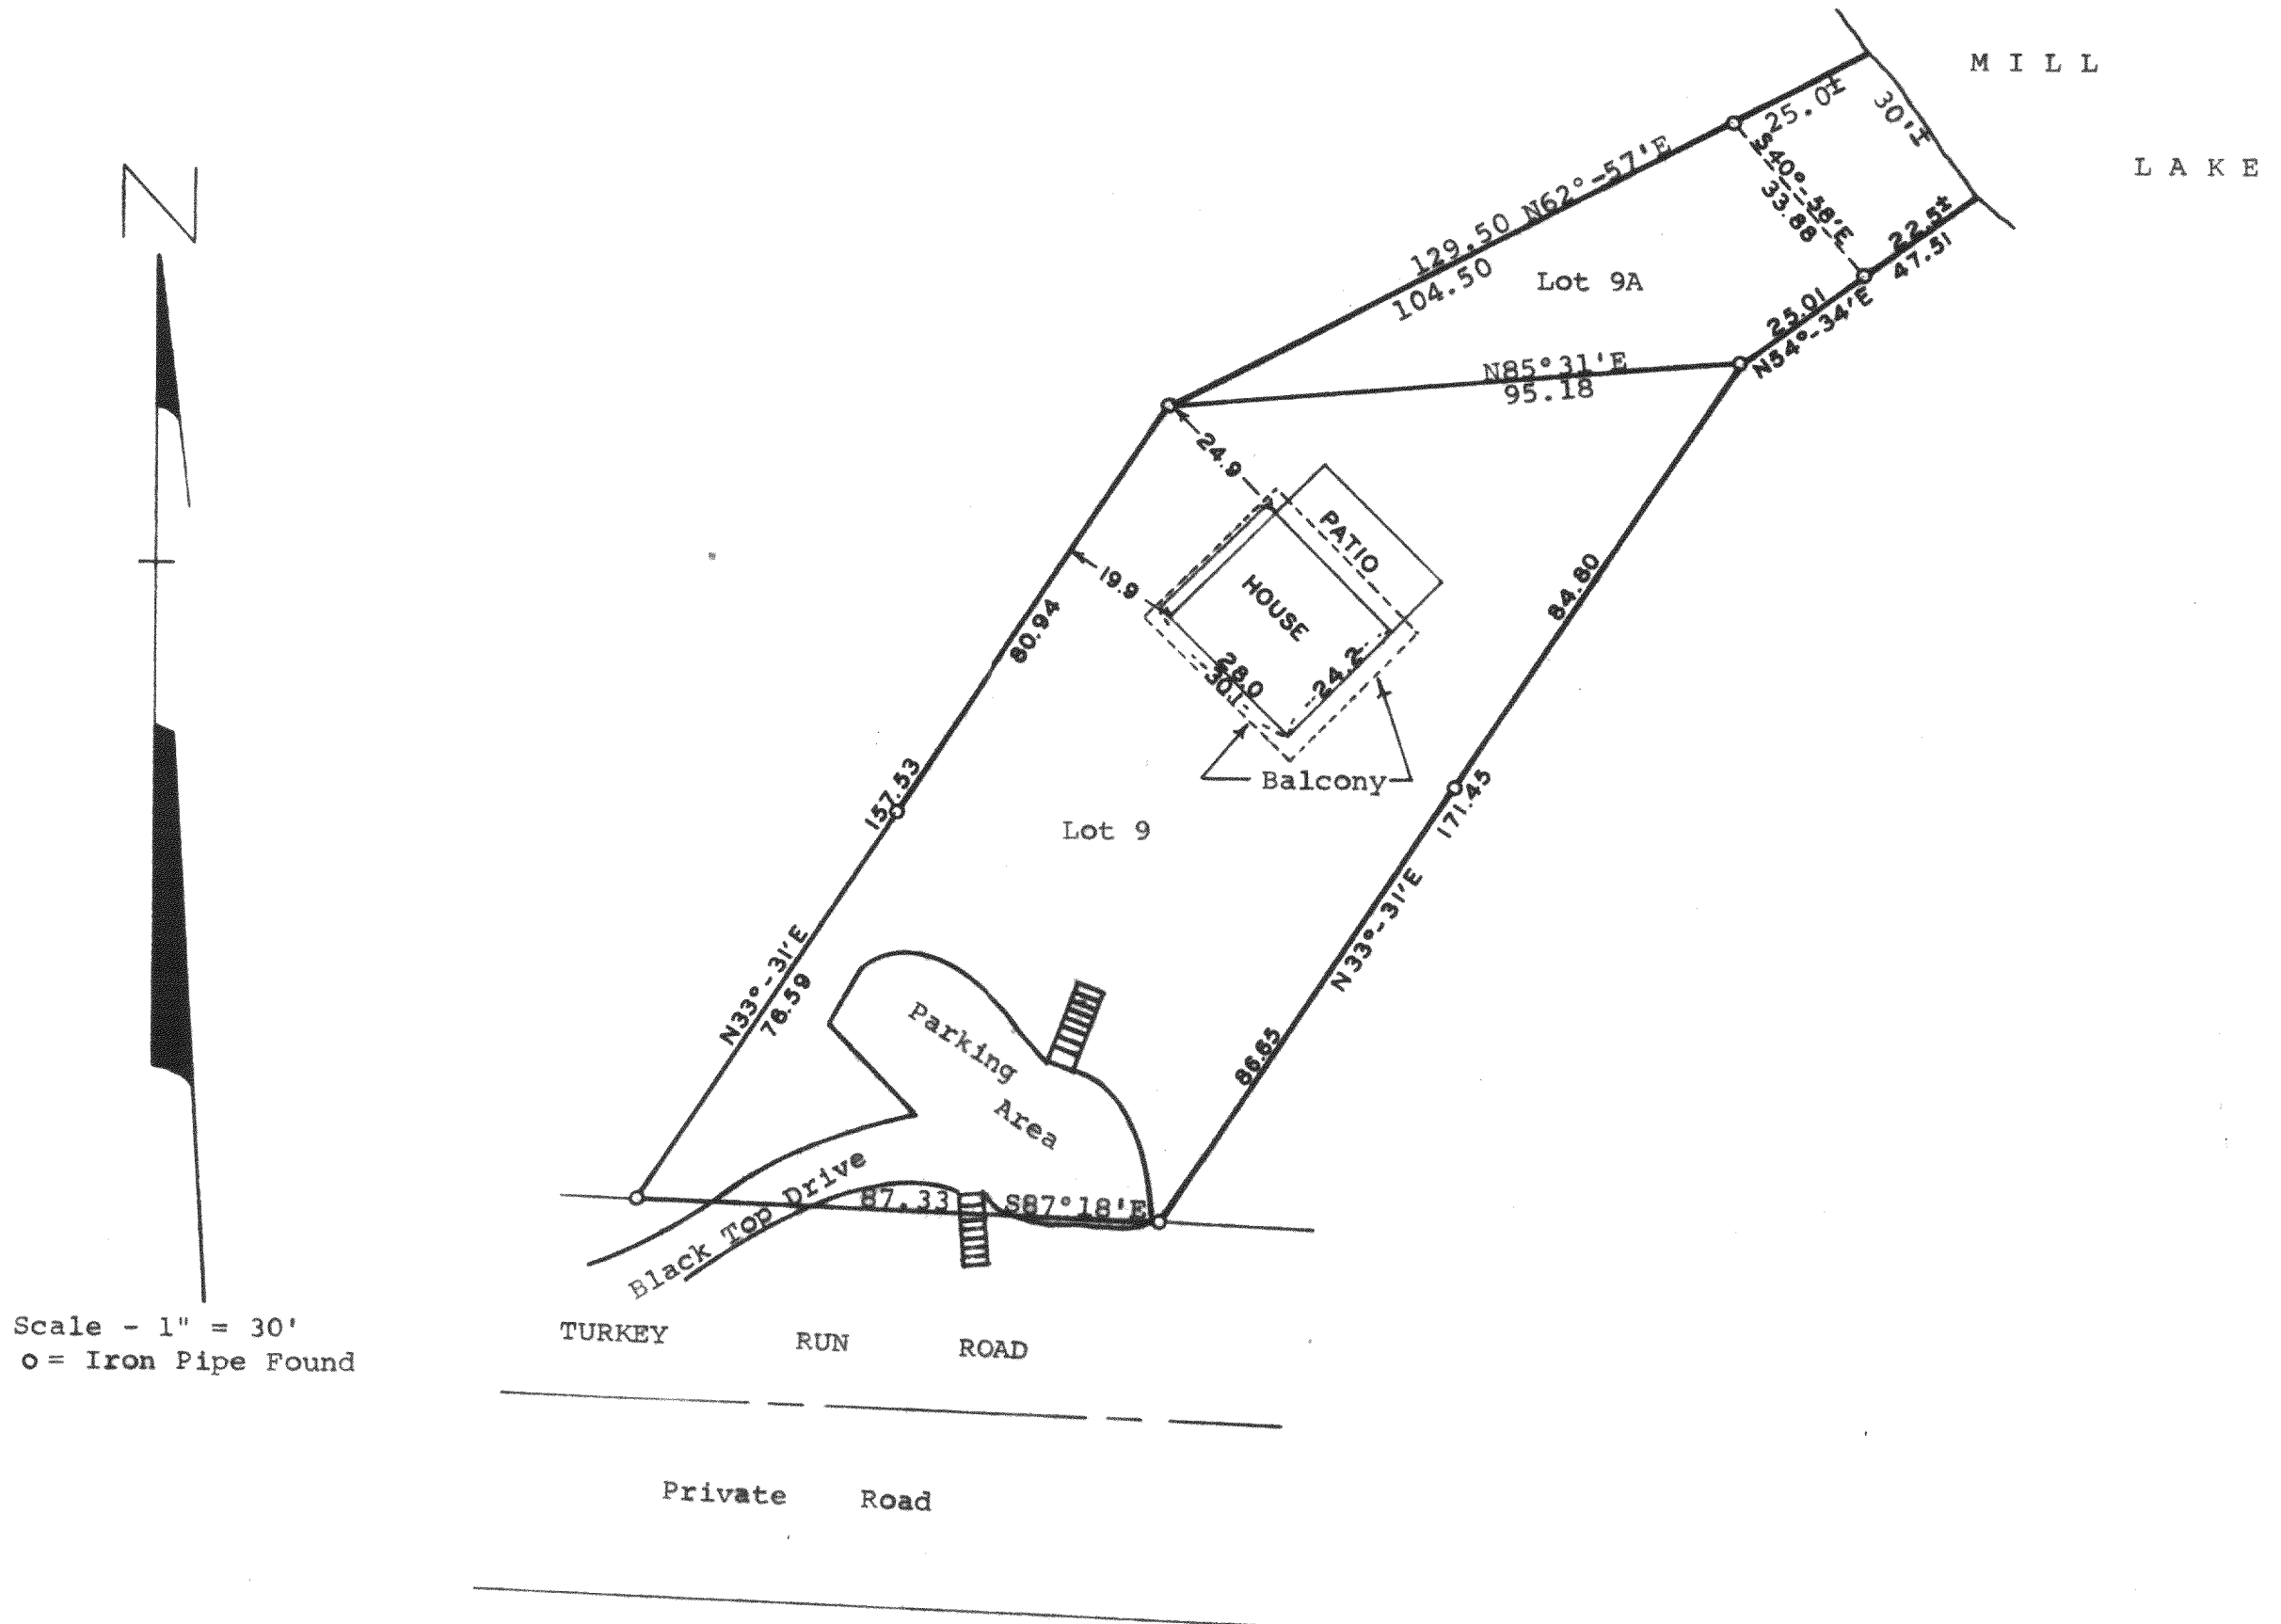

STATE OF WISCONSIN)
COUNTY OF WALWORTH) ss


I, George T. Dunham, Surveyor, certify that I have surveyed the property described as follows,

Lots 9 and 9A of Arrowhead Park, a subdivision located in Government Lot 3 in the Northwest 1/4 of the Southeast 1/4 of Section 35, T 4 N, R 16 E, Walworth County, Wisconsin, and the above map is a true representation thereof and shows the size and location of the property, its exterior boundaries, the location and dimensions of all structures thereon, fences, apparent easements and roadways and visible encroachments, if any.

This survey is made for the exclusive use of the present owners of the property, and also those who purchase, mortgage, or guarantee the title thereto within one (1) year from date hereof; and as to them I warrant the accuracy of said survey and map.

July 15, 1975

George T. Dunham
George T. Dunham, Surveyor

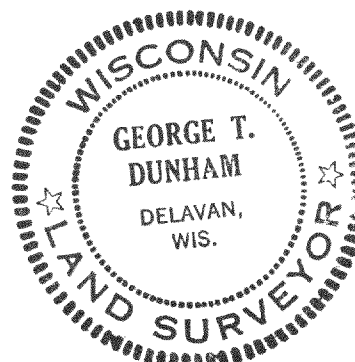

HAP-13 and 14