



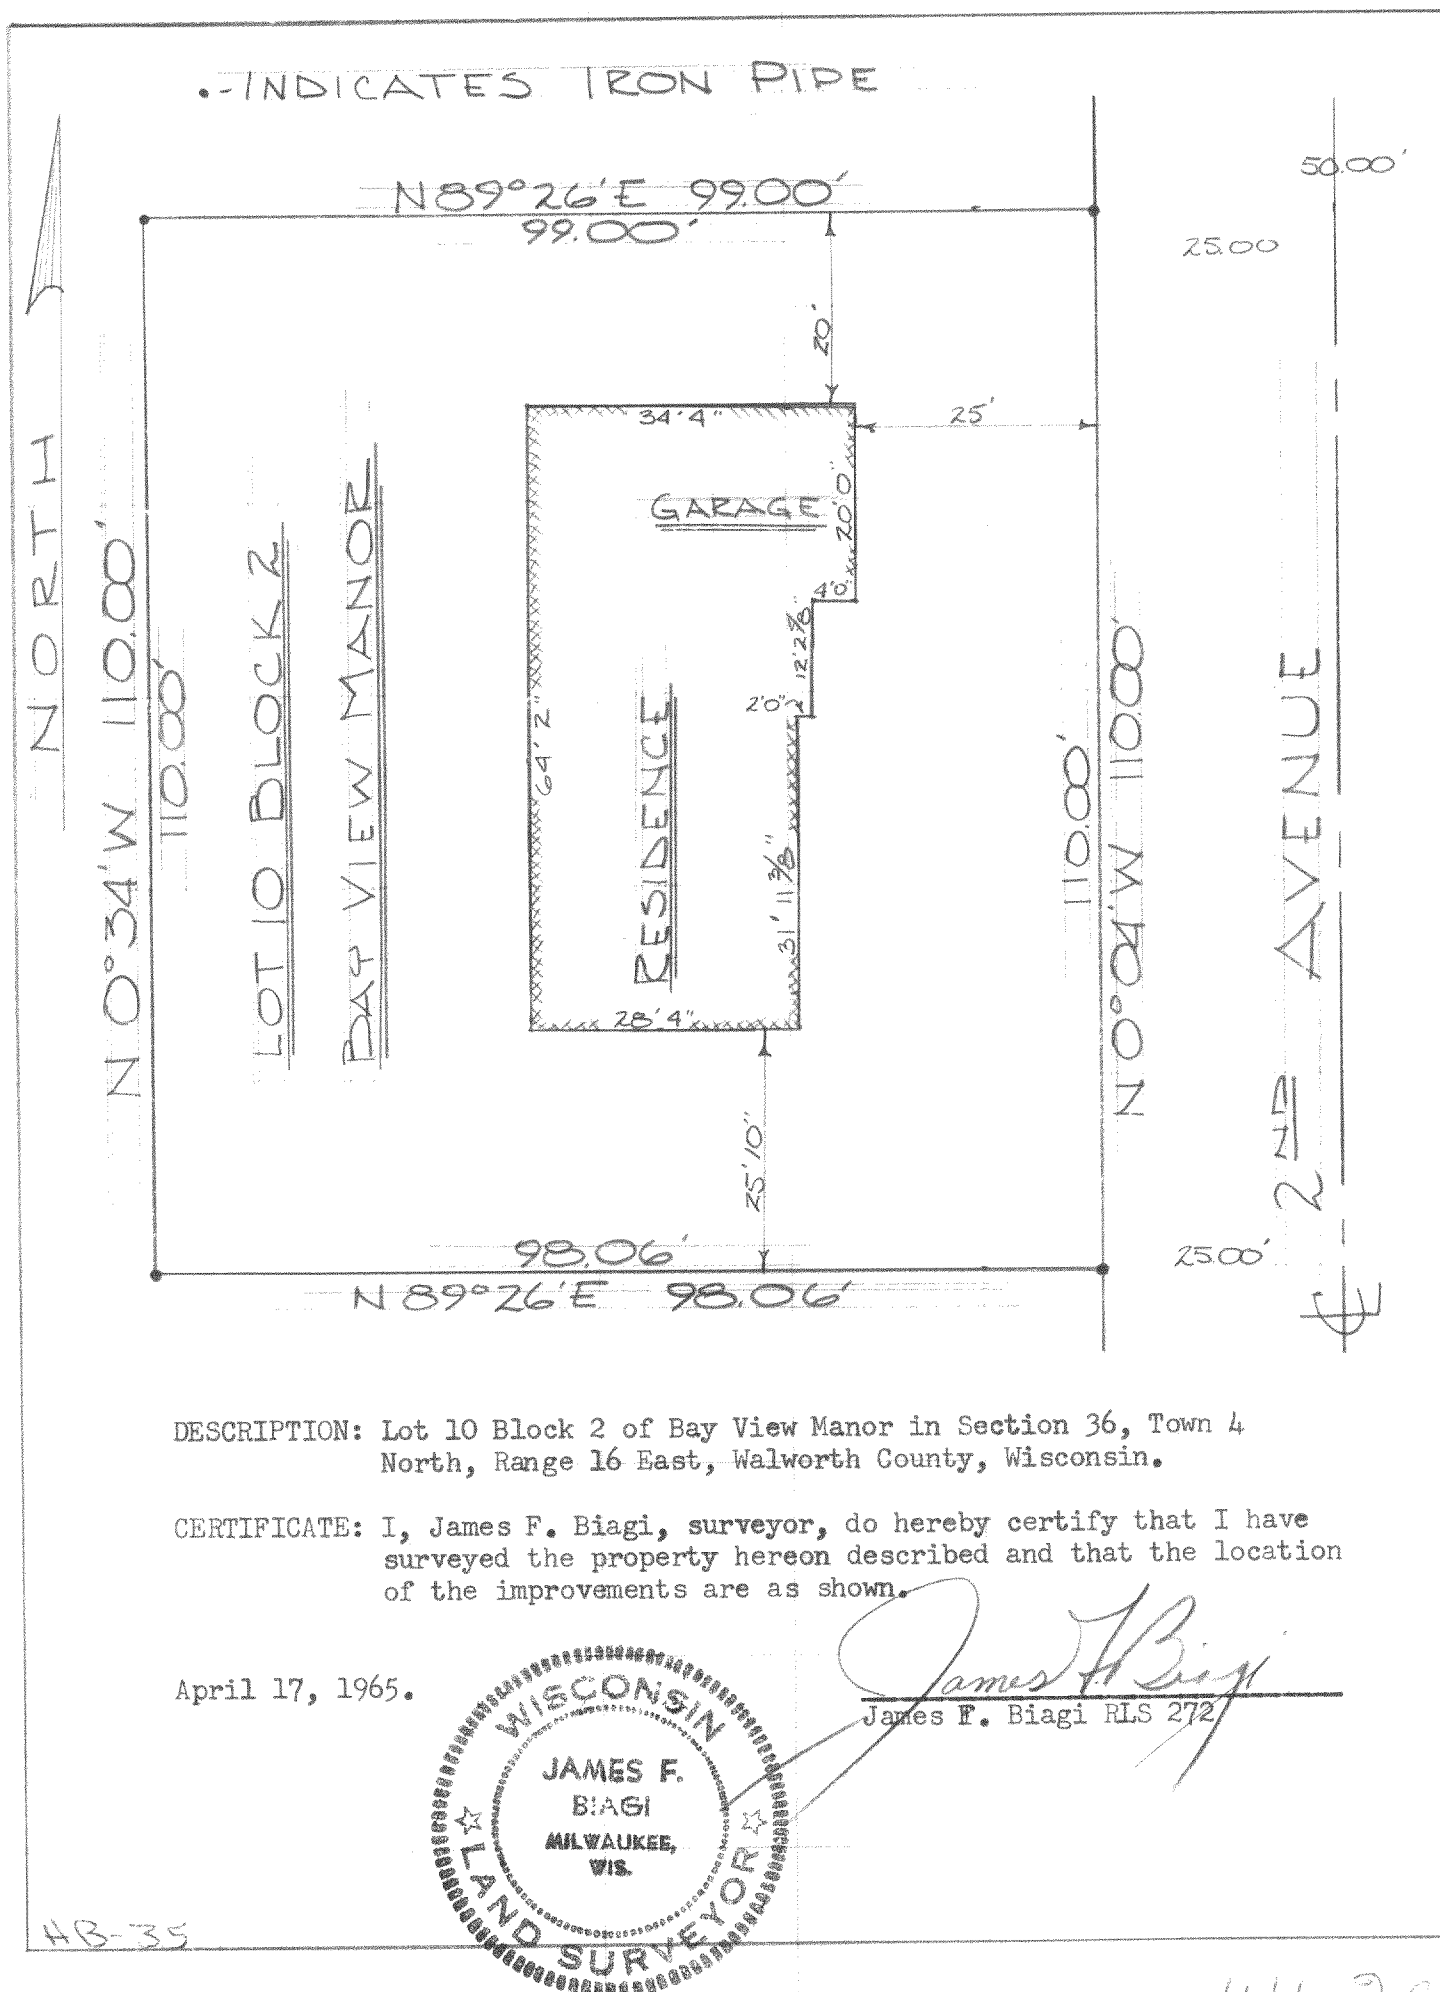

DESCRIPTION: Lot 10 Block 2 of Bay View Manor in Section 36, Town 4 North, Range 16 East, Walworth County, Wisconsin.

CERTIFICATE: I, James F. Biagi, surveyor, do hereby certify that I have surveyed the property hereon described and that the location of the improvements are as shown.

April 17, 1965.

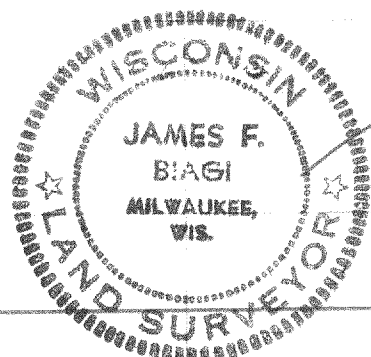

James F. Biagi RLS 272