

PLAT OF SURVEY

LOCATION: Wooded Court, LaGrange, Wisconsin

LEGAL DESCRIPTION: Lot 13 of THE WOODLANDS OF KETTLE MORaine, in the Town of Walworth County, Wisconsin, being a part of the SE 1/4 of the SW 1/4 of NE 1/4 of the NW 1/4 of Section 11, the NW 1/4 of the NE 1/4 of SW 1/4 of the NW 1/4 of Section 11, all in Town 4 North,


LaGrange, Section 2, the Section 11, the Range 16 East.

March 15, 2005

Survey No. 98351

Detail Scale

1" = 30'

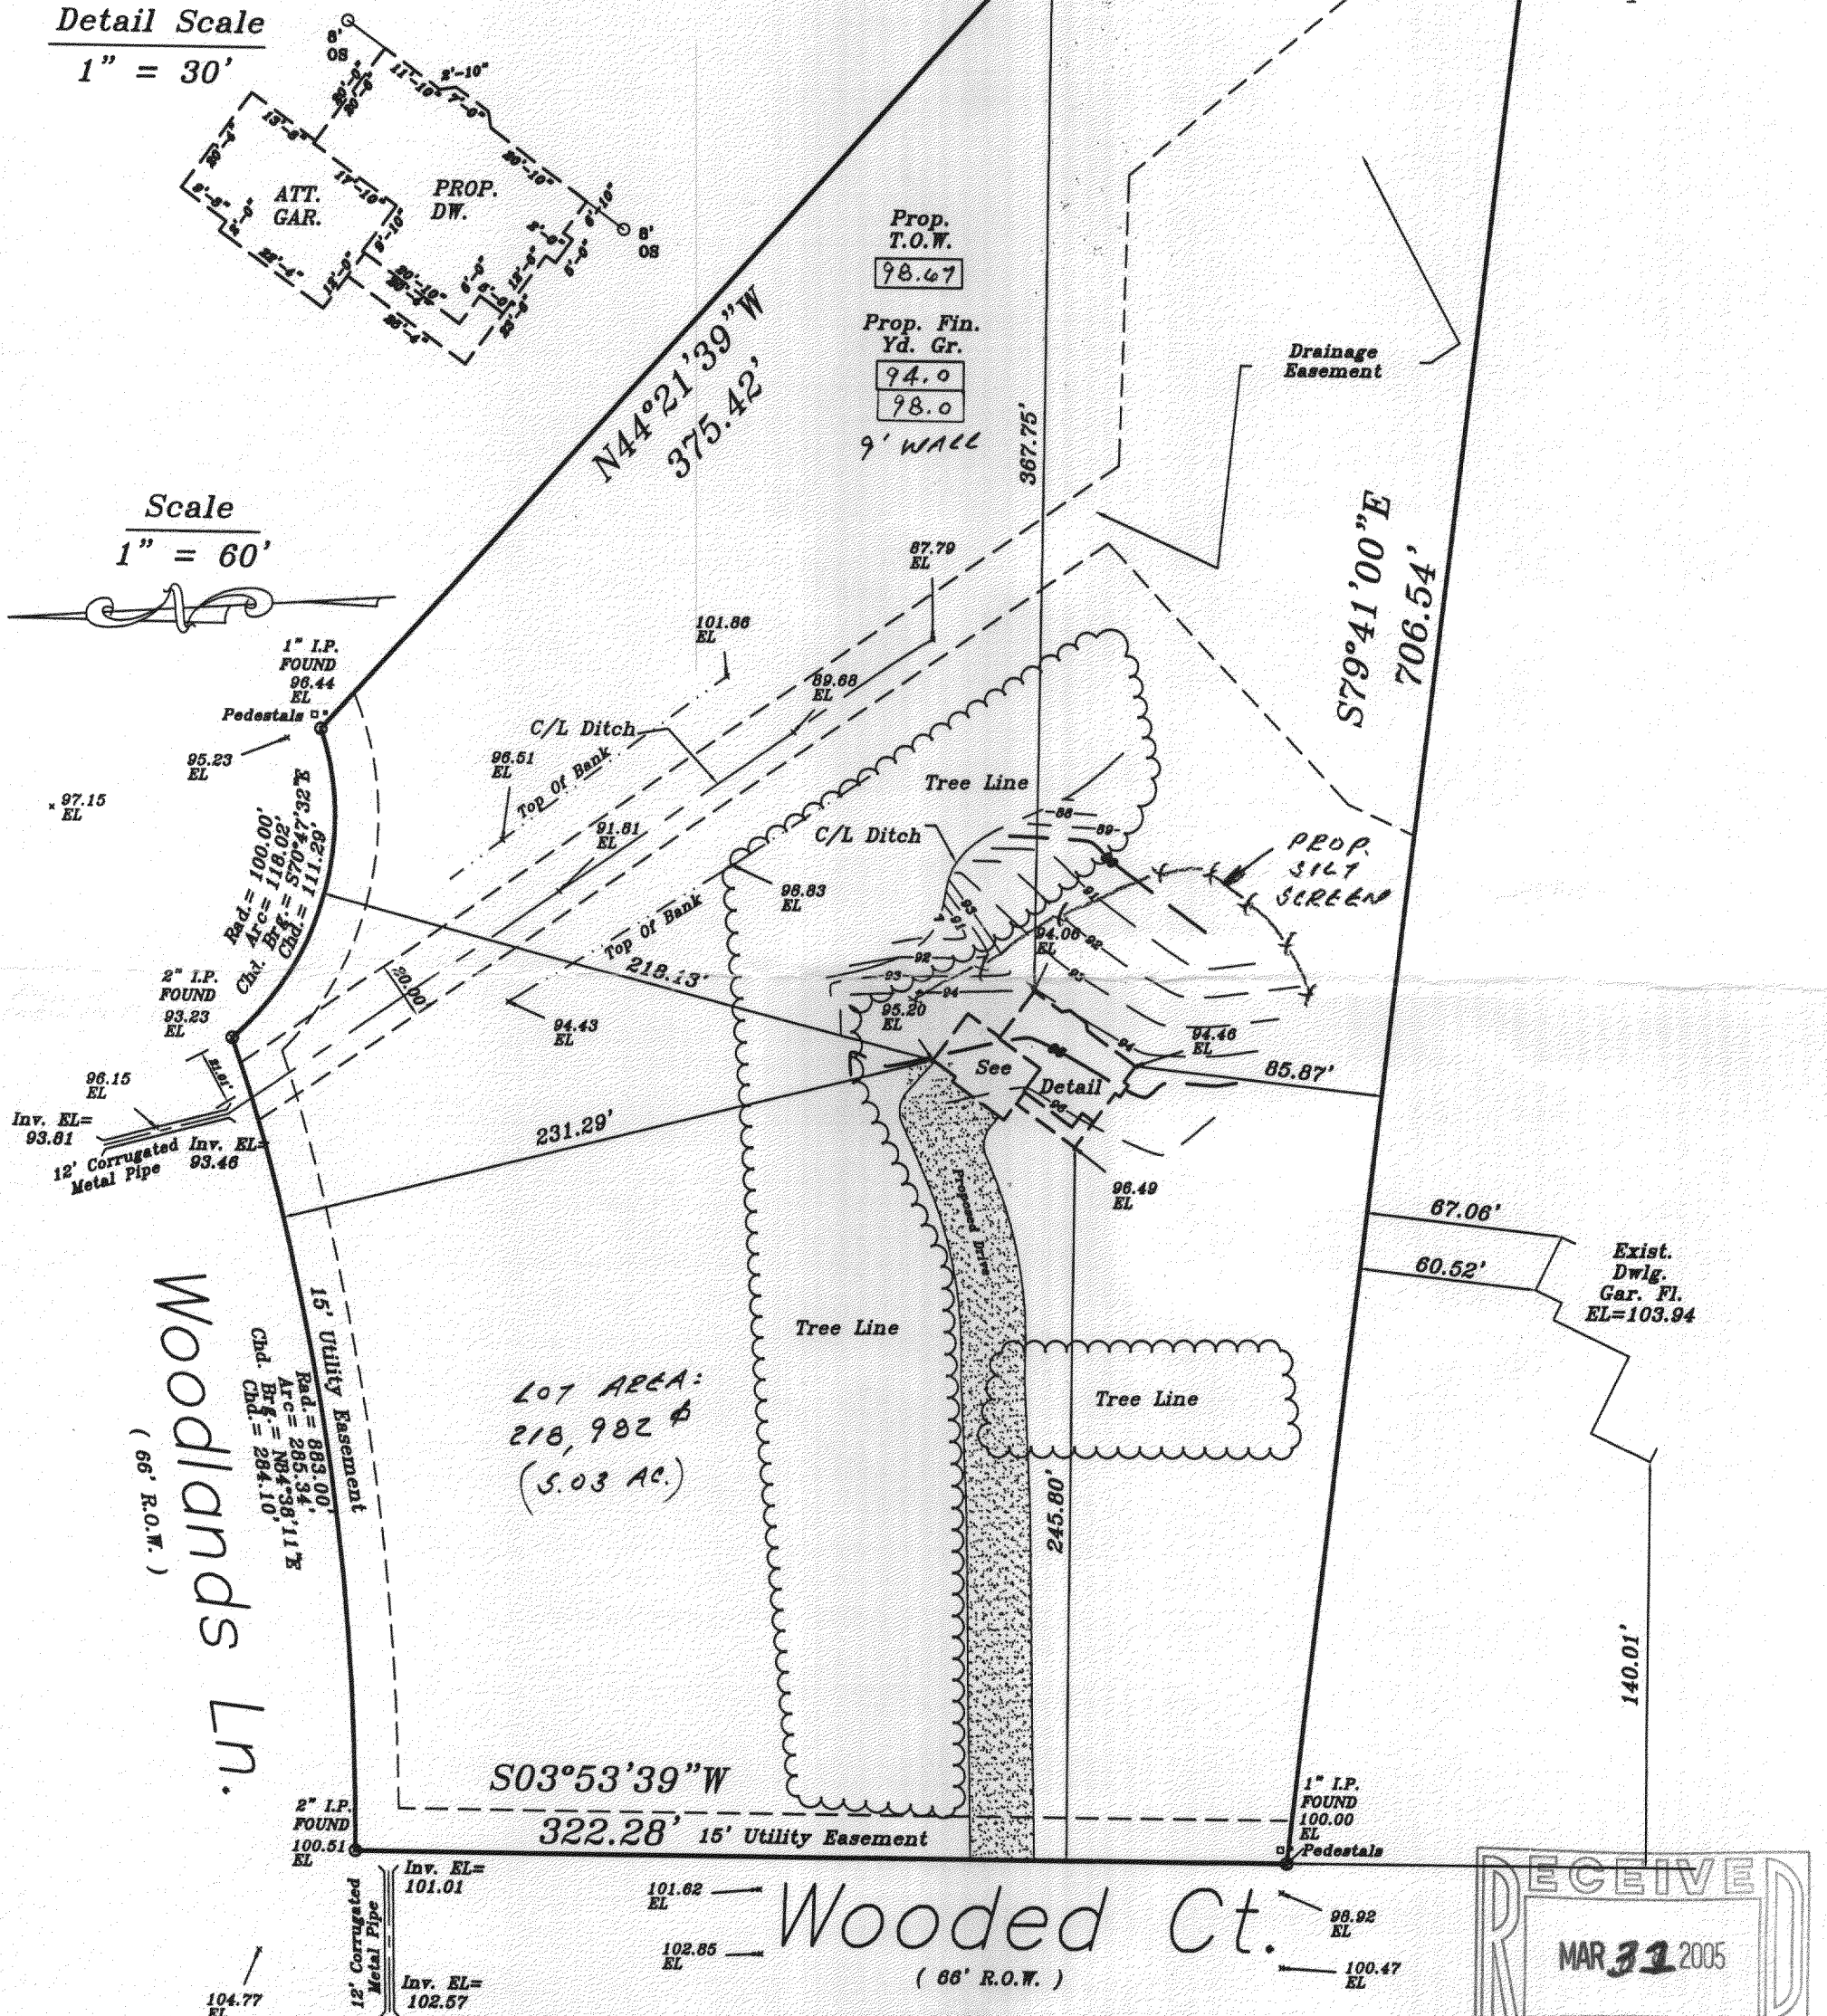

METROPOLITAN SURVEY SERVICE, INC.


REGISTERED LAND SURVEYORS AND CIVIL ENGINEERS

5200 W. LOOMIS ROAD GREENDALE, WI 53129

PH. (414) 529-5380

FAX (414) 529-9787

email address survey@bizwi.rr.com

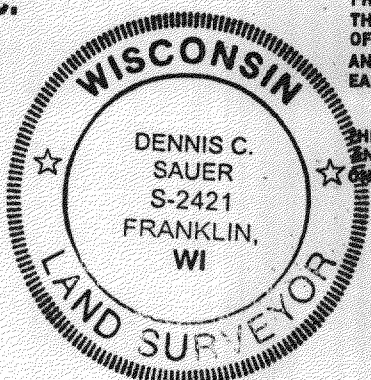

I HEREBY CERTIFY THAT I HAVE SURVEYED THE ABOVE DESCRIBED PROPERTY AND THAT THE ABOVE MAP IS A TRUE REPRESENTATION THEREOF AND SHOWS THE SIZE AND LOCATION OF THE PROPERTY, ITS EXTERIOR BOUNDARIES, THE LOCATION OF ALL VISIBLE STRUCTURES AND DIMENSIONS OF ALL PRINCIPAL BUILDINGS THEREON, BOUNDARY FENCES, APPARENT EASEMENTS AND ROADWAYS AND VISIBLE ENCROACHMENT, IF ANY.

THIS SURVEY IS MADE FOR THE EXCLUSIVE USE OF THE PRESENT OWNERS OF THE PROPERTY, AND ALSO THOSE WHO PURCHASE, MORTGAGE, OR GUARANTEE THE TITLE THERETO WITHIN THE (1) YEAR FROM THE DATE HEREOF.

SIGNED

Dennis C. Sauer
Dennis C. Sauer
Registered Land Surveyor S-2421

HWG 00013

416-2080